


N^o 208

MIDSHIP SECTION

DIMENSIONS:- 105'0" x 20'9" x 11'0" HOLD

CLASS 100 A1

SCALE $\frac{1}{2}$ " = ONE FOOT

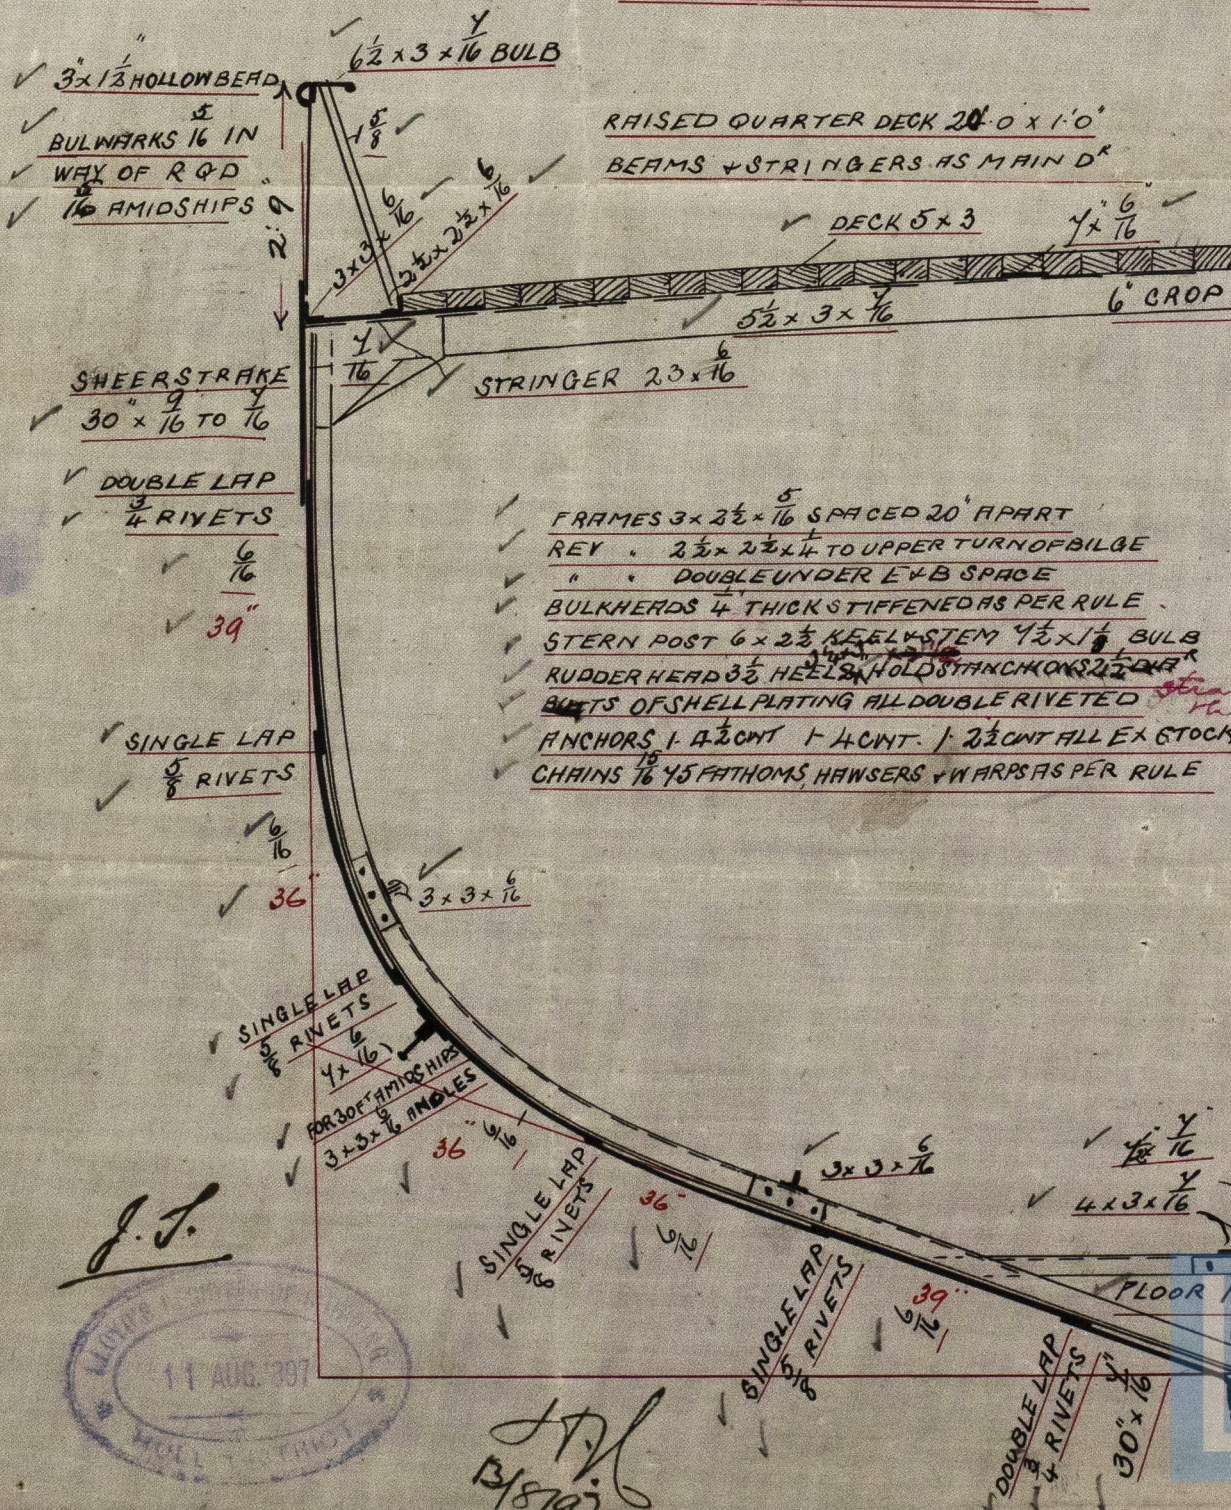

LLOYDS N^{os}

$\frac{1}{2}$ GIRTH 18'0"

$\frac{1}{2}$ BREADTH 10'33"

DEPTH 12'33"

40'66 1st N^o


104

4228 64 PLATING N^o

$\frac{L}{D} = 8.54$

$\frac{L}{B} = 5$

Straps of one strake at bulge to be 1/16 thicker than regular for 1/2 length under 160 tons G.D.R.

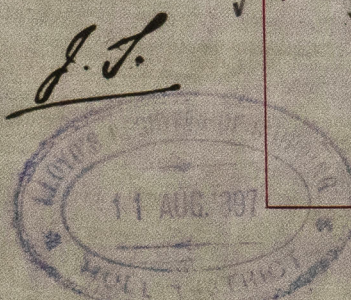

J.F.L.
13/8/97

HUL416-0090