

Received at



189

## Lloyd's Register of British and Foreign Shipping.

s/s *Powby Castle*(Report on Vessel No. *11909*)

Port

*Hull*No. *3987*

## SHIP FORGINGS OR CASTINGS.

I have to report that the undermentioned Iron or Steel Forgings or Castings,  
 manufactured by *Messrs J March & Co*  
 of *Dunston* for the Vessel No. *208*, being built  
 by *Messrs Cook Nelson & Co* of *Hull*  
 have been inspected by me as set forth below, and found to be, so far as can be seen,  
*sound*

Mark on Forgings.


Lloyd's

No. *7159B**96*

*John B Craig*  
*Newcastle*

	STERN FRAME.	RUDDER FRAME.	STEM.
Material* ...	<i>Scrap</i>	<i>Scrap</i>	
How made ...	<i>Forged</i>	<i>Forged</i>	
Dimensions ...	<i>6 - 2 1/2</i>	<i>3 1/2 to 3 1/4 + 3</i>	
Progress on Inspection	<i>Forged &amp; Smithed</i>	<i>Forged &amp; Smithed</i>	
Date when Inspected	<i>August 6 &amp; 31/27</i>	<i>October 6 to November 30/27</i>	

SKETCHES OF FRAMES SHOWING POSITION AND DESCRIPTION OF WELDS OF FORGINGS, OR PARTICULARS OF TESTS APPLIED TO CASTINGS.

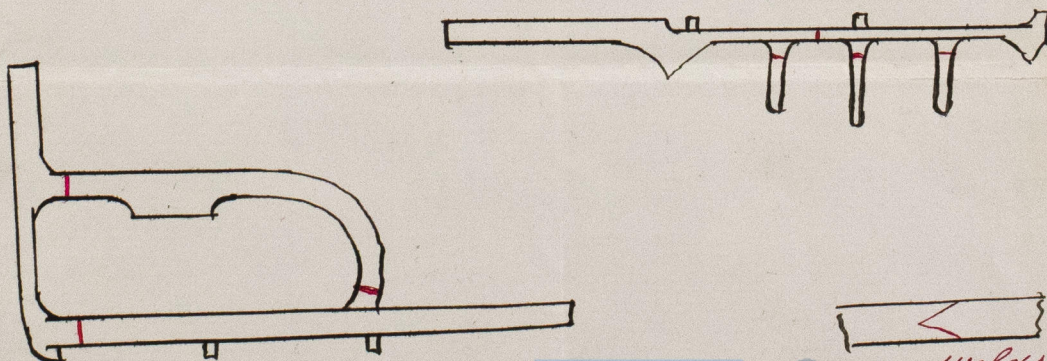

Fee (if any chargeable) £

:

To be paid at

\* If of Iron, state whether scrap or puddled Iron.



© 2019

Lloyd's Register  
Foundation