

Received at

Office 10520/306

180

Lloyd's Register of British and Foreign Shipping.

(Report on Vessel No. 12463 Port Hull)

s/s *Malrus*

No. 4544 SHIP FORGINGS OR CASTINGS.

I have to report that the undermentioned Iron or Steel Forgings or Castings, manufactured by *Messrs Emerson Walker & Thompson* of *Dunston* for the Vessel No. *1*, being built by *Messrs Doig Mc Dougall & Co* of *Hull* have been inspected by me as set forth below, and found to be, so far as can be seen, *sound*

Mark on Forgings.

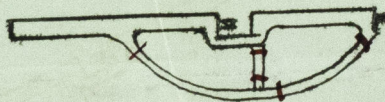
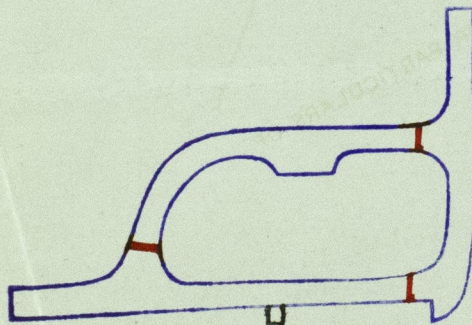
Lloyd's

No. 7999B

*B**John C Braij**Newcastle*

	STERN FRAME.	RUDDER FRAME.	STEM.
Material* ...	<i>Scrap</i>	<i>Scrap</i>	
How made ...	<i>Forged</i>	<i>Forged</i>	
Dimensions ...	<i>5-2</i>	<i>3-1 3/4</i>	
Progress on Inspection	<i>Forged & Smithed</i>	<i>Forged & Smithed</i>	
Date when Inspected	<i>June 5 to July 1/98</i>	<i>November 4 to 26/98</i>	

SKETCHES OF FRAMES SHOWING POSITION AND DESCRIPTION OF WELDS OF FORGINGS, OR PARTICULARS OF TESTS APPLIED TO CASTINGS.

*welds*

Fee (if any chargeable) £ : :

To be paid at

* If of Iron, state whether scrap or puddled Iron.