

26.3.98
14.6.98
13.6.98
29.7.98

Handwritten notes in red ink:
26.3.98
14.6.98
13.6.98
29.7.98


— Profile —
Yard No. 1

— Scale $\frac{1}{4}$ " = 1 foot —

60 BP x 14.75 x 7.75 m

Doig, W. Dougall + Broadley

New Holland - 24/3/98

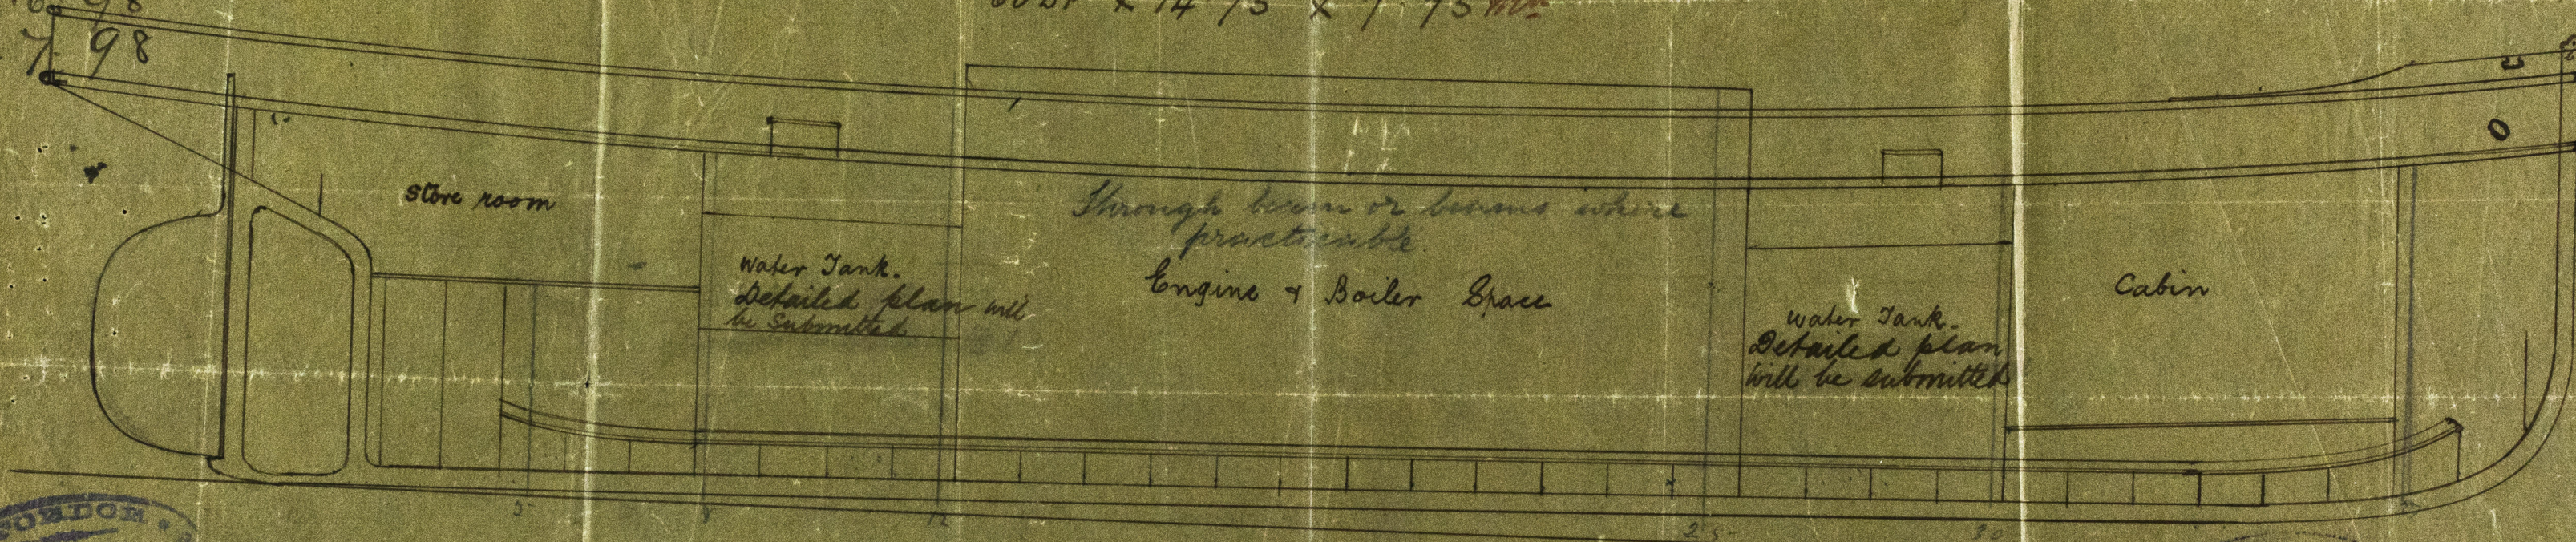


Handwritten:
J.P.L.
26/3/98



© 2020
Lloyd's Register
FOLIO 418-0252

LLOYD'S REGISTER OF SHIPPING
 RECEIVED
 23 JUN 1898
 LONDON

HVL 418-0252

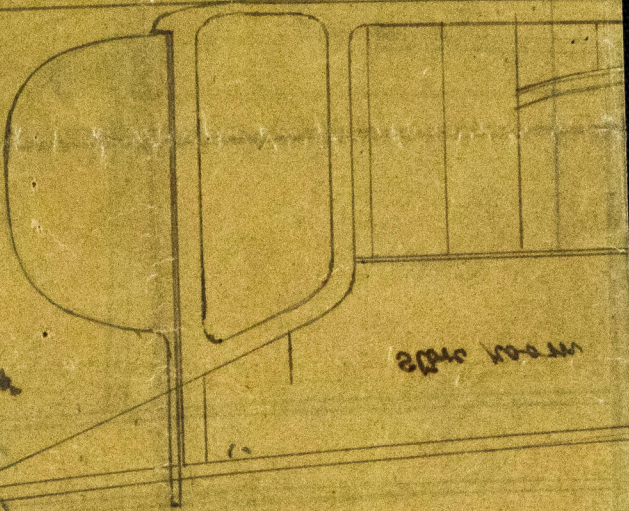

SPRUE ROOM

20. 1. 08
 13. 2. 08
 14. 2. 08
 20. 3. 08

29 April 1946
 5/5 26 MAR 02

LLOYD'S REGISTER OF SHIPPING
 RECEIVED
 26 MAR 02
 LONDON

LLOYD'S REGISTER OF SHIPPING
 RECEIVED
 26 MAR 02
 LONDON

Lloyd's Register
 Foundation