
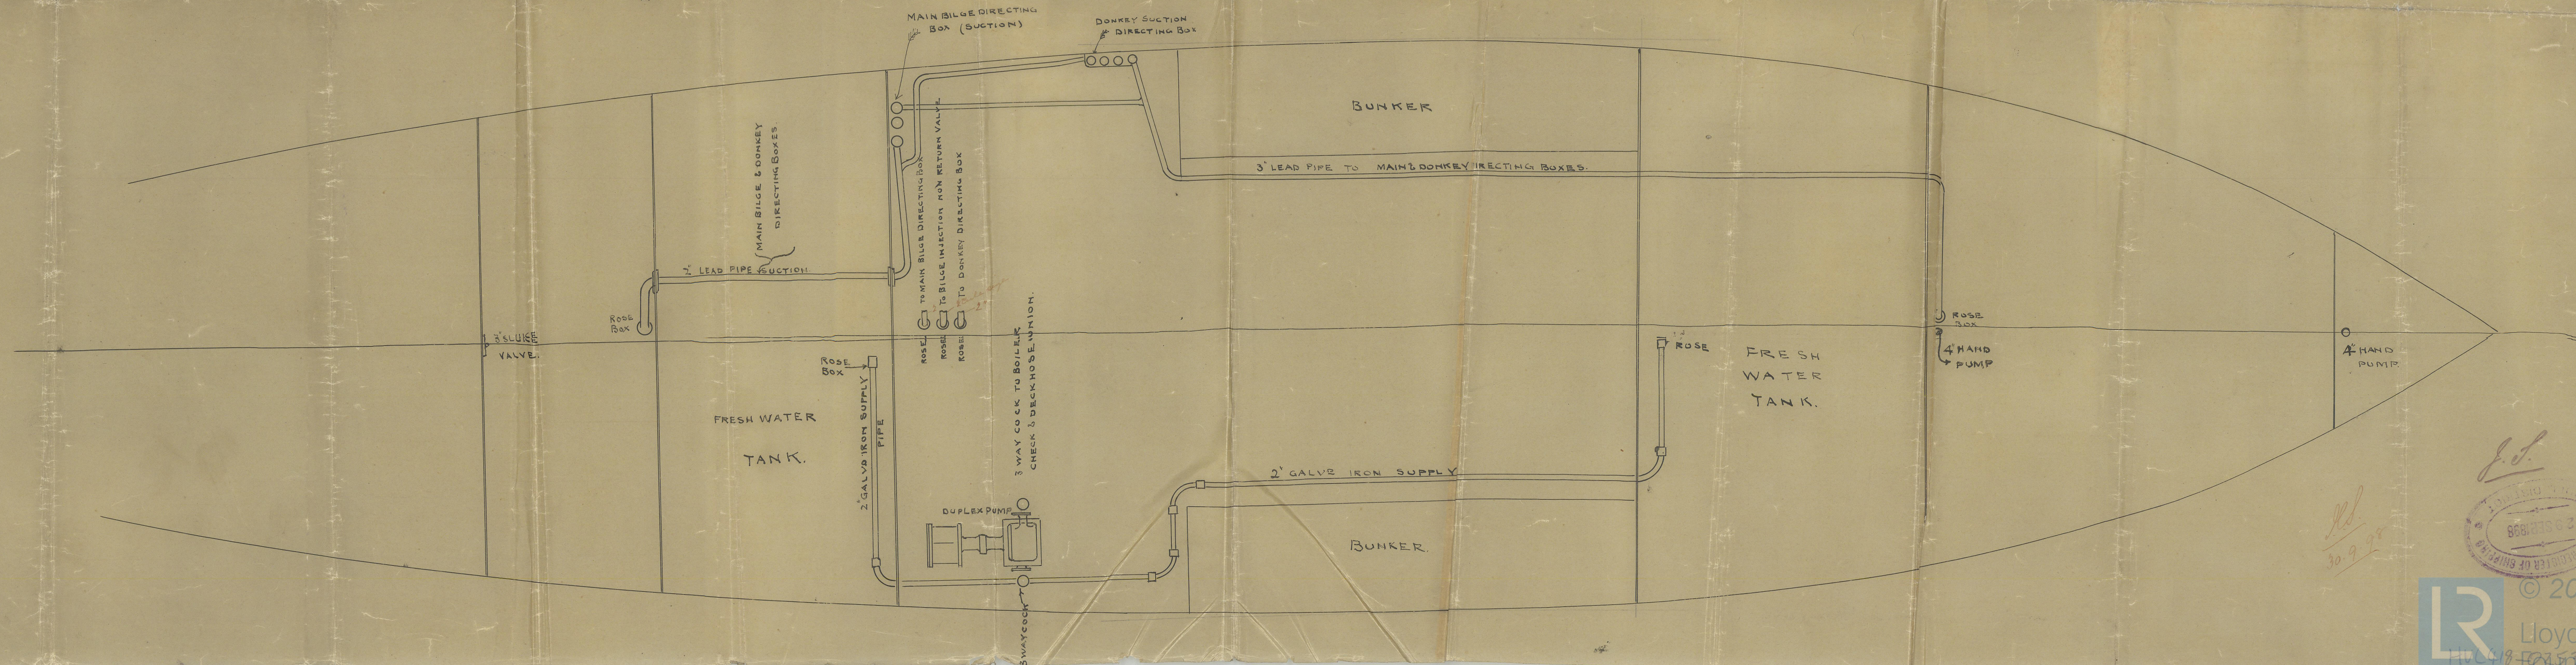


Mr
1:10:98

ARRANGEMENT OF PIPING
SCREW TUG NR. 1.
SCALE 1"=ONE FT.

und 77 1/2
53491 at 10:45
HATCH 0523

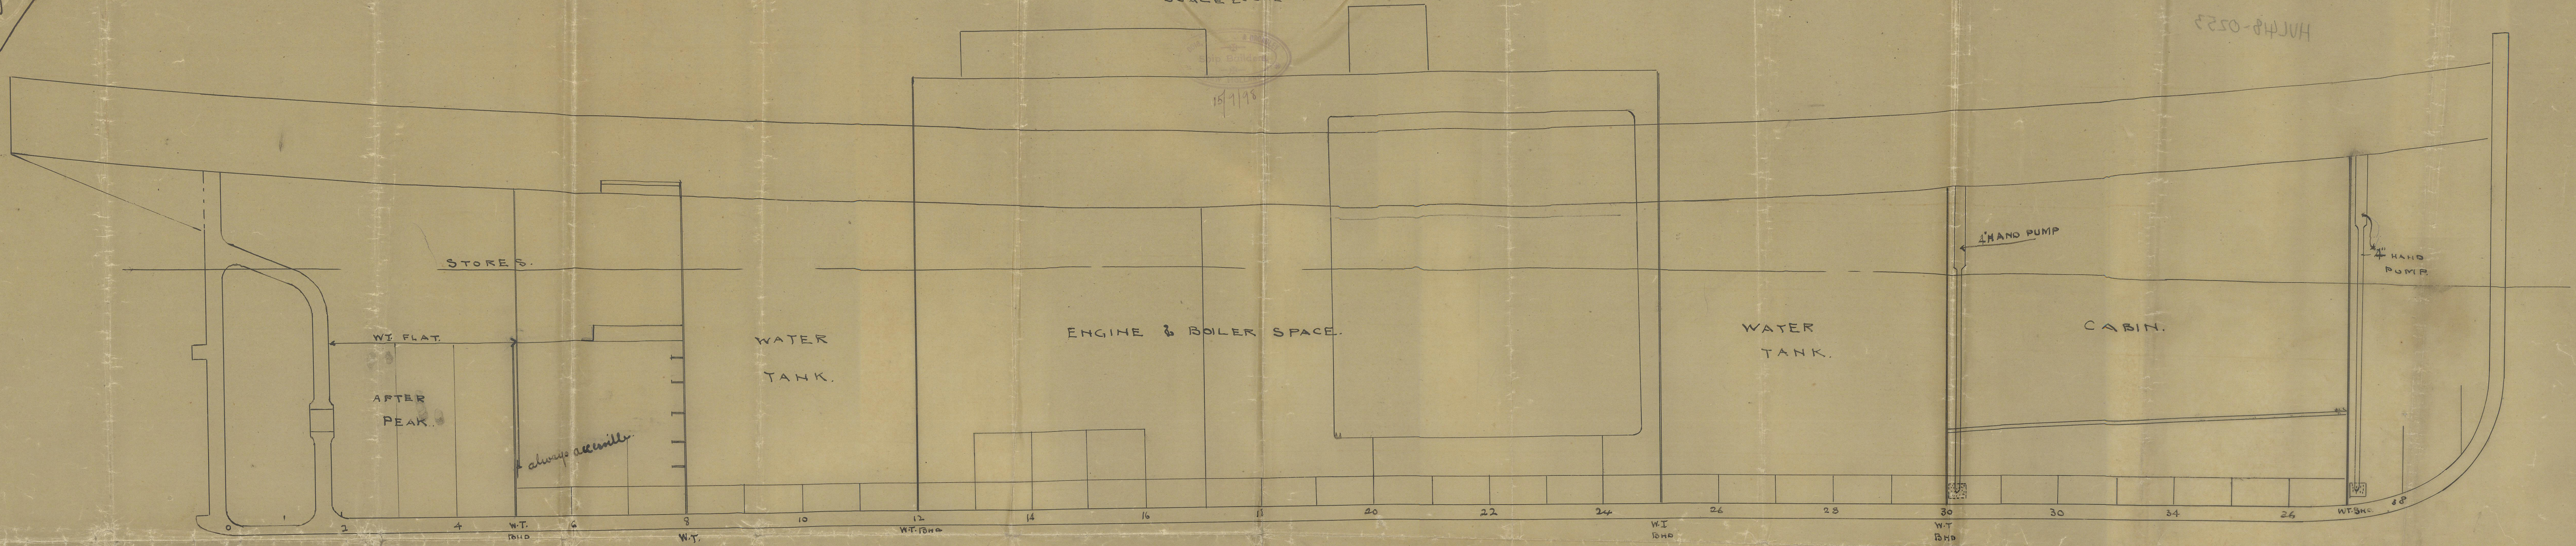


L.S.
30.9.98
REGISTERED

HVL418-0253

