
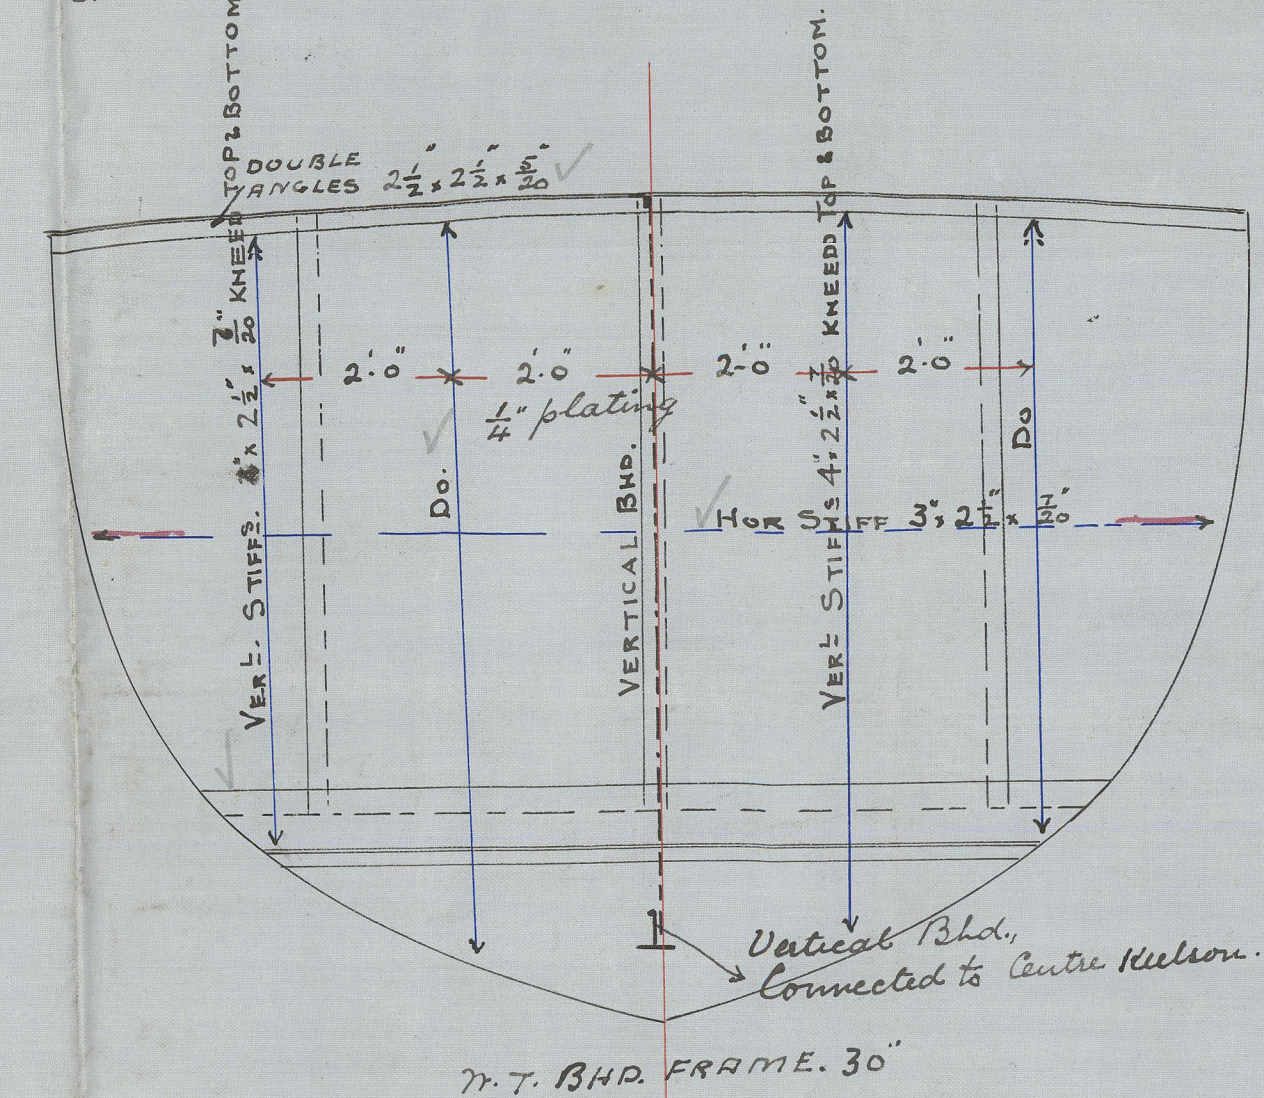
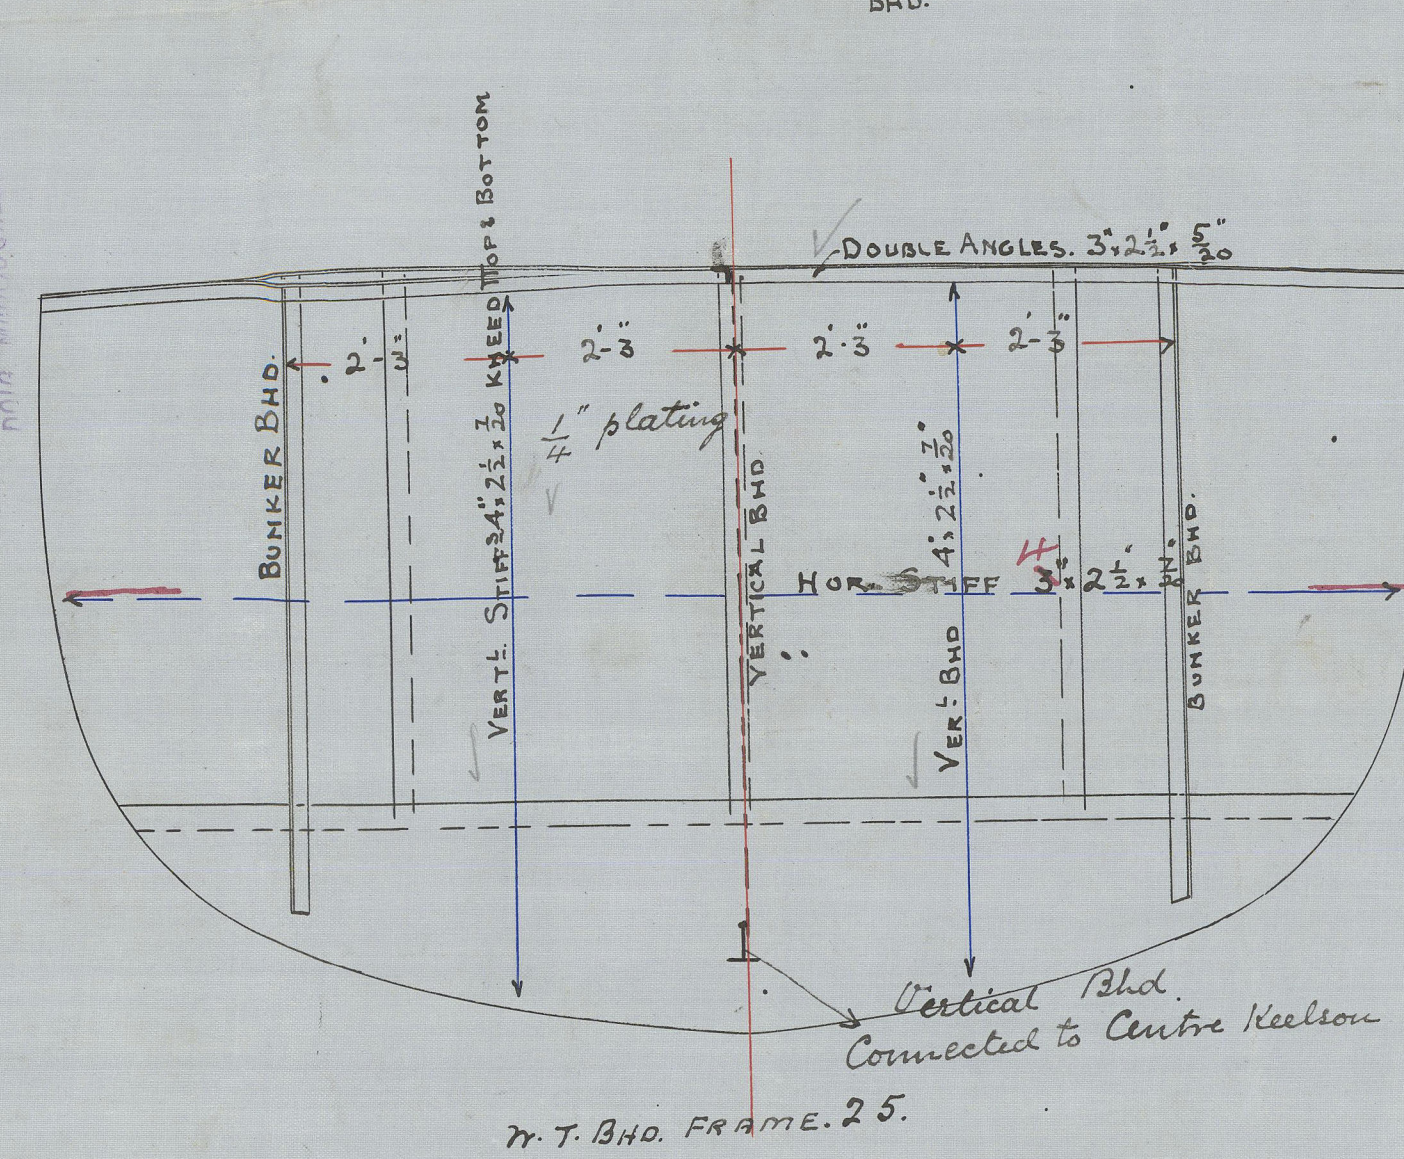
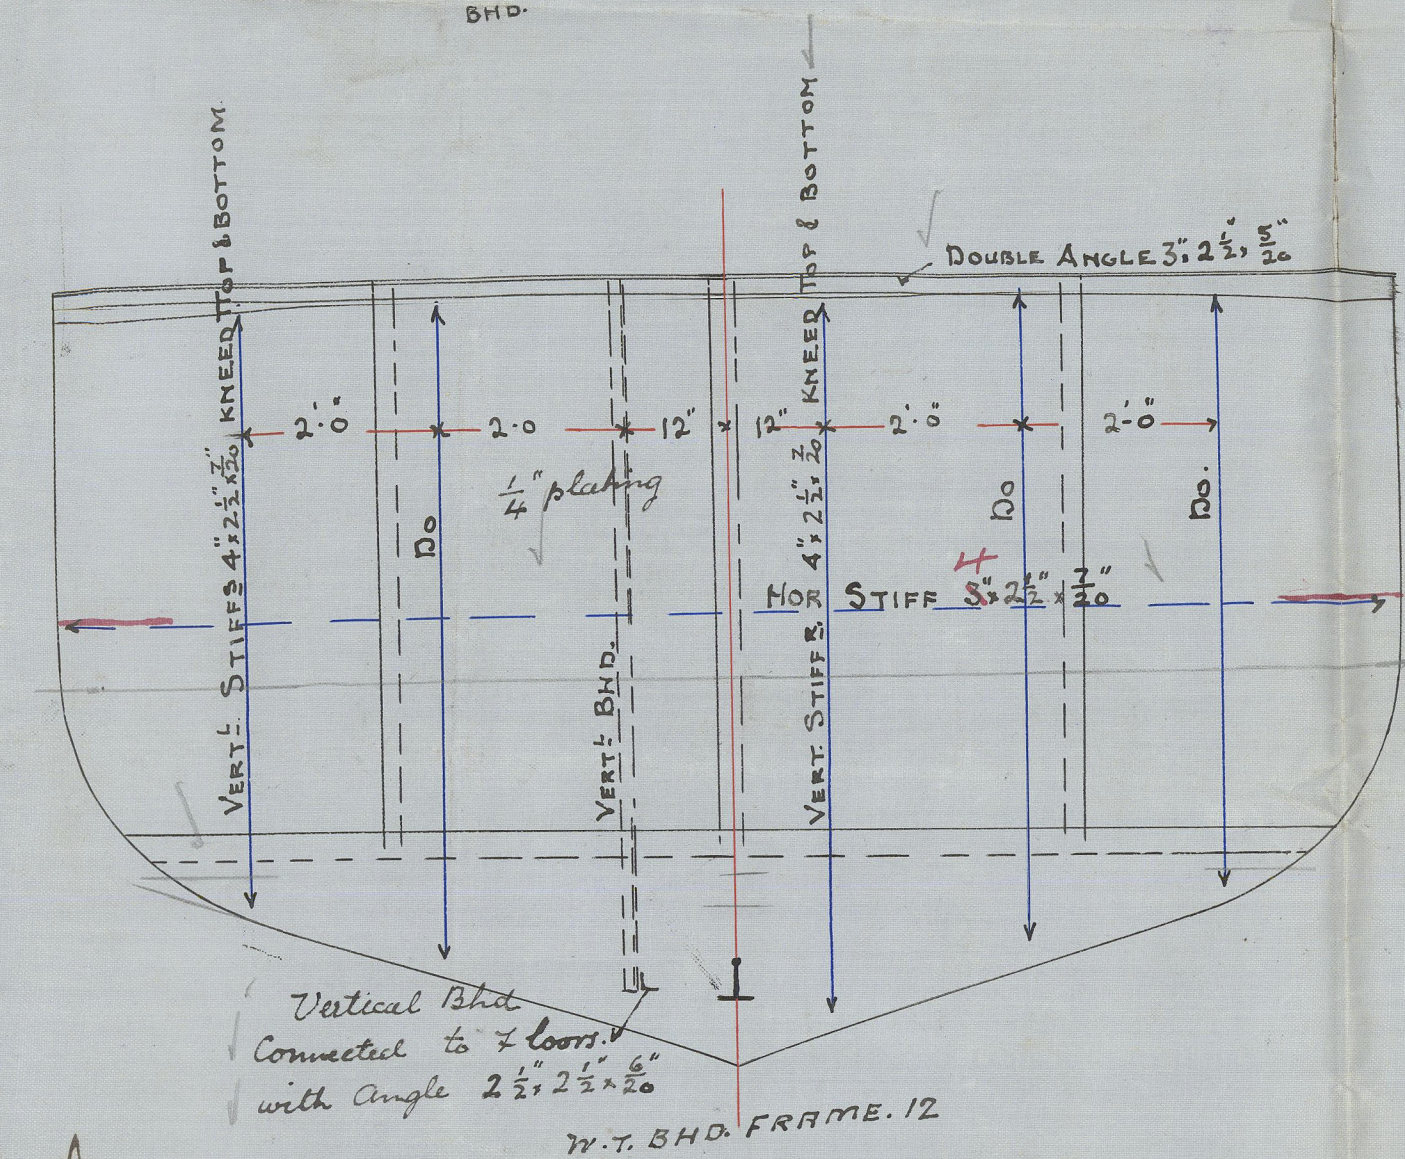
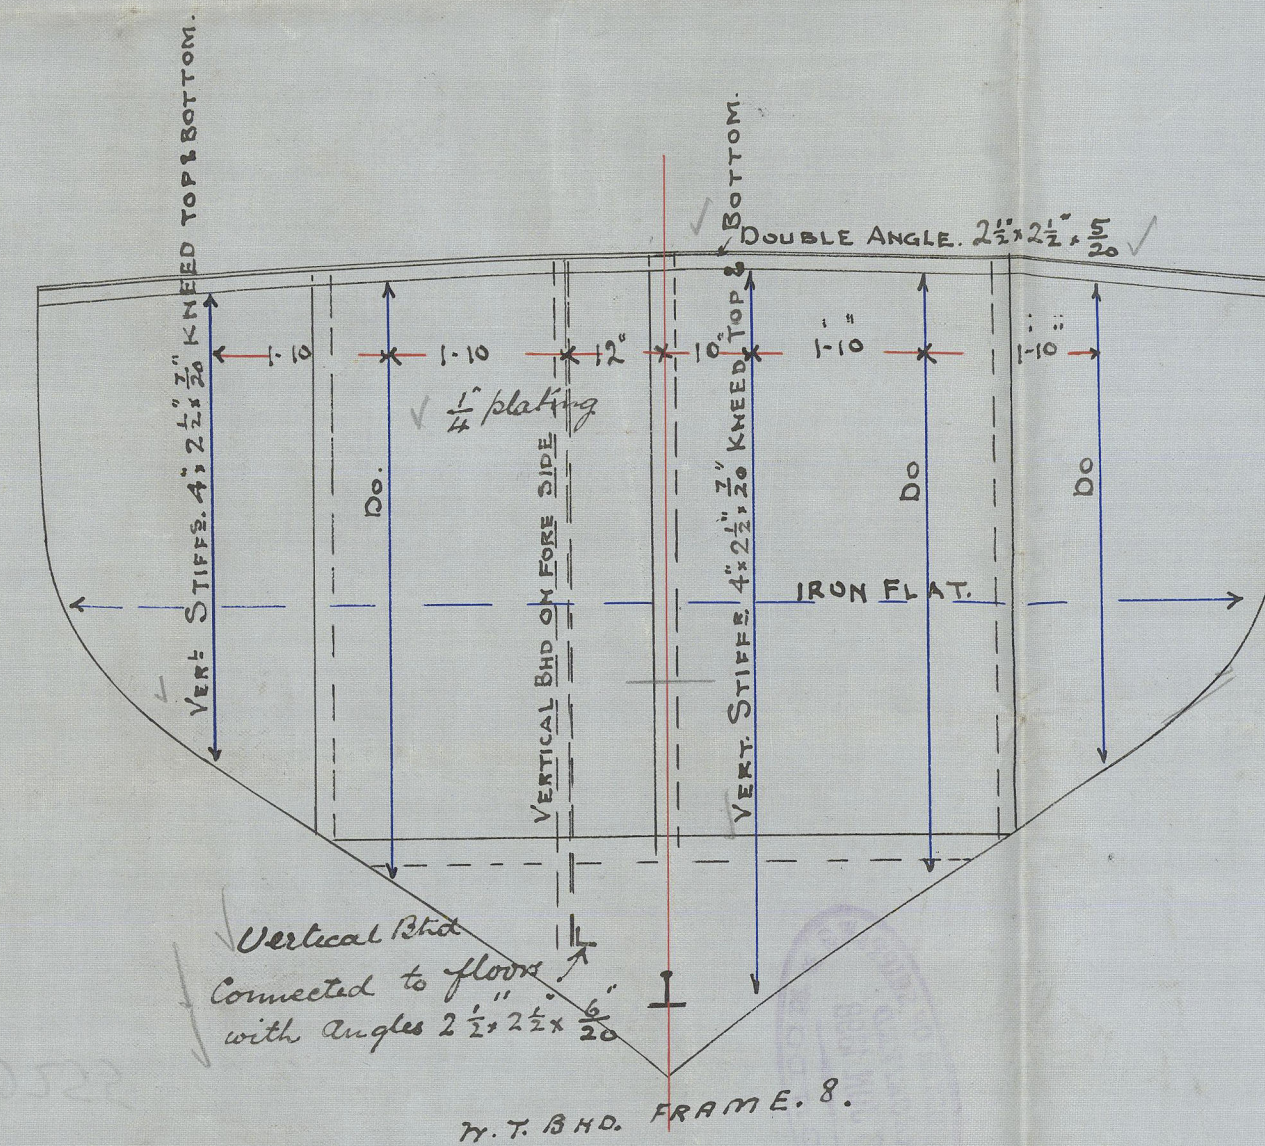


73.6.98

DOUGALL & BROADLEY.
 AMENDED. SKETCH SHOWING POSITION & STIFFENING
 OF WATER TANKS & BULKHEADS.
 SCREW TUG. No 1.
 SCALE $\frac{1}{2}$ " = ONE FOOT.

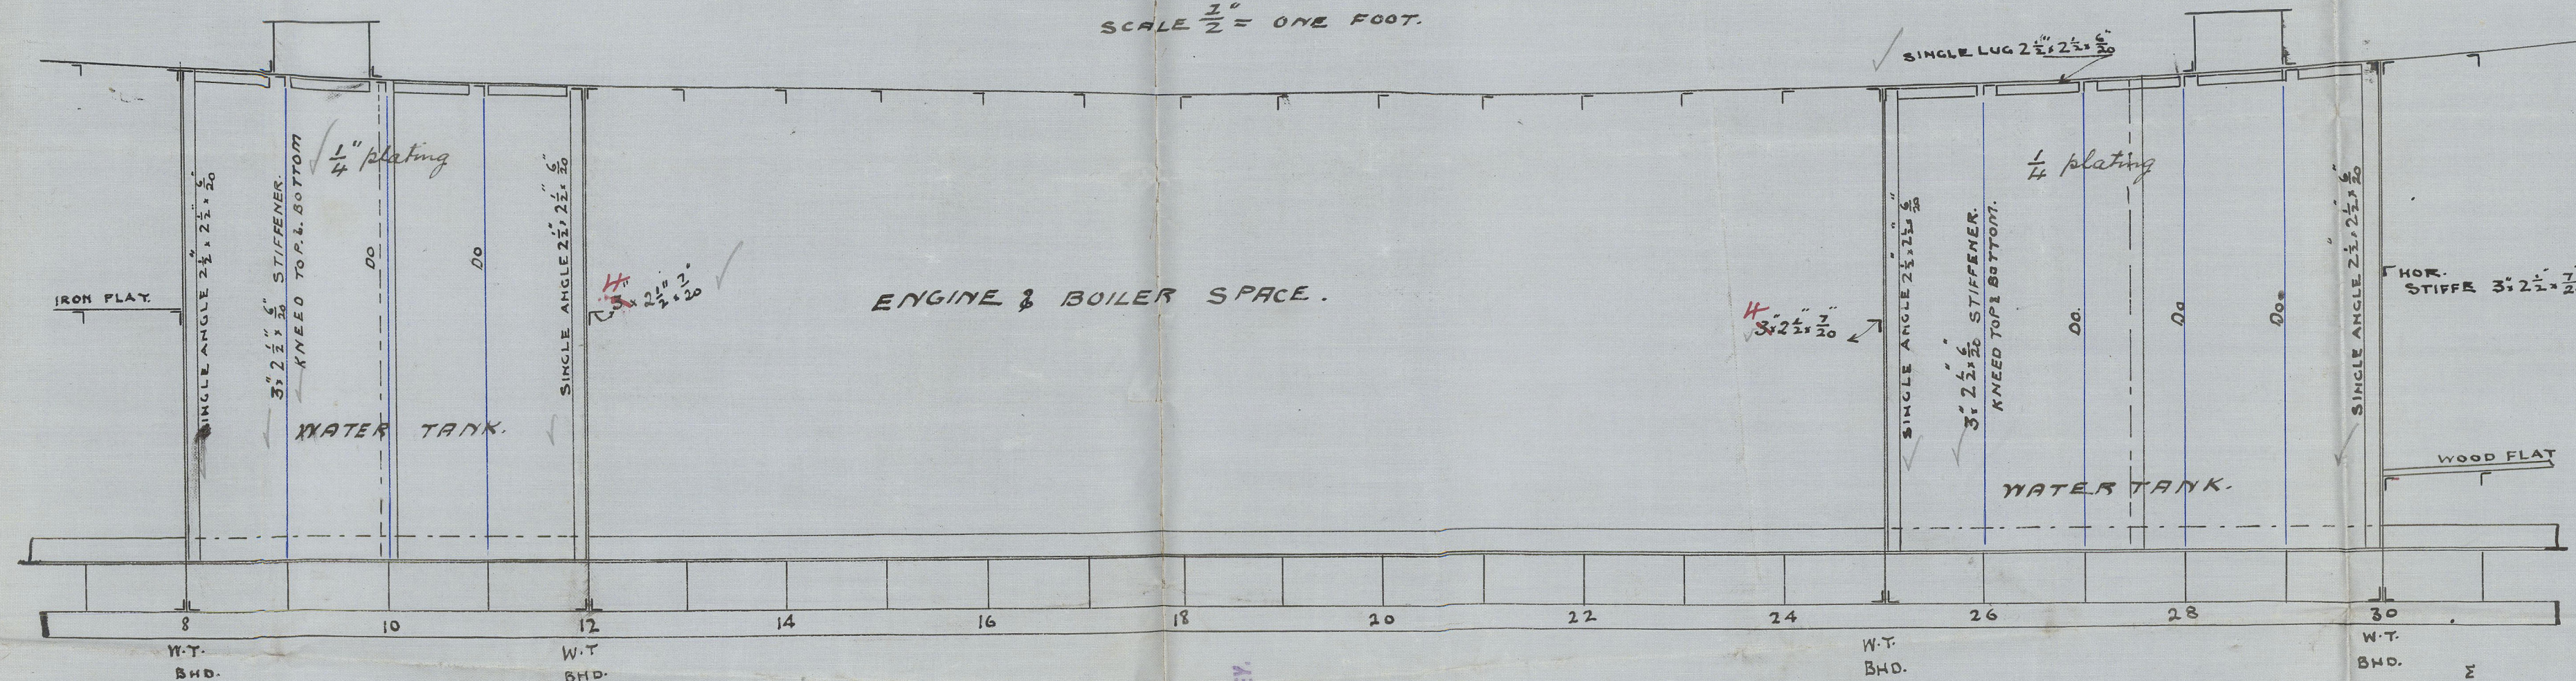

22 JUN 1900

J.S.

S/s Malurus
Hull Report No. 12463

HVL418-0255

