

N^{os} 466-7
Lloyd's Mid. Sec.

1/5 Linnet
Hull Report No. 13088

HUL421-0171

2
2



N^{os} 466-7

WIDSHIP

DIMENSIONS PER ROUTE

© 2019

Lloyd's Register
Foundation

N^{os}. 466-7. **MIDSHIP SECTION.**

DIMENSIONS PER RULE - 113.75 x 21.5 x 12.5

SCALE $\frac{1}{2}$ " = 1 FOOT.

CLASS 100 A1 STEEL.

NUMERALS.

$\frac{1}{2}$ BREADTH = 10.75

$\frac{1}{2}$ GIRTH = 18.87

DEPTH TO KEEL = 12.50

42.12 = 1ST NO.

LENGTH OF VESSEL = 113.75

21060


29484

12636

4212

4212

4791.1500 2ND NO.

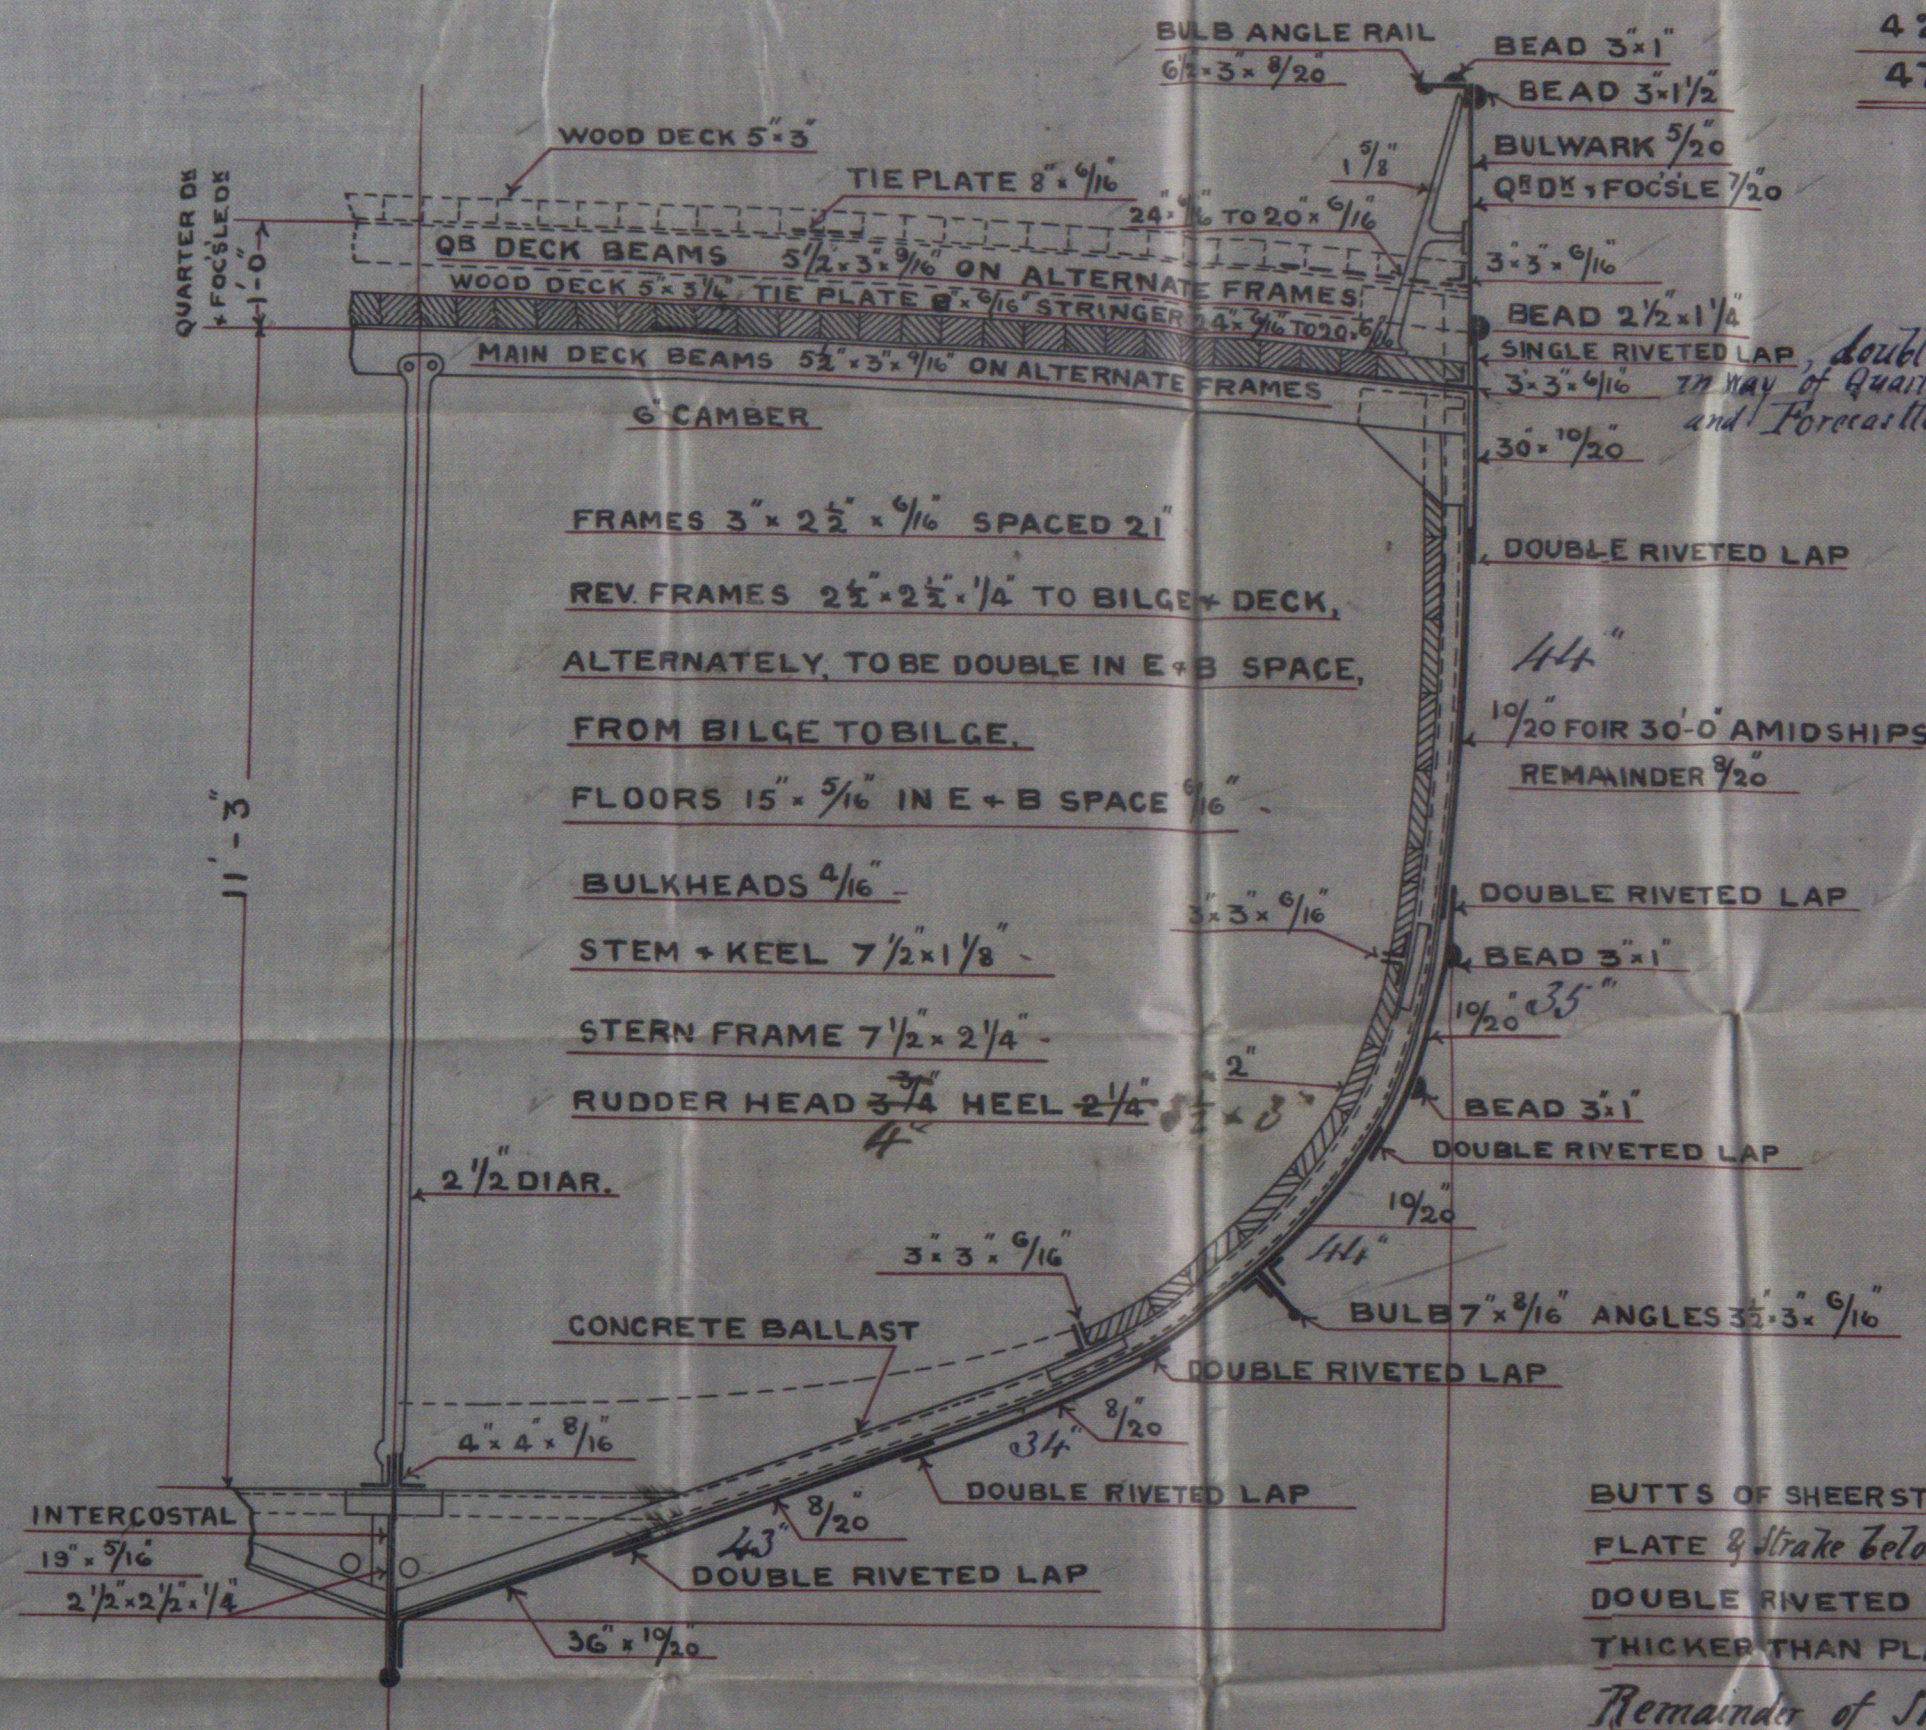

BUTTS OF SHEERSTRAKE STRINGER-
 PLATE & Strake below Sheerstrake TO BE
 DOUBLE RIVETED WITH STRAPS $\frac{1}{20}$
 THICKER THAN PLATES THEY CONNECT.

Remainder of Shell plating to have
 double riveted Butt Laps, excepting
 Garboard Strake which will be butted
 with double riveted straps $\frac{1}{20}$ thicker
 than plates they connect.

J.F.
 8/7/99