



21.6.99



— IRON —  
— S.S. No 274 —  
— MIDSHIP SECTION —

— DIMENSIONS 100.0 X 21.0 X 11.0 —

— SCALE 1/2" = 1 FOOT —


— CLASS 100. A. 1. —

— RAISED QUARTER DECK 14.9 —

— RAISED FORECASTLE DECK 17.0 —

— DIMENSIONS — FT. 1<sup>10</sup>  
— LENGTH AS PER RULE — 98.9  
— 1/2 MOULDED BREADTH — 10.5 1/2  
— DEPTH K TO M.D.B. — 12.4

FEET.  
1/2 GIRTH 18.92  
1/2 BREADTH 10.45  
DEPTH 12.33  
41.70 1<sup>ST</sup> No  
98.75  
208.50  
2919  
3336  
3753  
4117.8750 2<sup>ND</sup> No

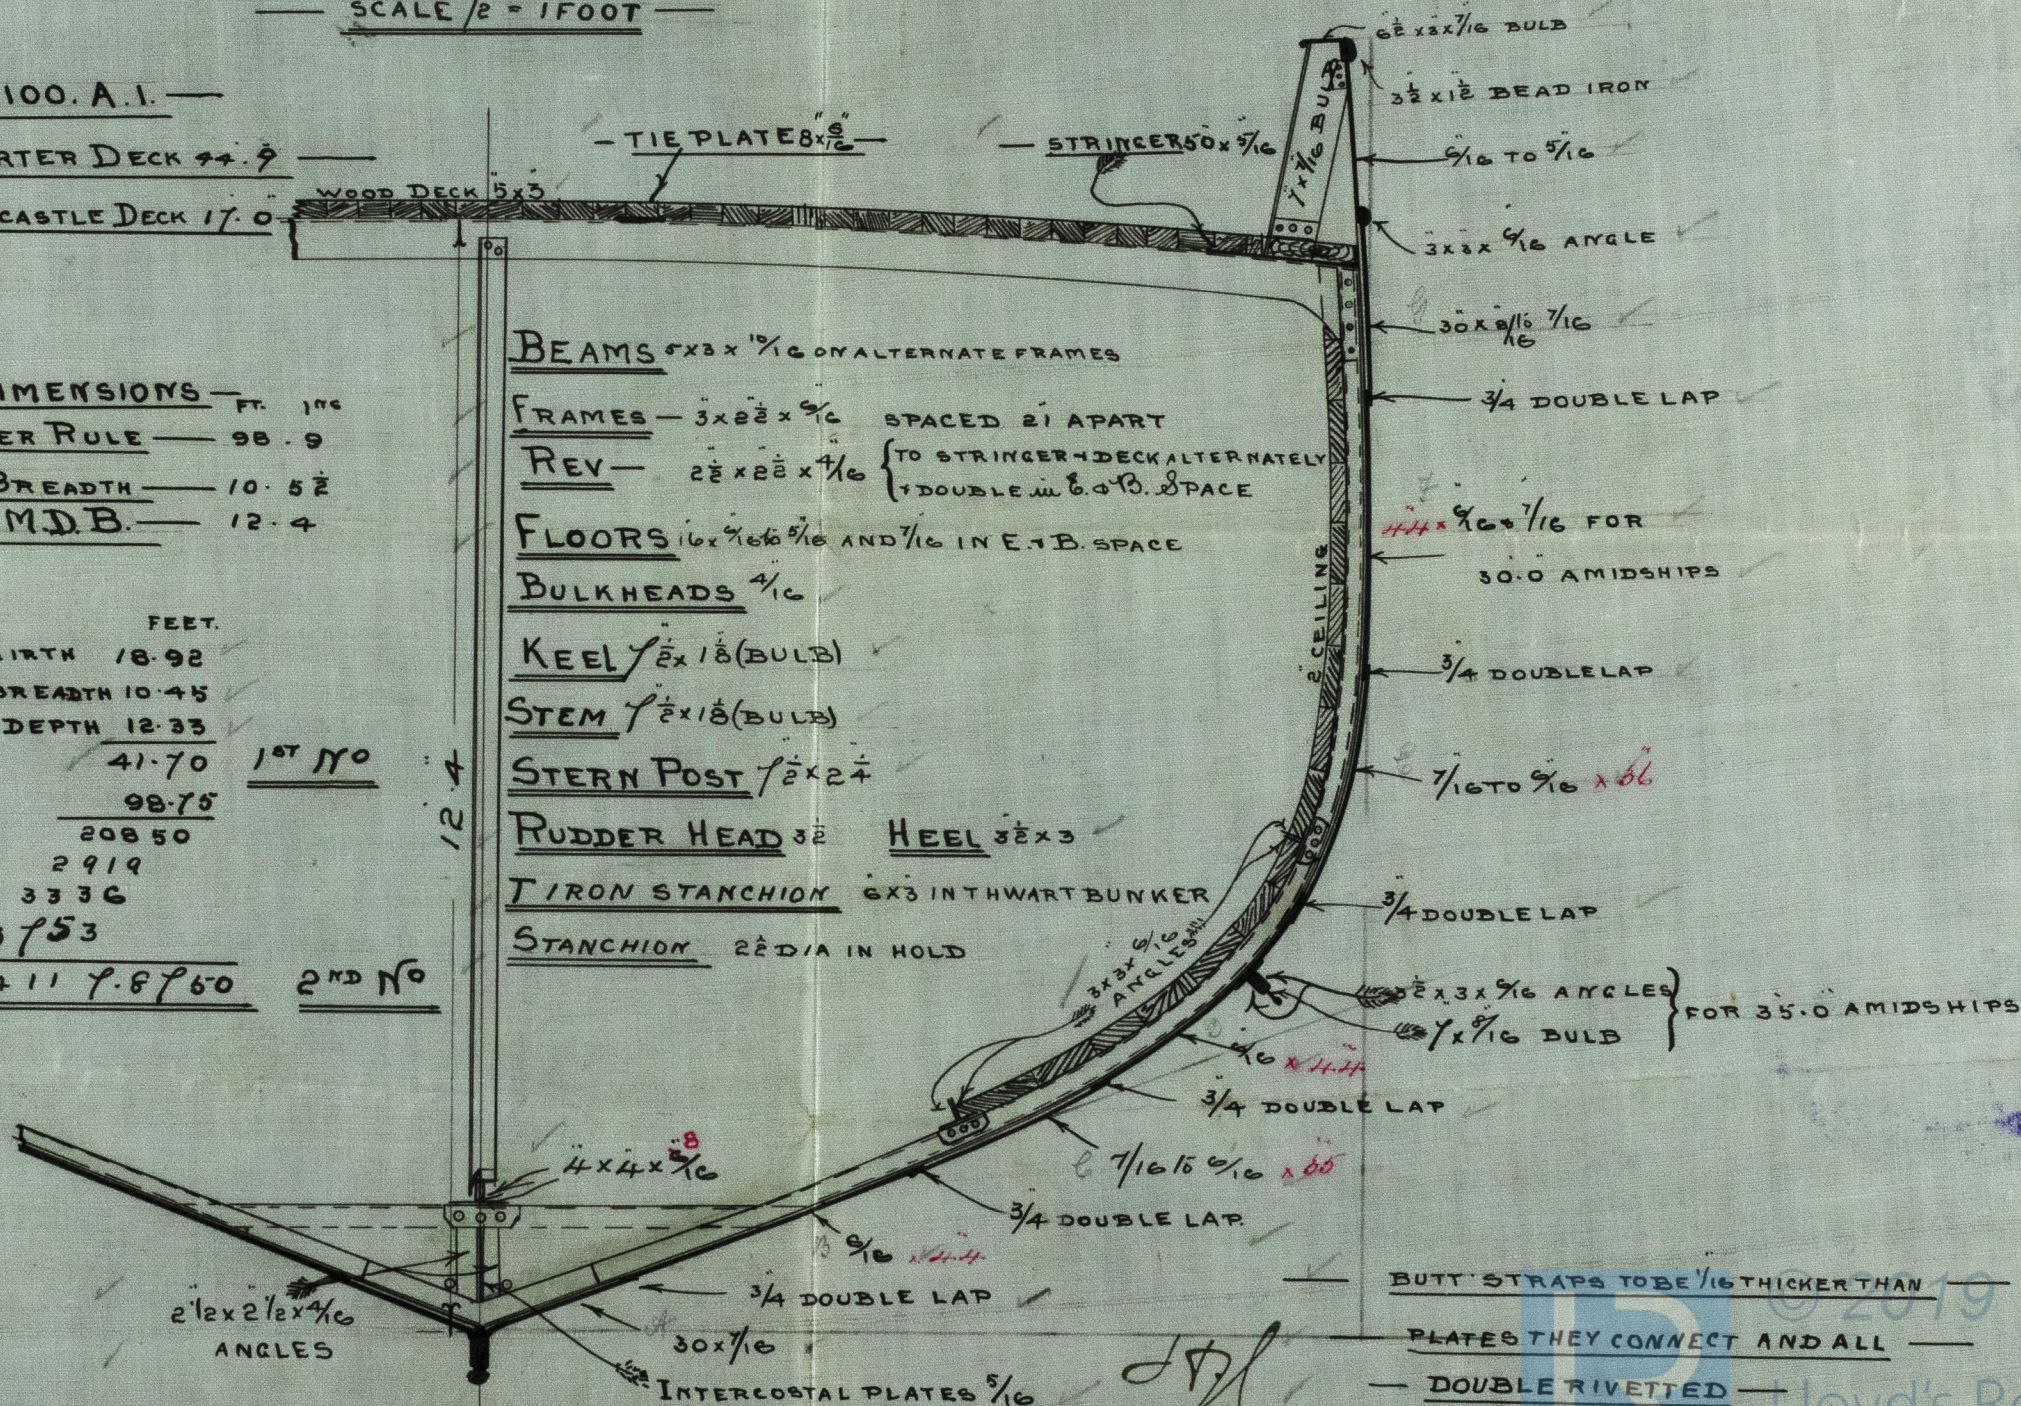

21/6/99


HUL421-0195



s/s Rinto

HUL421-0195

Hull Report No. 13113

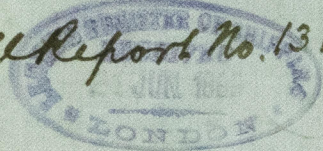

© 20

Lloyd's Register  
Foundation