

SCALE  $\frac{1}{2}'' = 1 \text{ FOOT.}$

NUMERALS.

$$\frac{1}{2} \text{ BREADTH} = 10.75$$
 $\frac{1}{2} \text{ GIRTH} = 18.87$ 

DEPTH TO KEEL = 12.50

$$42.12 = 1^{\text{ST}} \text{ NO}$$

LENGTH OF VESSEL = 113.75

21060

29484

1 2 6 3 6

4212

4212

4791-1500 2<sup>ND</sup> No. ✓

BUTTS OF SHEERSTRAKE STRINGER-  
PLATE & Strake Below Sheerstrake TO BE  
DOUBLE RIVETED WITH STRAPS 1/2"  
THICKER THAN PLATES THEY CONNECT.

Remainder of Shell plating to have double riveted Butt Japs, excepting Garboard Strake which will be butted with double riveted straps  $\frac{1}{16}$ " thicker than plates they connect.


1 K.  
28/6/99



Midship Section.

467.

s/s Swallow  
Hull Report No 13134

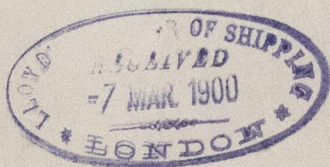

HUL422-0016



© 2019

Lloyd's Register  
Foundation