


20.7.10
4.8.10

PROPOSED TOWING LIGHTER HERKULES


DIMENSIONS		
LENGTH BP	—	136' 0"
BEAM M ^{LD}	—	23' 3 3/4"
DEPTH M ^{LD}	—	11' 1"
SHEER 3' 6" FORWARD & 2' 3" AFT		
SCALE 1" = 1 FOOT		

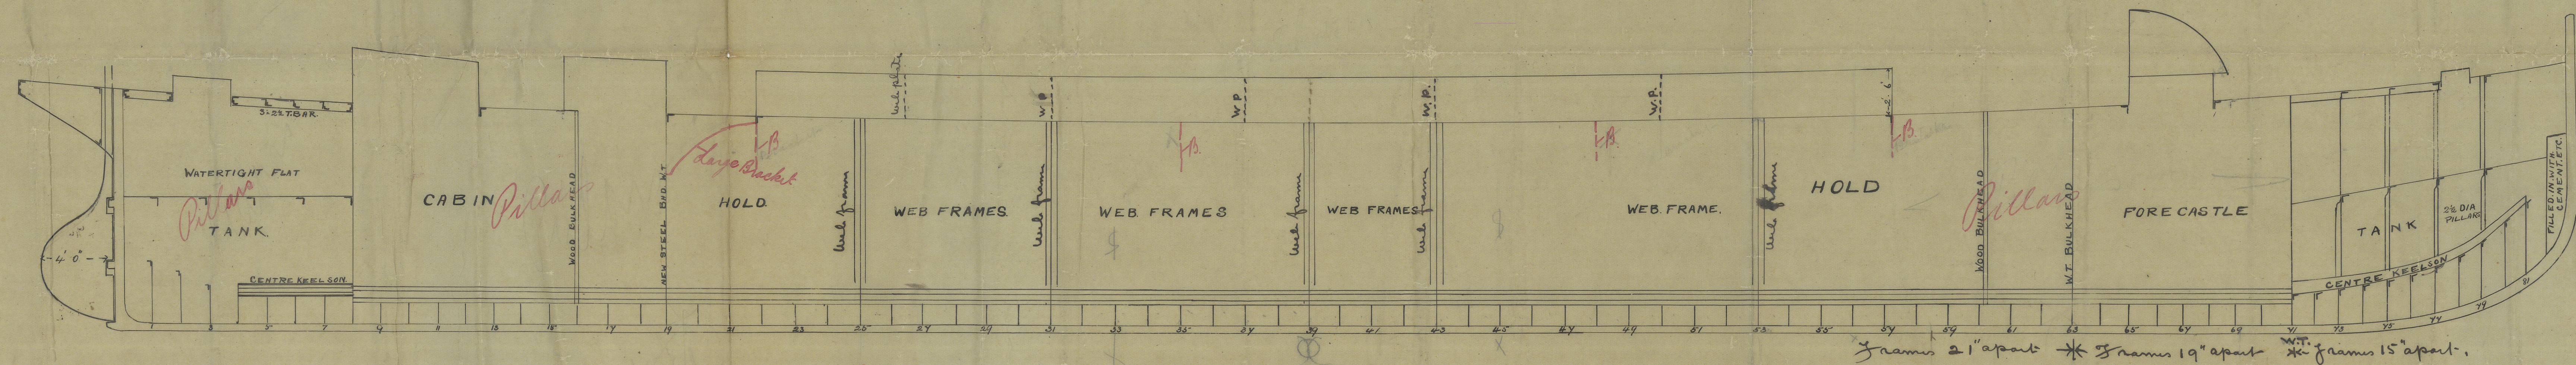

NUMERICALS	
BREADTH	23' 3 3/4"
DEPTH	11' 1"
TRANSVERSE No	34.083
LENGTH	136' 0"
LONGITUDINAL No	4675

PROPOSED TOWING LIGHTER HERKULES

DIMENSIONS	
LENGTH BP	— 136' 0"
BEAM M ^{LD}	— 23' 3 3/4"
DEPTH M ^{LD}	— 11' 1"
SHEER 3' 6" FORWARD & 2' 3" AFT	
SCALE 1" = 1 FOOT	

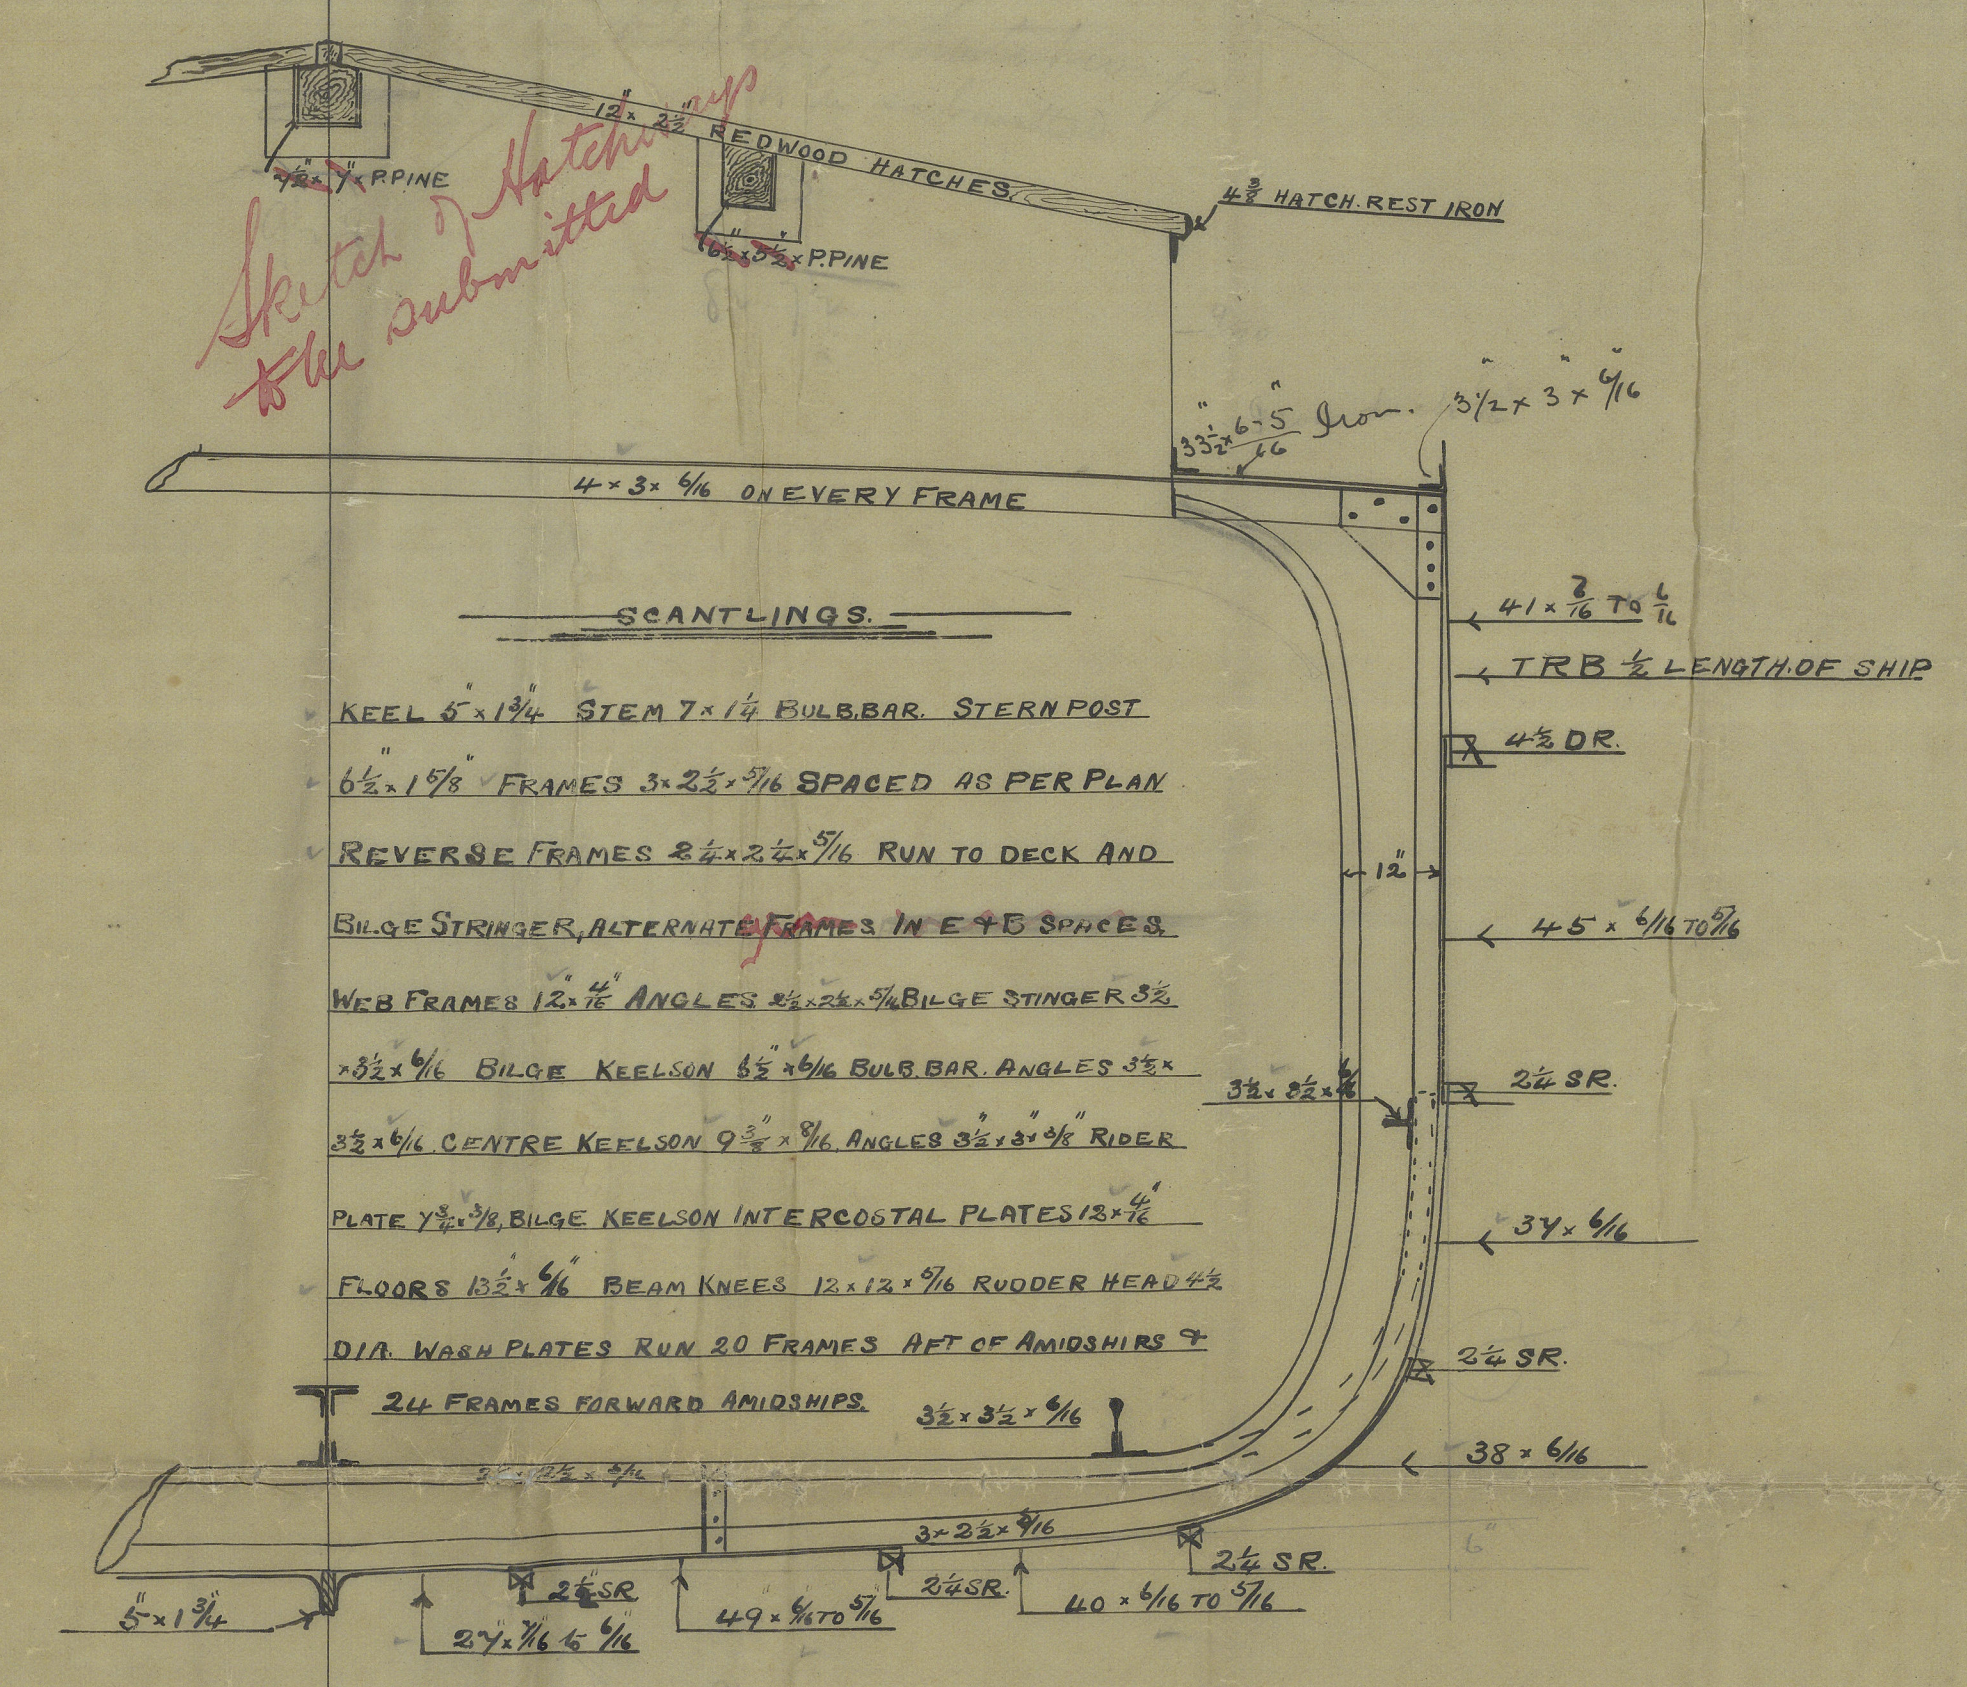

by ^a Herkules ⁷



J. Scan & Son

S/c Reno Hull Rpt No. 22919

aka "Herkules"

23044.

(1)

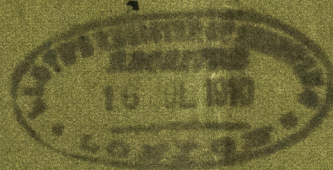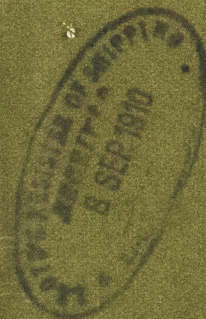

See also
Plans app. 1/8/10

HVL 426-0137

PROPOSED TOWING LIGHTER HERKULES

DIMENSIONS

LENGTH BP

130 0

BEAM

M-F

23 3/4

DEPTH

11 1

SHEER 3 0 FORWARD 2 3 AFT

SCALE 1 FOOT



© 2020 Lloyd's Register Foundation