
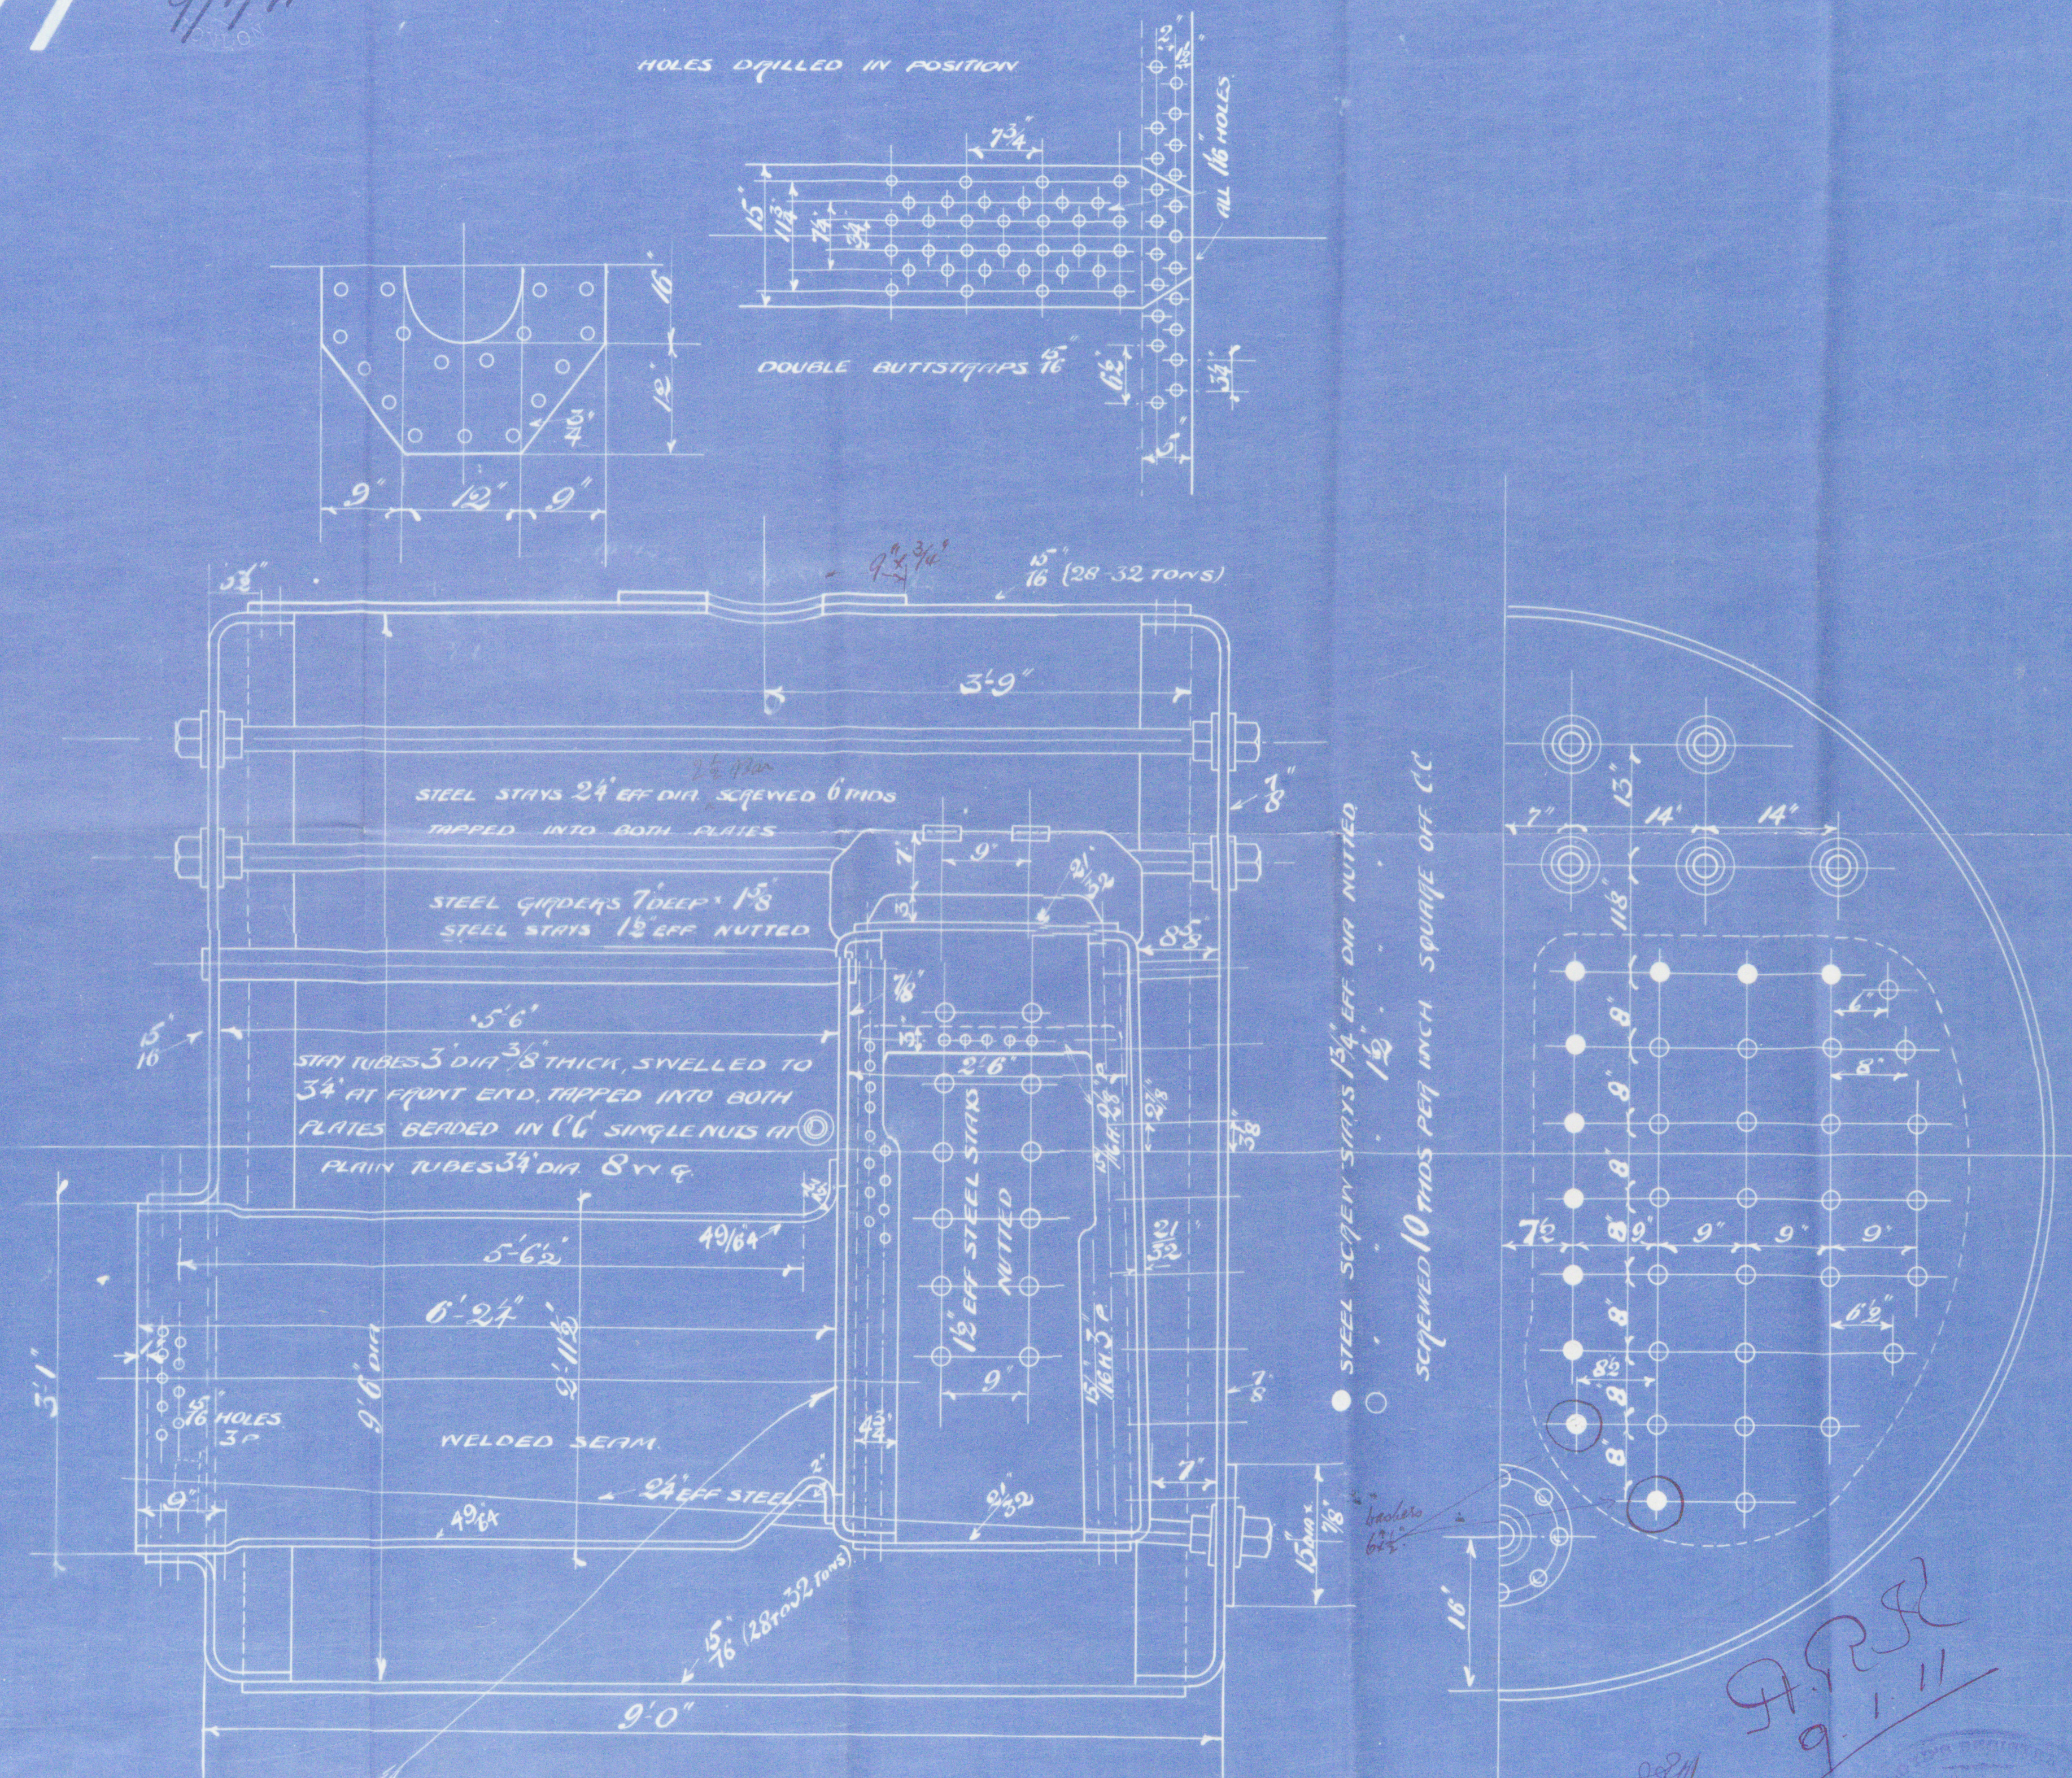


STEEL BOILER 9'-6" DIA 9'-0" LONG 180 LBS W.P. LLOYDS

4277

9/1/11

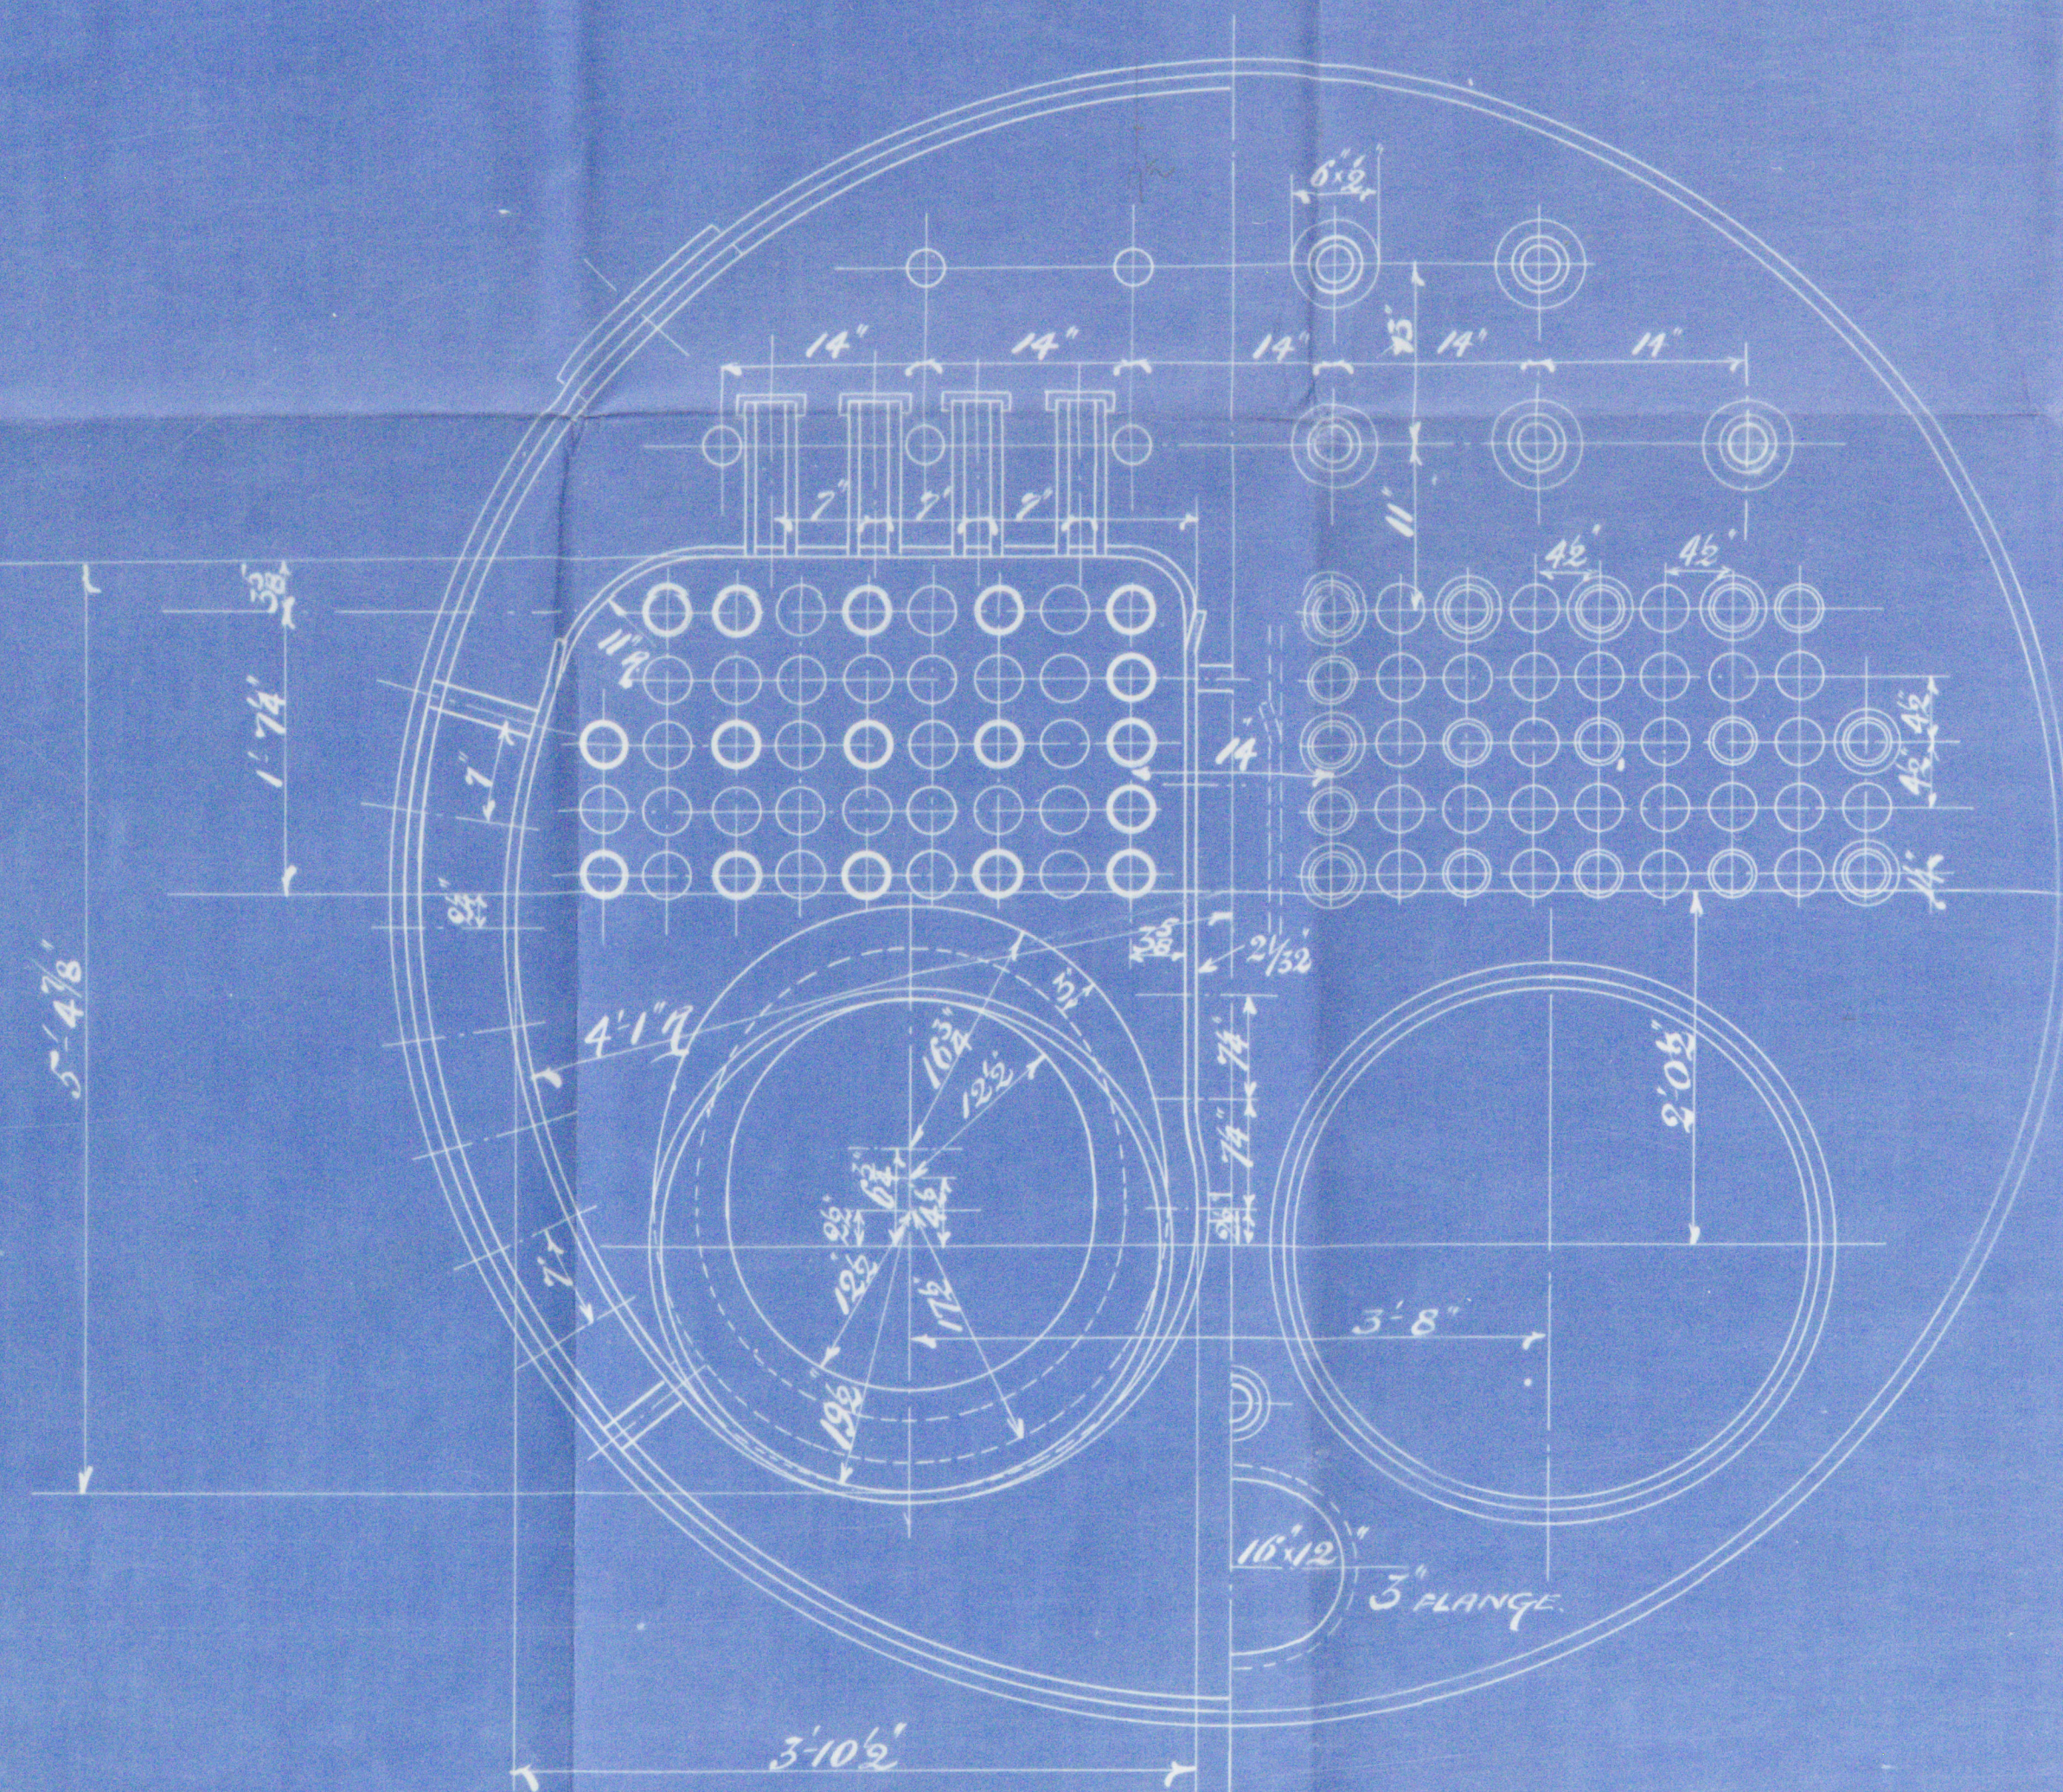

THIS JOINT TO BE MACHINED

HEATING SURFACE 580 sq. ft.
GRATE AREA (4 FT BAR) 23 sq. ft.

RILEY BROS (BOILERMAKERS) LTD
STOCKTON ON TEES.

9/1/11

ADM

R


© 2020

Lloyd's Register
Foundation

Thos Riley Bros Firm
Boiler No 4277
for

from The Hull steam Fishing
& Ice Co Firm;

working Press 180 lbs.

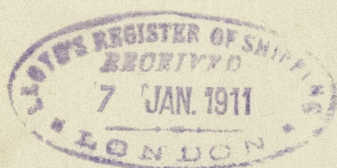

4277

No. 4608
LLOYD'S TEST.
360 lbs.
24-3-11
ALW

Kdtb Rpt-
No 6720

stm Trawler "Jersey"
of Hull

Not classed

HUL 426-0169



© 2020

Lloyd's Register
Foundation