


# REPORT of SURVEY for REPAIRS.

No. in Reg. Book. **No. 22017** Survey held at Birkenhead Date 16<sup>th</sup> Aug to 16<sup>th</sup> Sept 1869  
on the Iron S. "Haddington" Master Augrose  
Tonnage 1459 built at Liverpool When built 1846  
By whom built \_\_\_\_\_ Owners P & O Steam Nav Co  
Port belonging to London Destined Voyage India  
If Surveyed Afloat or in Dry Dock Clayton's dry dock

Last Survey, No. 6258 Port Iron. Classed A 1  
S.S. No. 1. 68

## REPAIRS

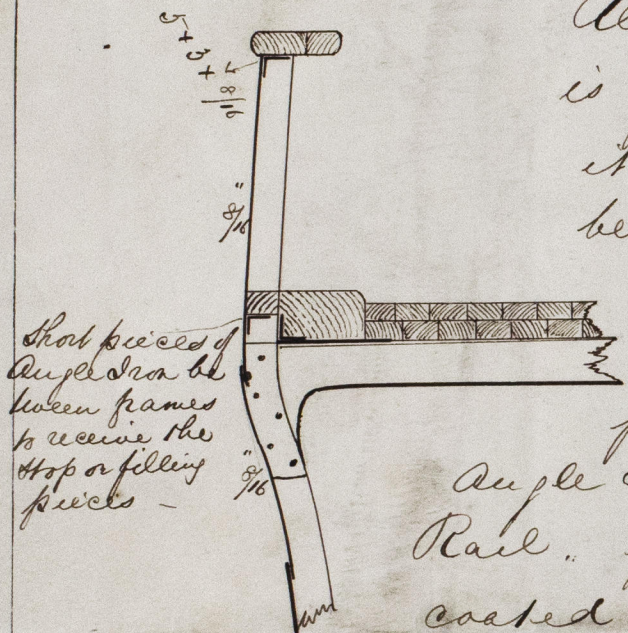

All new Bulwark plating  $7/16$ " thick which is of the same thickness as the strake to which it is attached. Short angle bars are rivetted between frames to rest stop pieces on and the short frames have been cut off level with the stringer Angle Iron. The stop or filling pieces are caulked & cemented over - an Angle Iron  $5 \times 3 \times 5/16$  has also been fitted under Rail. part new rails - bottom cleaned & coated

## Present Condition of the

Decks	Good	Freenails	where	Windlass and Capstan	Good
Waterways		Breasthooks and Stemson		Pumps	
Comings		Transoms, Pointers, and Crutches		Boats	
Upper Deck Beams & Fastenings	where	Timbers of the Frame at the openings	seen	Masts, Yards, &c.	and
Lower Deck Beams & Fastenings		Ditto Ditto at other places		Condition, how ascertained	
Planksheers		Keelsons		Sails	
Sheerstrakes	seen	Clamps and Shelves	Good	Anchors No. of	Sufft
Topsides		Ceiling		Cables	
Wales		Rudder		Hawsers and Warps	
Plank (Bottom) and Counter		Copper	Asp When put on	Standing & Running Rigging	

General Observations and Opinion,

Caulking of Bottom, Deck, & Waterways. Good

She is now in good condition and in my opinion may continue as Classed

The Amount of Fee.....£ - : - is received by me,

Special.....2 : 2 : -

Certificate (if required) - : 5 : -

Committee's Minute Liverpool 28<sup>th</sup> September 1869

Character assigned A 1

Willm. C. Davey



© 2019

Lloyd's Register Foundation

IRON444 - 0429



*"Haddington"*  
22017



© 2019

Lloyd's Register  
Foundation