



*Palmer Shipbuilding & Iron Co. Ltd.  
Liverpool on 2nd July 1870.*

*Three Decked Steam Vessel.*  

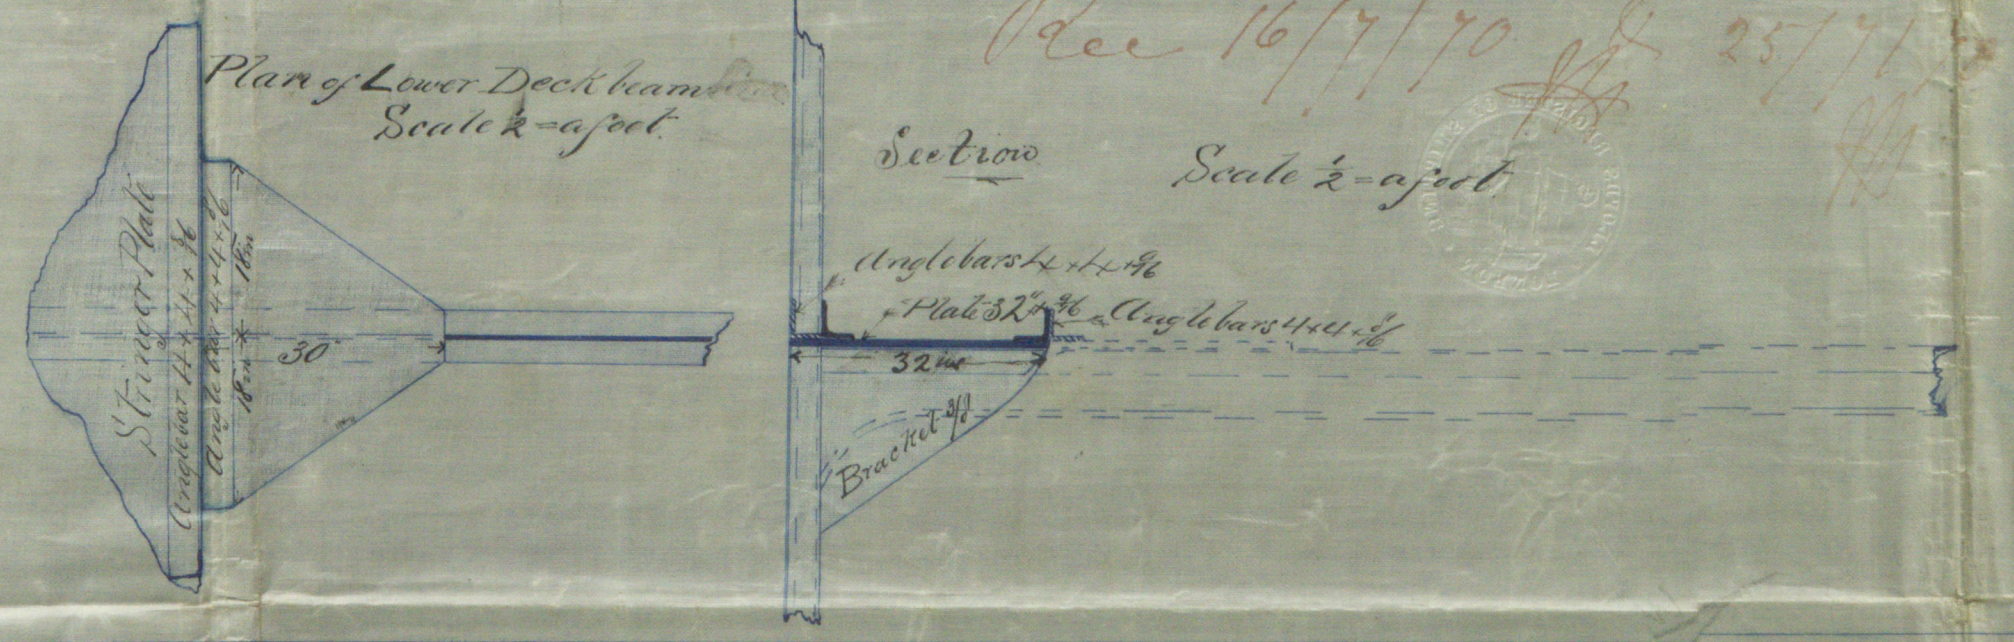

*Principal Dimensions*  
Length between perpendiculars 263'-0"  
Breadth extreme 33'-0"  
Depth of hold to Main Deck 17'-4"  
Depth of Main to Upper Deck 7'-0"  
Numbers 6483 17890 907. Claf.  
8183 21574

 

IRON 448-0044

*SMR  
19-7-70  
25-7-70*





RON448 - 0044




© 2019

Lloyd's Register  
Foundation