






14747-<sup>Iron</sup>

IRON 462-0137

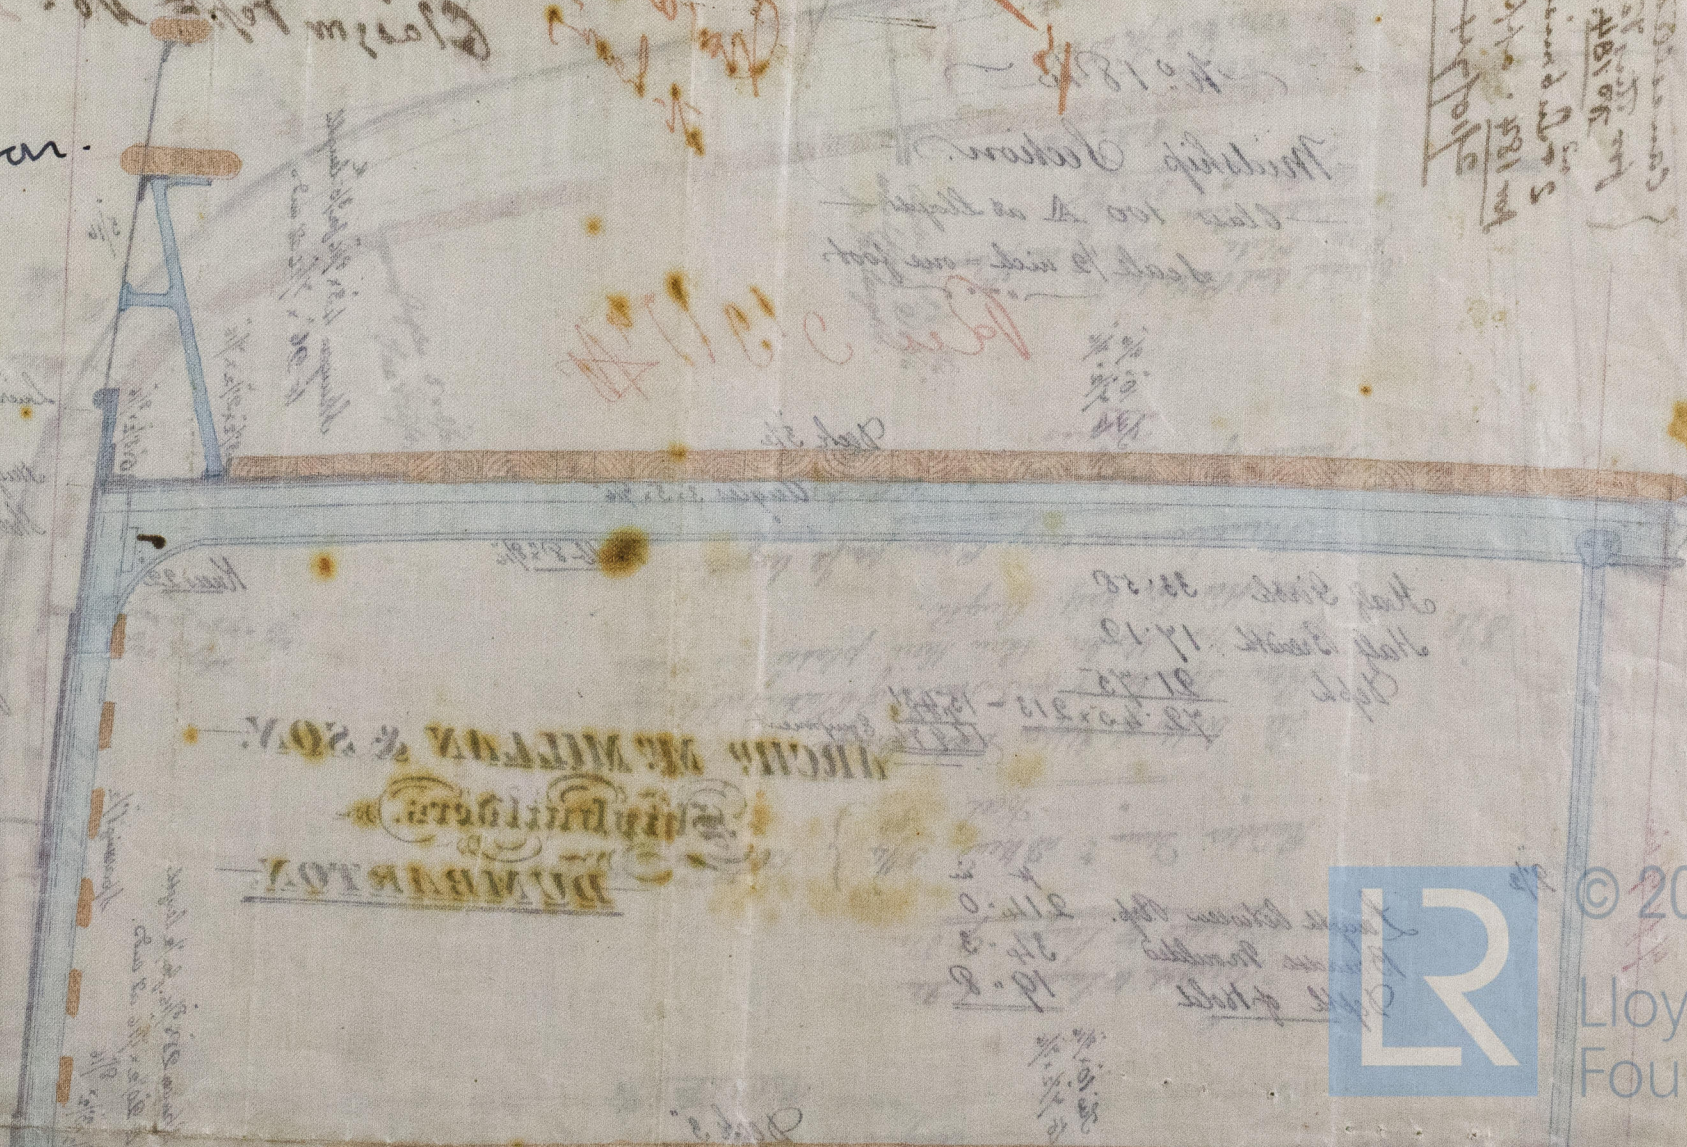

© 2021  
Lloyd's Register  
Foundation