



S. I. "Crested Abbey"
Report No. 4034


N^o 186 S S

CLASS 100A1 AT LLOYD'S

Length between Perfs		260.0	258.6
Breadth Extreme		34.6	34.3
Depth of Hold to Upper Deck		23.9	24.102
Mains		15.11	17.93
Depths in Length to Main Deck		14.15 to Upper Deck	10.11
Breadth in Length		7 1/2 to 8 1/2	
N ^o for Regulating Frames & C		72.4	
Plating		18687	
Equipment		225.48	
Girth		37.4	
Depth		2m 10 1/2	
1/2 Breadth		17.1 1/2	
		79.4	
		73.4	

Rev 27/11/77

HA

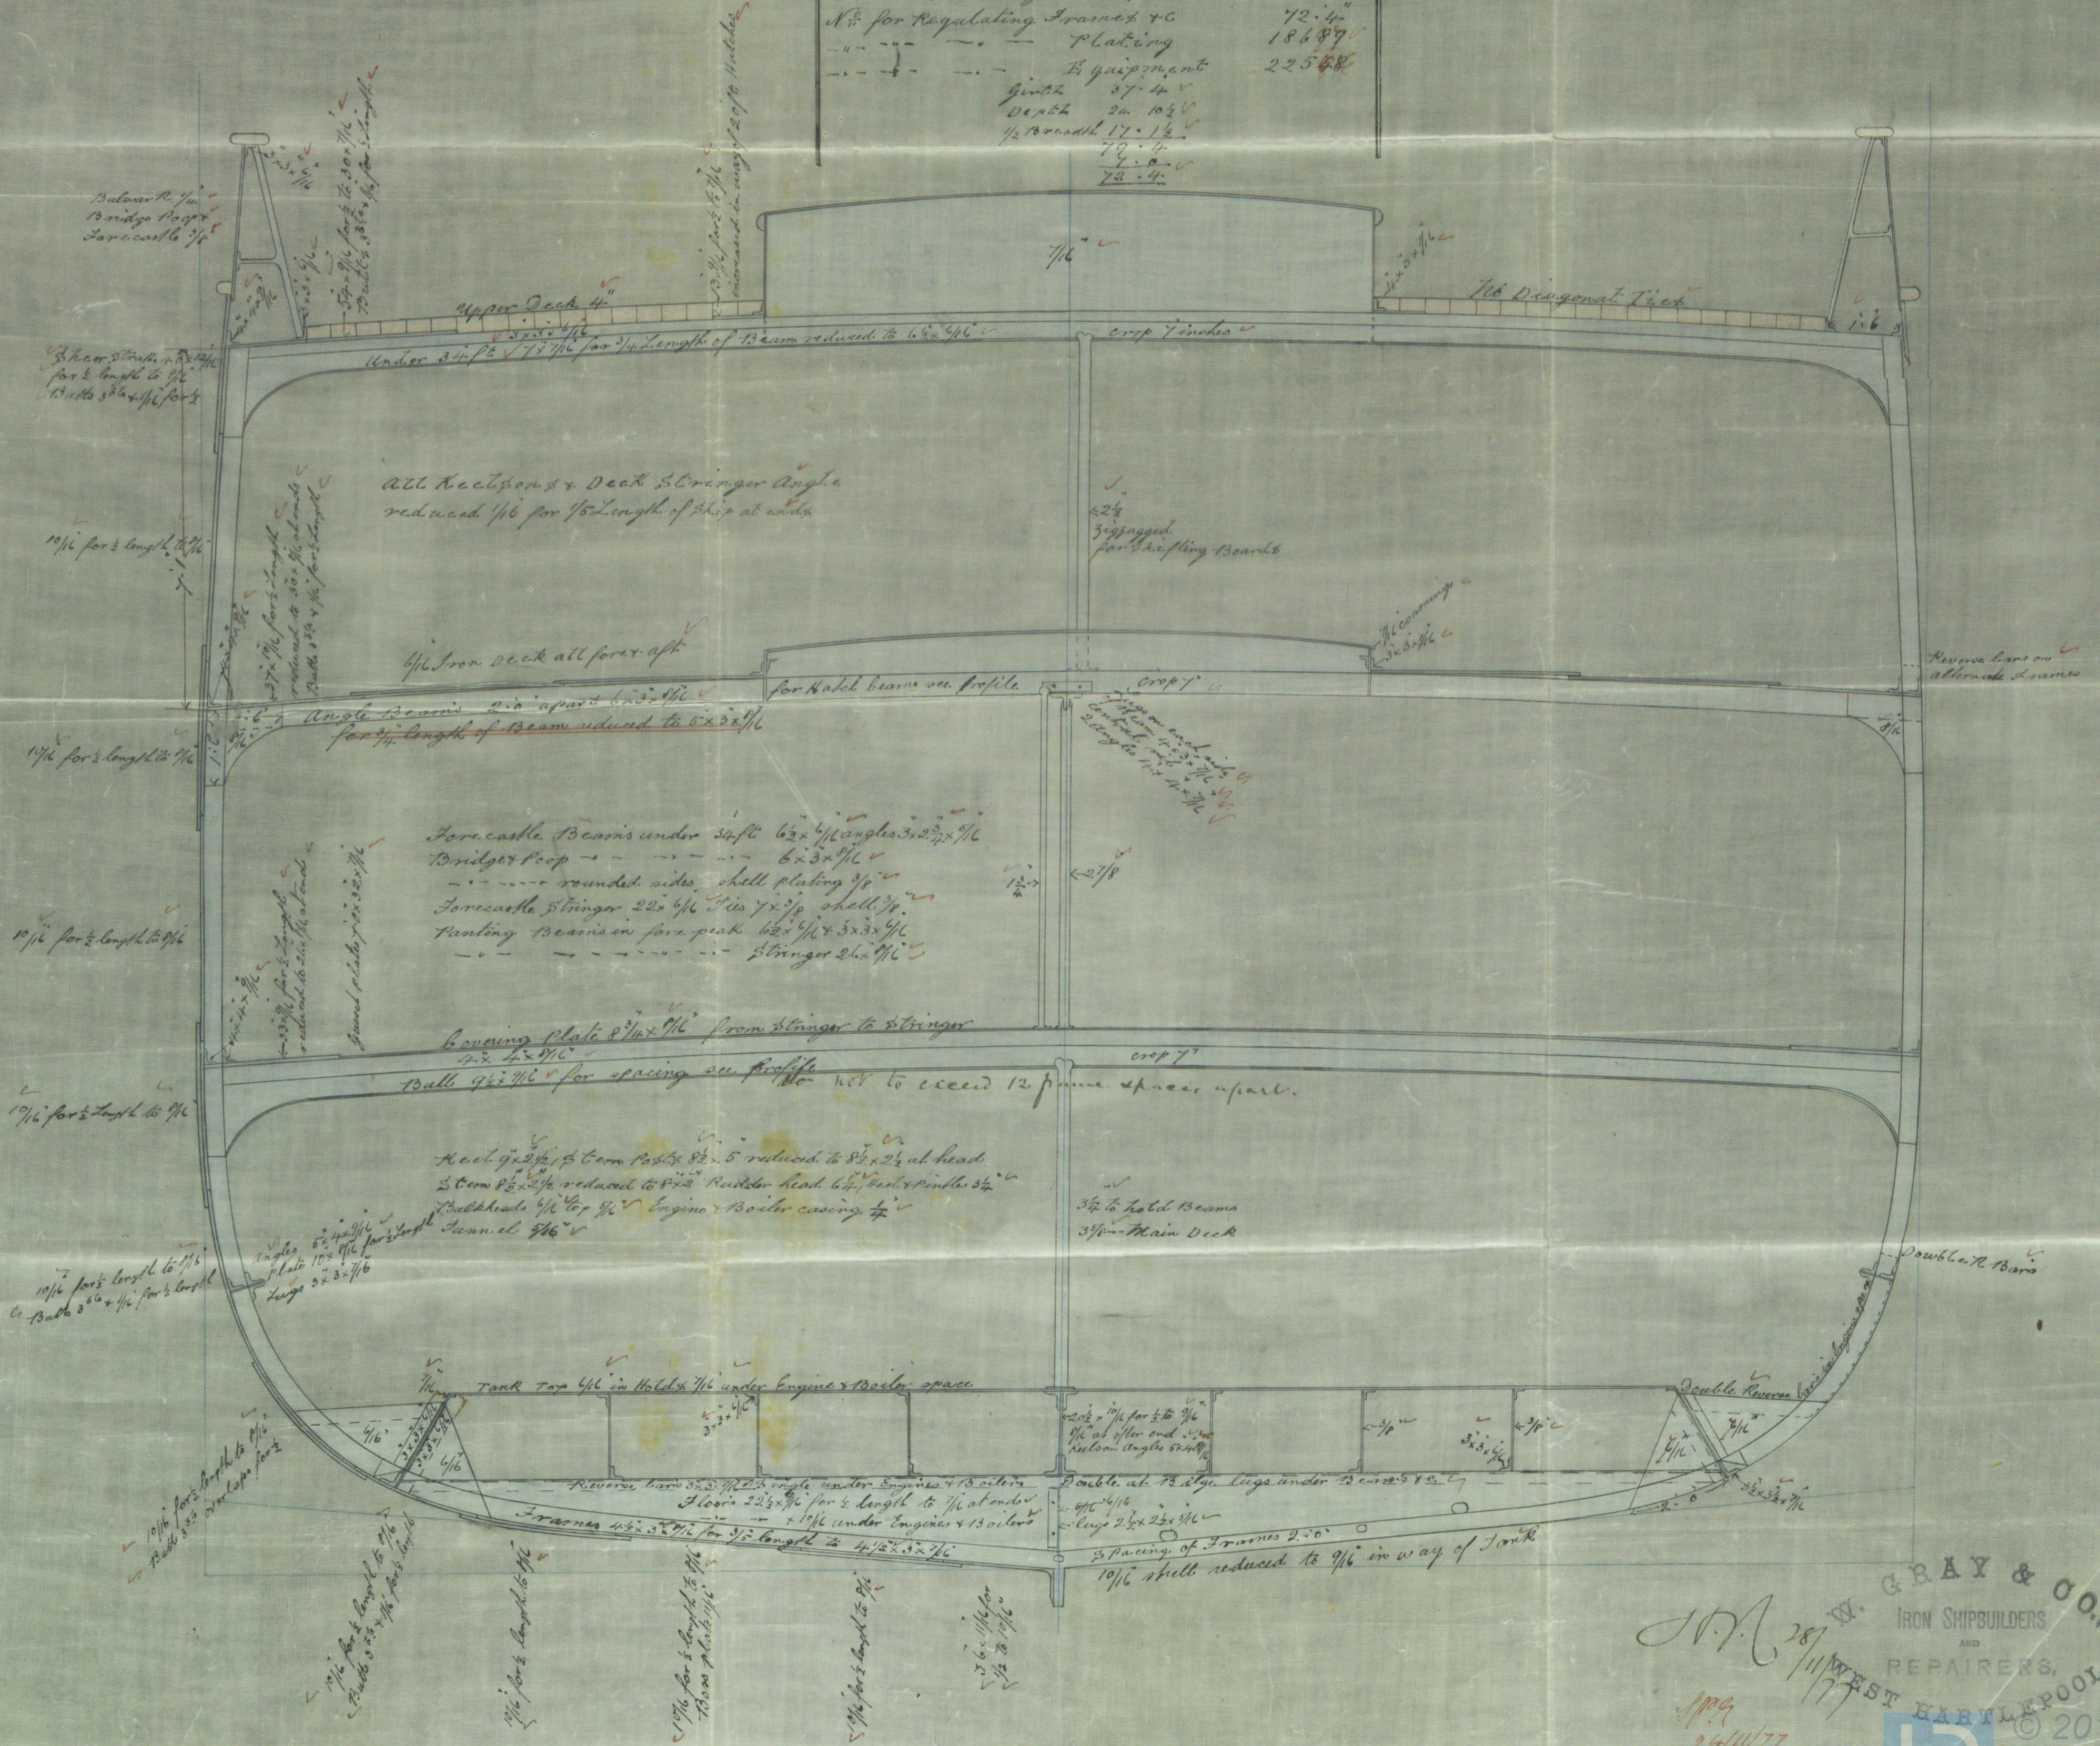

W. GRAY & CO.
IRON SHIPBUILDERS
AND
REPAIRERS,
WEST HARTLEPOOL

