

Shyts Stamp
22.9.79


copy

S. S. 'Rosetta'
N° 134
Proposed additional strengthening
in Engine & Boiler Space
Scale 1/4 in = 1 foot.

Ref. report N° 2703

18 Sep

1879

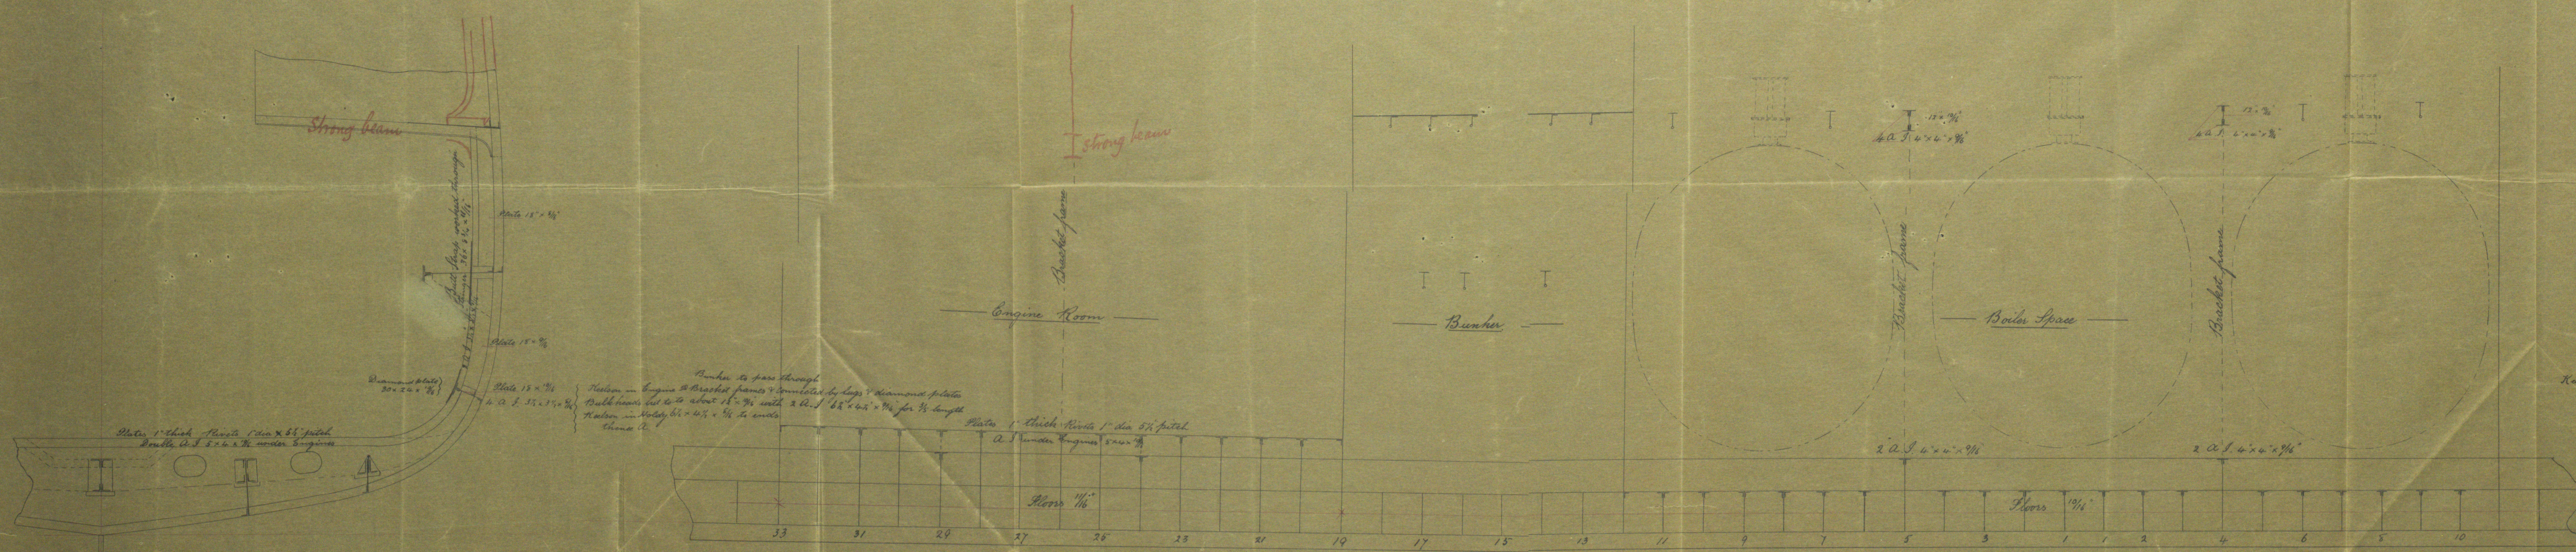


Section in Engine Room

copy
J.W.S.
20/9/79

Double Frames on deep floors and bracket frames

Elevation

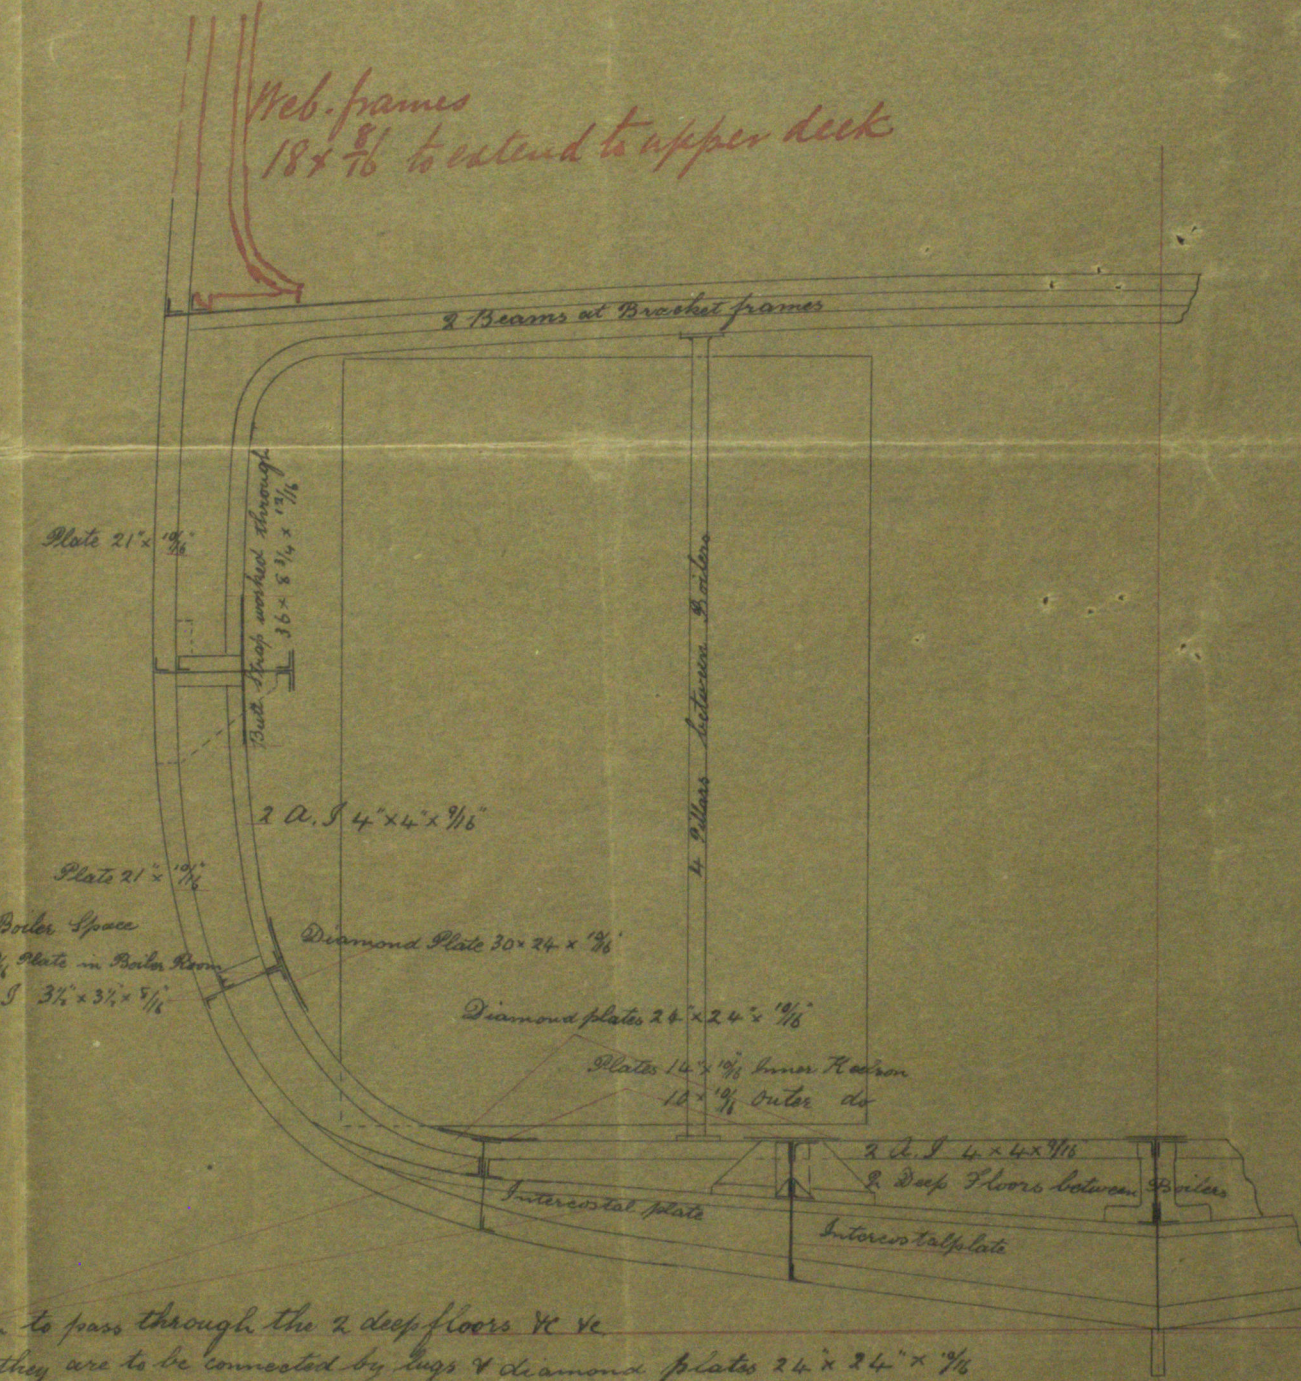

Section in Boiler Space

17/6
22/9/79

