


1742 Iron Lloyd Report N^o 13362

From Ship Simla 1444 Tons

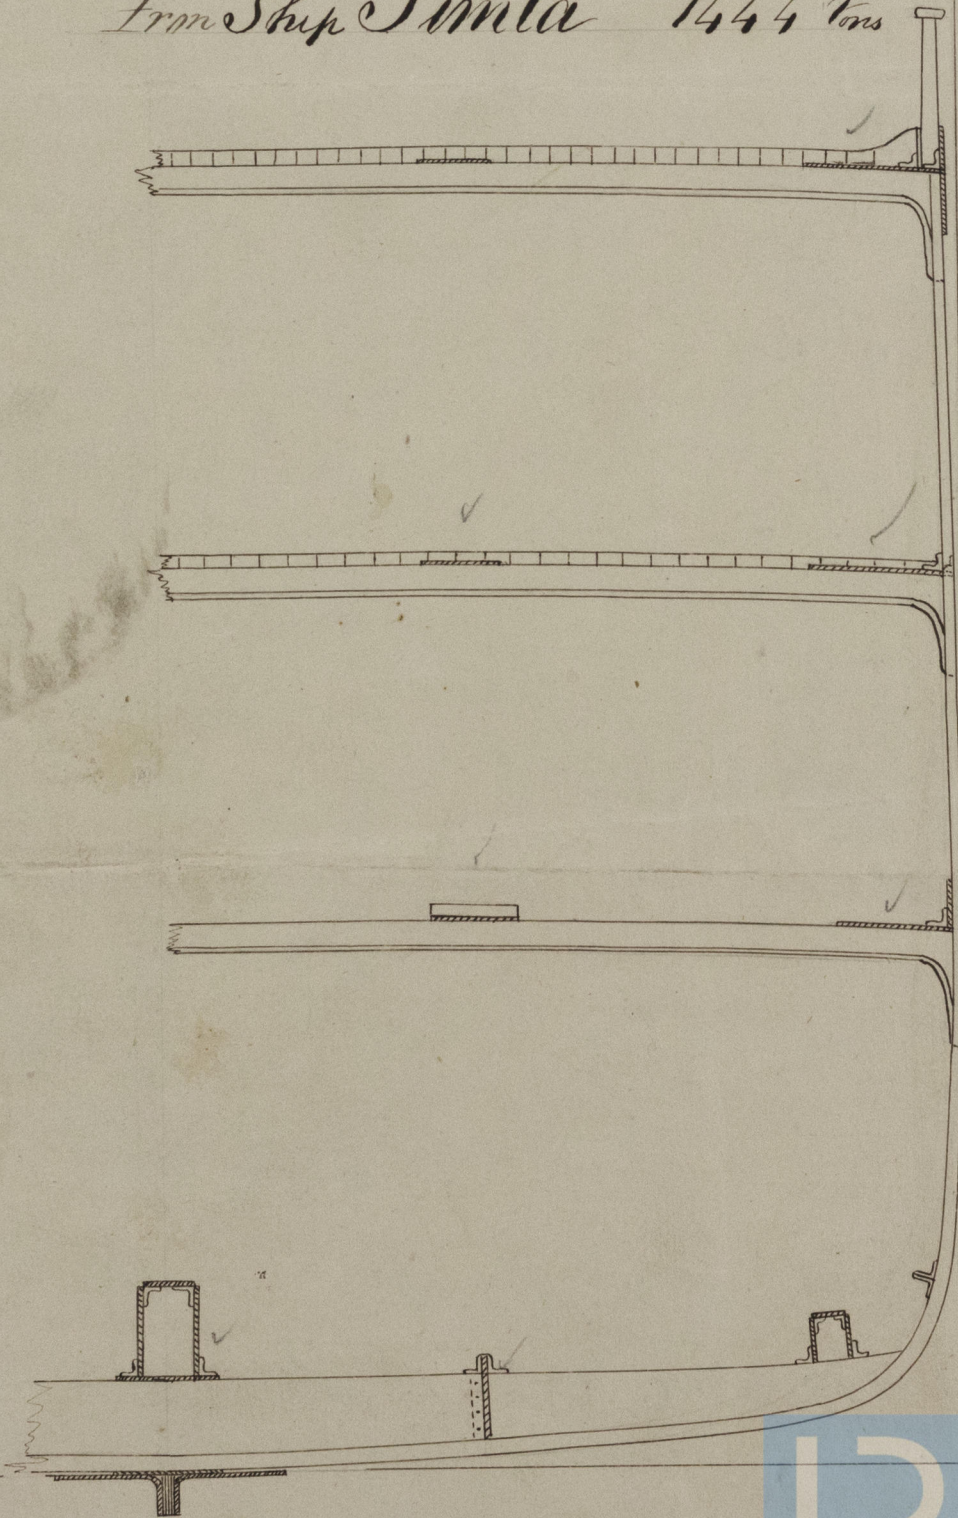

© 2021

Lloyd's Register
Foundation

IRON 498-0051