Present Poop 97 feet in Lengths — Proposed total Length 184 feet.

Rec 9/3/78

11.3.78

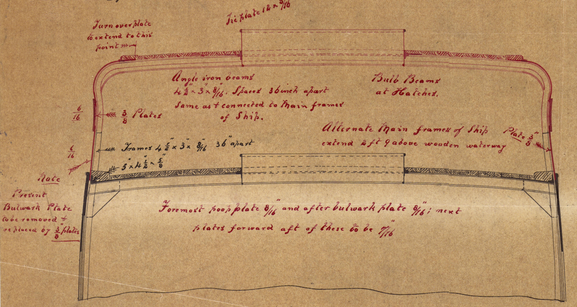

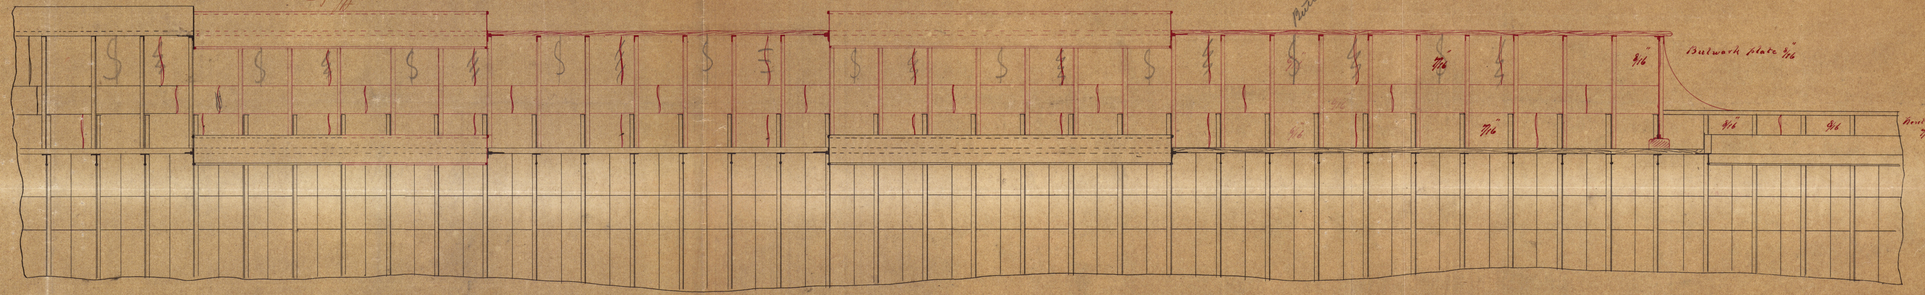

MESSRS BAILEY & LEETHAM
ENGINEERS.
HUMBER IRON WORKS
HULL.

ARRANGEMENT OF LENGTHENED POOP.
S.S. "DON ANTONIA".

New Hope

SCALE.— ½ INCH TO 1 FOOT.

© 2021 Lloyd's Register Foundation

IRON493-0073