

Palmer Bros & Co
Newcastle




MIDSHIP SECTION

Nº 117

Scale $\frac{1}{2}$ inch = One foot

Length between perpendiculars 186' 0"
Beam 27' 0"

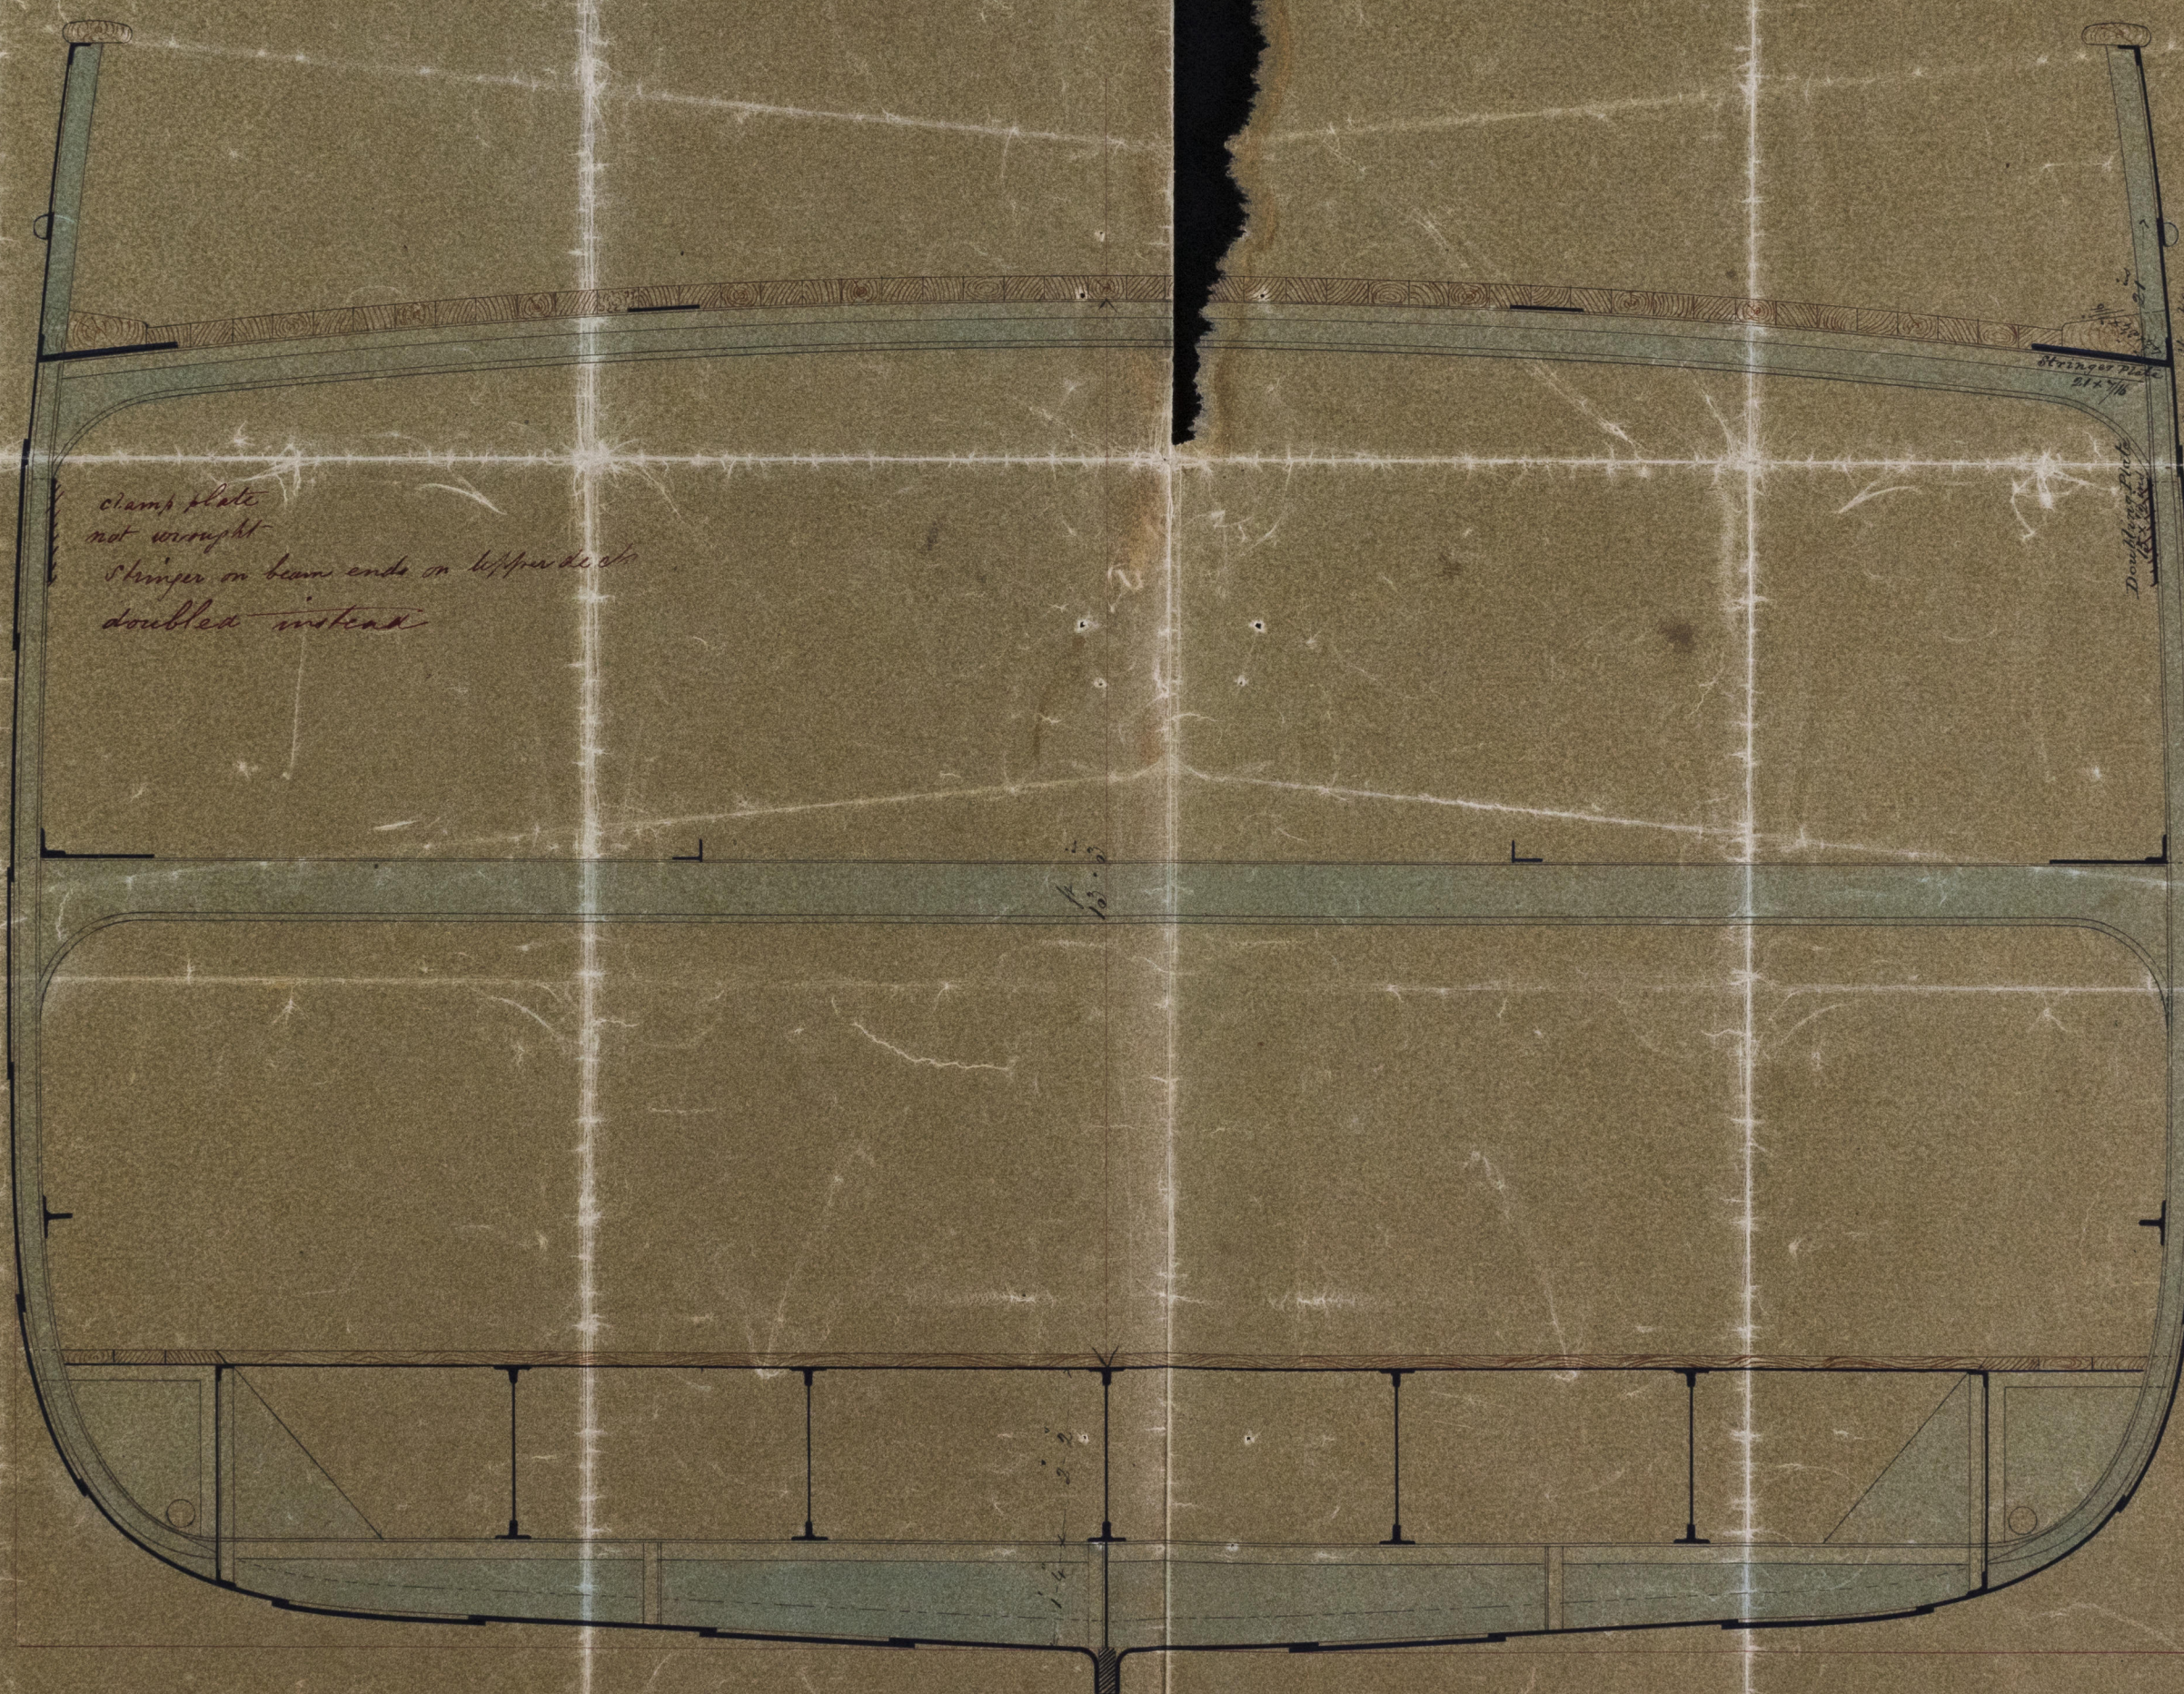

© 2021

Lloyd's Register
Foundation

IRON 498-0164