



# MIDSHIP SECTION

N<sup>os</sup> 194 and 195

2/12/85

No 194 "Swanmore" J.B.K.  
Belfast Report  
No 3240

SAILING SHIP 256'-0" x 38'-0" x 23'-3" HOLD.

TO CLASS 100A1 AT LLOYDS

1884-5 RULES

SCALE  $\frac{1}{2}$ " = ONE FOOT.


## NUMERALS

19.0 + 25.5 + 39.1 = 83.6 FRAMING N<sup>o</sup>

83.6 x 254.5 = 21276 PLATING "

21276 + 1918 = 22694 EQUIPMENT "

6.69 BREADTHS, 9.98 DEPTHS.

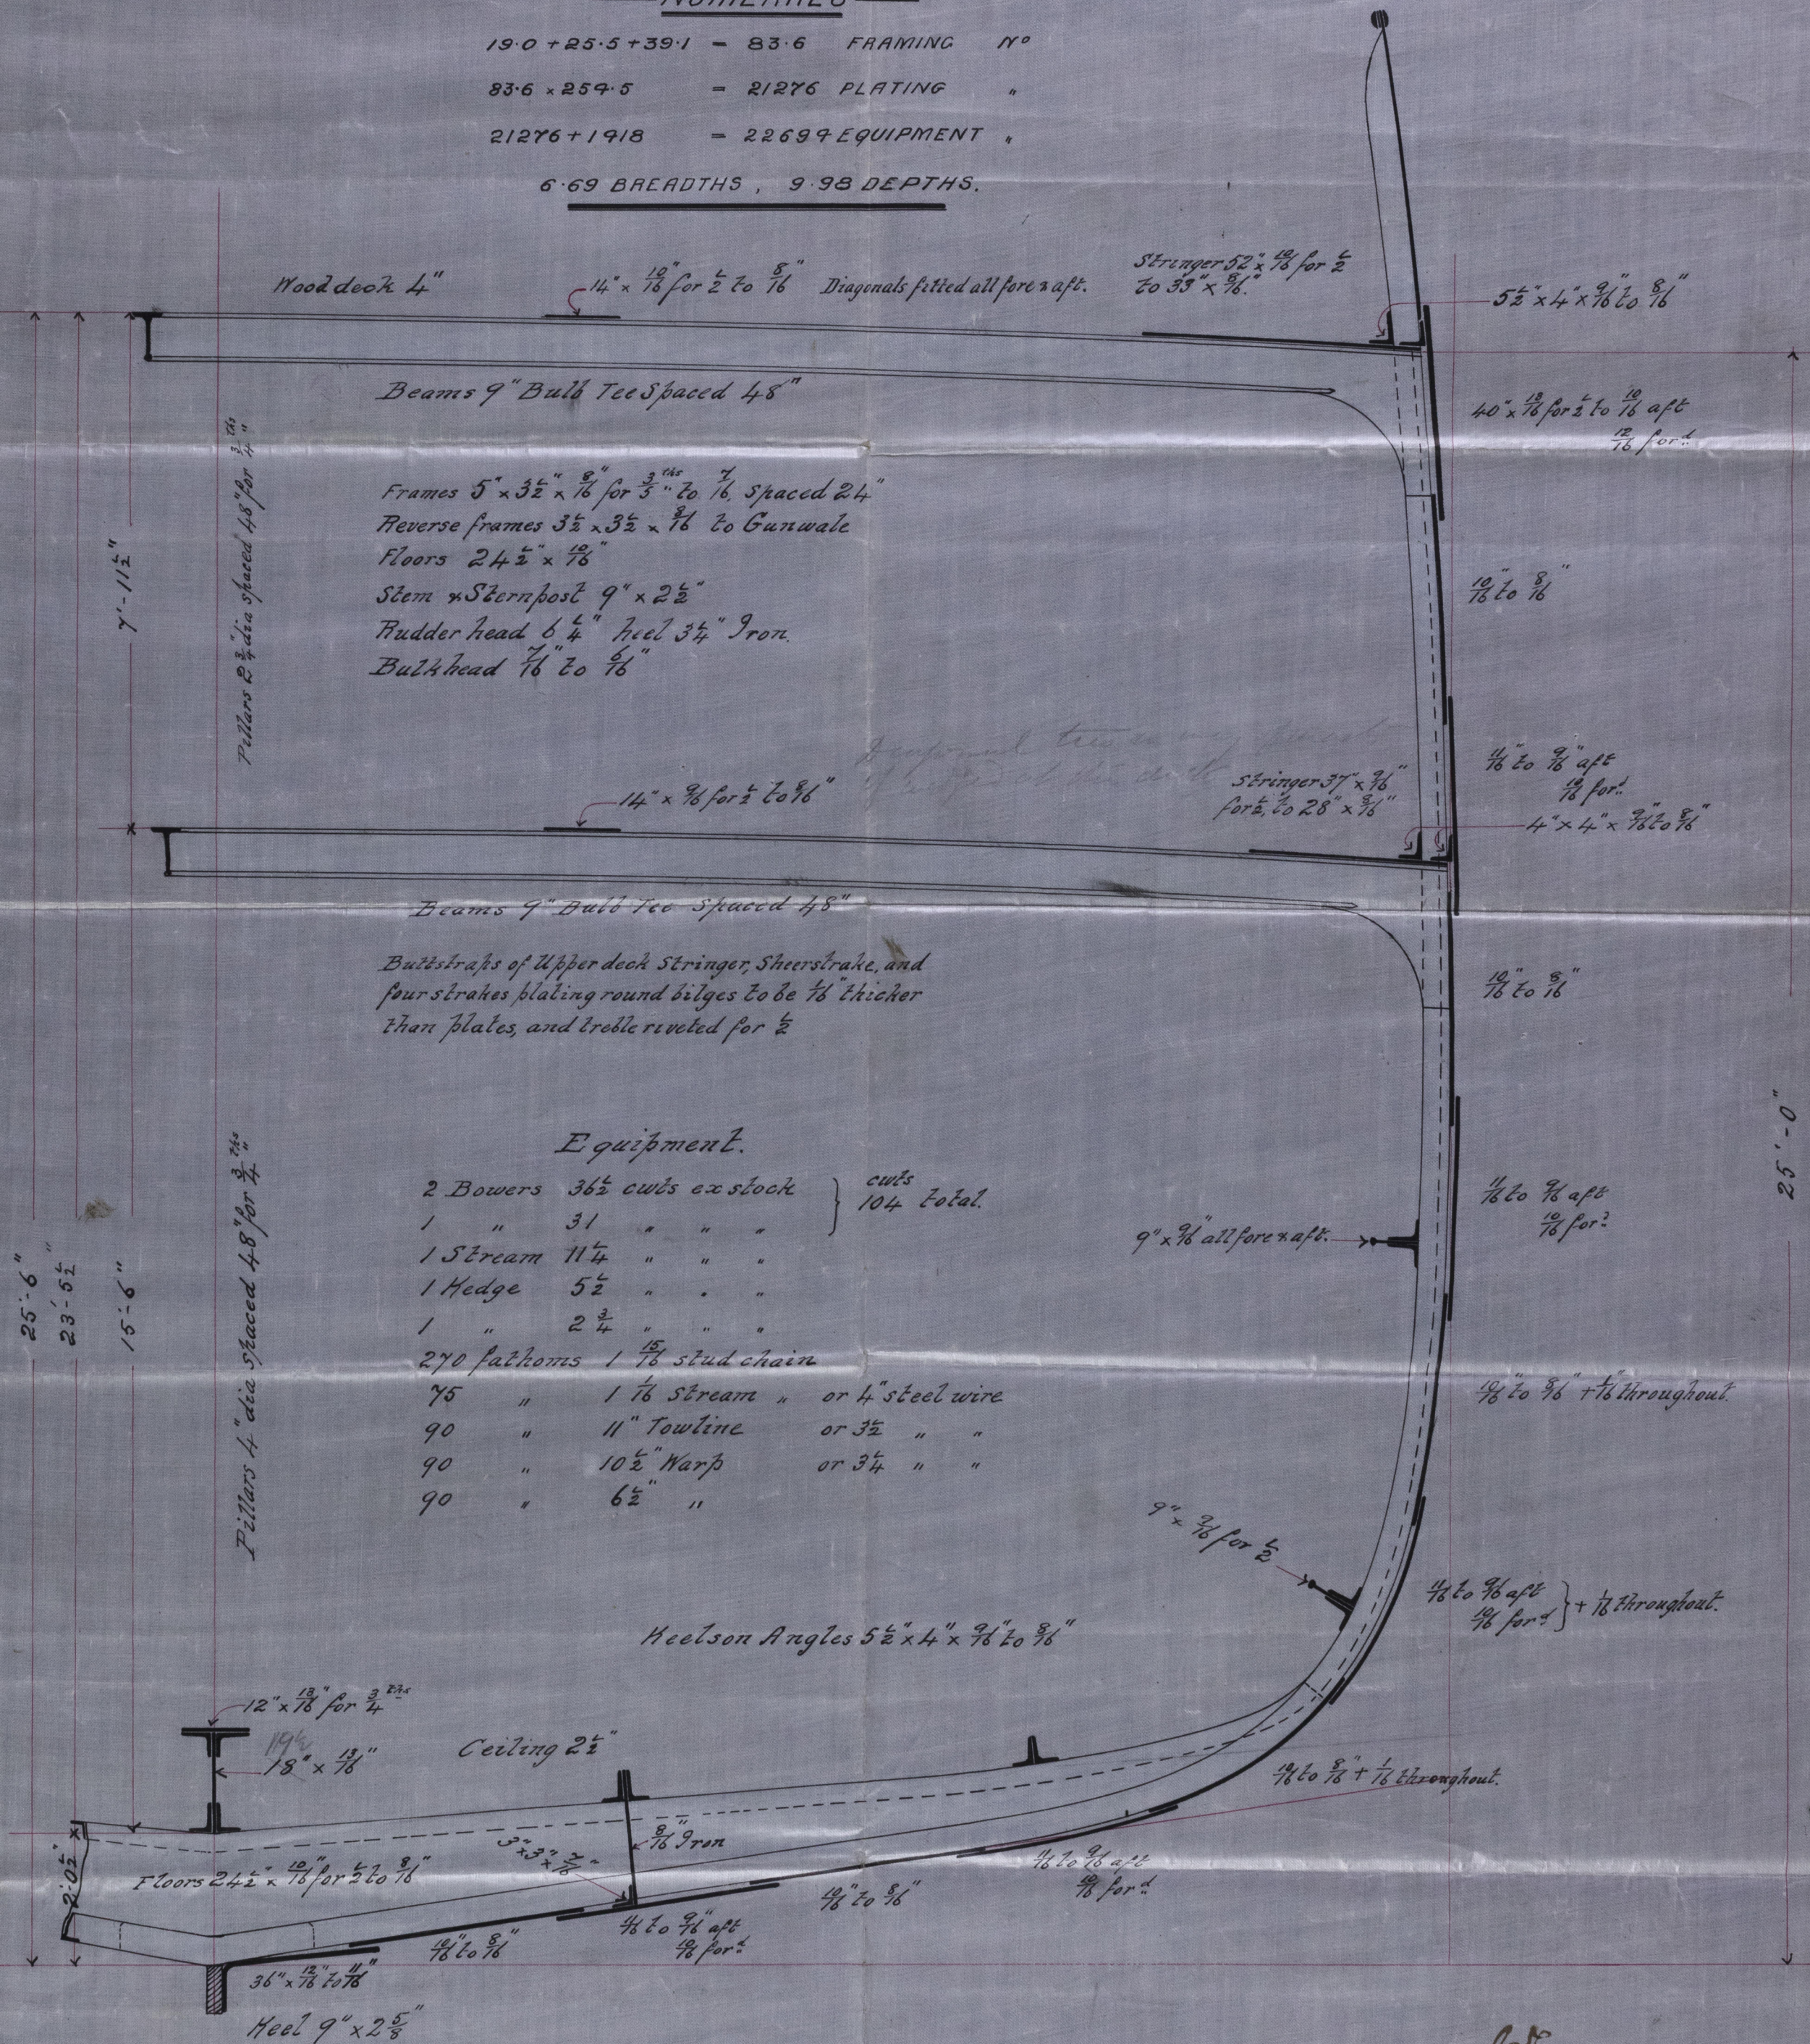

18m  
1/12/85

30.11.85



© 2021

Lloyd's Register Foundation

IRON 498-0261