


Almiers Shipbuilding & Iron Coy. Ltd.
Newcastle on Tyne

April 26th 1905

Midship section S.S. "Alexandra" Scale 1/2 inch = 1 foot.

3241

Shut. Strake 9/16
doubled from
Quarter deck to
Forecastle with 9/16
Plate

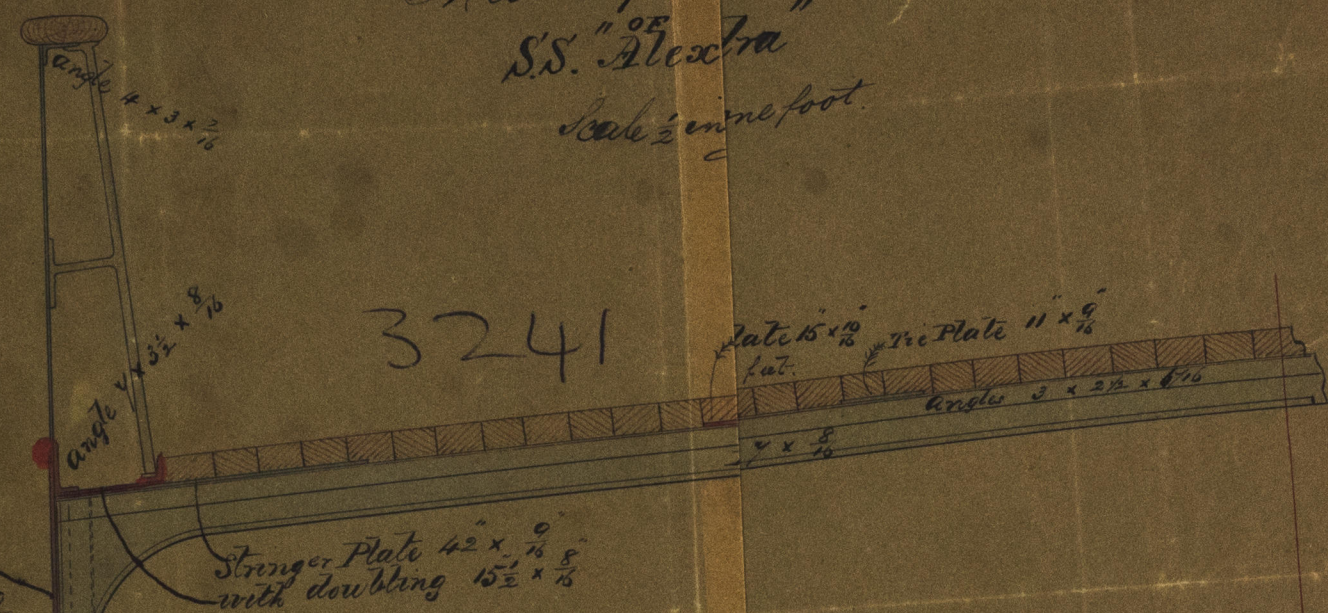

Principal dimensions.

Length between

252 " 0

1/2 full 3
Ball 1
Depth 1

Breadth extreme

30 " 0

Depth of hold

14 " 10 1/2

Numbers 64.5
11.054

1 1/2
3 2
1 2 9
1 6, 2



Note. Red ink denote additions



© 2021

Lloyd's Register
Foundation