

JOHN REID & CO


Ship Builders,

PORT GLASGOW

Rec^d 7/2/63

Scale $\frac{1}{2}$ inch = Foot

407 Tons 12 ft

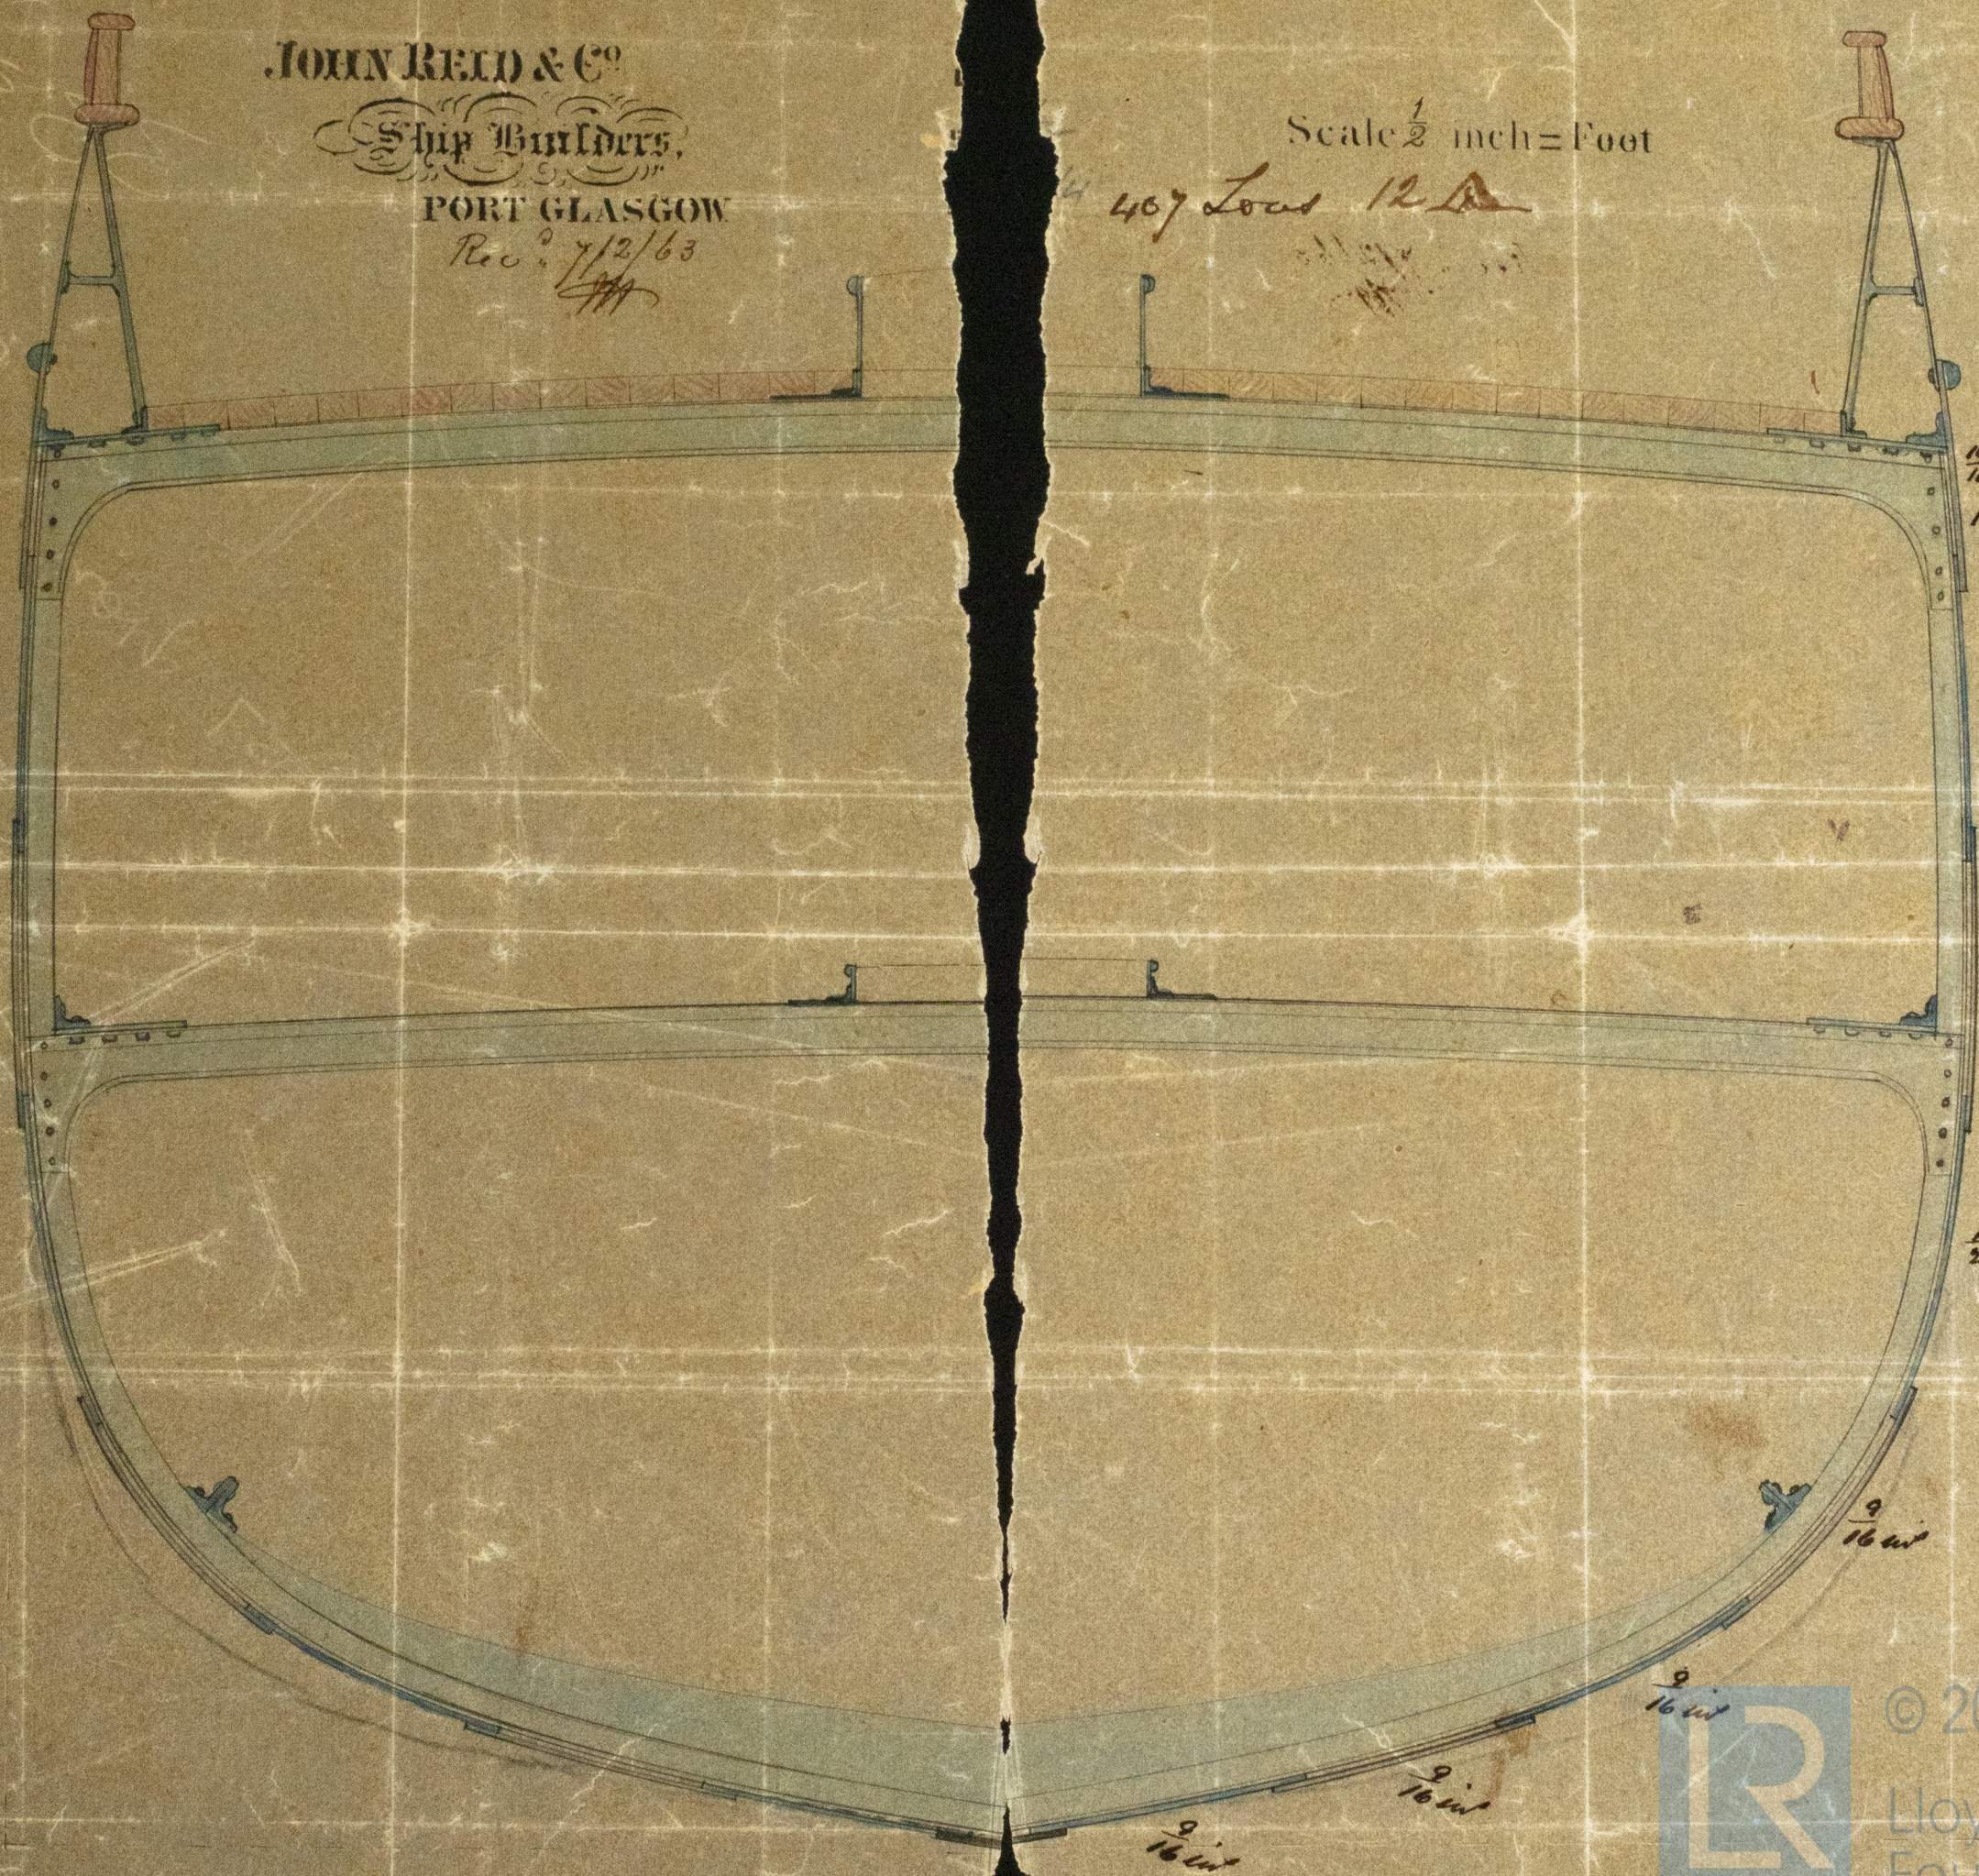

$\frac{10}{16}$ in thick for
120 ft. amidships

$\frac{1}{2}$ in

$\frac{1}{2}$ in

$\frac{1}{2}$ in

$\frac{9}{16}$ in

$\frac{9}{16}$ in

$\frac{9}{16}$ in

$\frac{9}{16}$ in



© 2021

Lloyd's Register
Foundation

IRON 498-0286