

IRON 498-0313-P(1/2)

Palmer Bros & Co
Newcastle

Rec 27/7/63

Midship Section Nos 139 & 140


Scale $\frac{1}{2}$ inch = One foot

3479. Jan.

about 1880

Rec 28/7/63

6x4x10/16 for 140/16

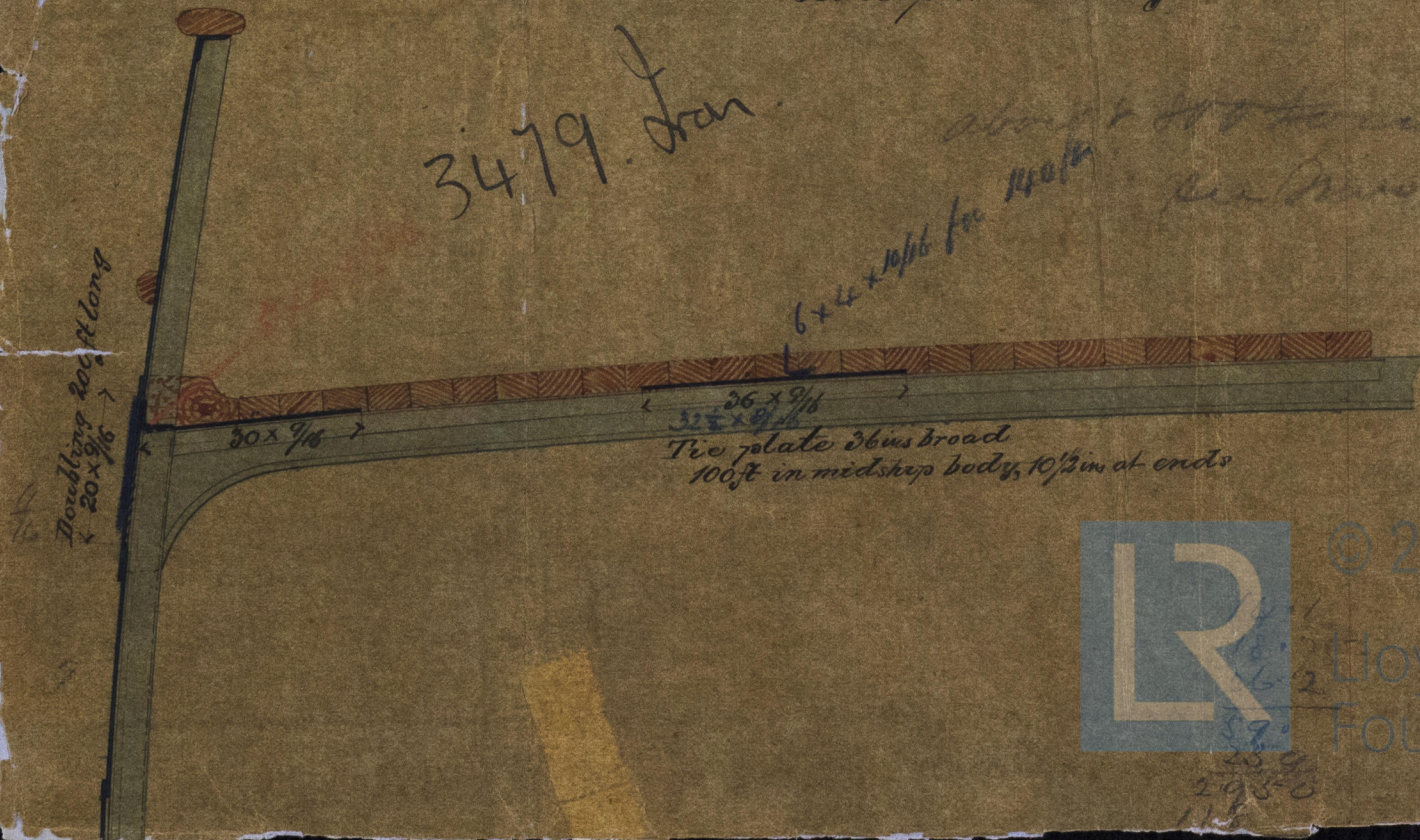

© 2021

Lloyd's Register
Foundation

over 18

28/7/63

259
298-0
115

62.8

147503

2853



Principal Dimensions

Length between perp ^s	250.0
Breadth	28.0
Depth	17.3

Inter

5 x 3 1/2 x 8/16

Inter

Plates 9/16 5 x 3 x 8/16
 3 1/2 x 3 1/2 3 x 3 x 7/16
 14 14 2 1/2

Plate 3 x 2 1/2 x 6

Plate 3 1/2 x 3 1/2




Lloyd's Register
 Foundation

IRON 498 - 0313 - P (2/2)

ick

As I am about to

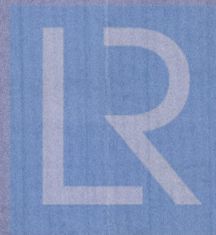

© 2021

Lloyd's Register
Foundation