

Received at Greenock 27<sup>th</sup> Nov 1863  
J 428



JOHN REID & CO  
Ship Builders.  
PORT GLASGOW

Rec 30/11/63

Old Length 185.5  
" Breadth 23.4  
" Depth 11.9  
" Gross 360 tons  
" Register 226 tons

New Length 206.5  
" Breadth 23.1  
" Depth 11.9  
" Gross (inclined) 400 tons

Ship "Susitaneu"

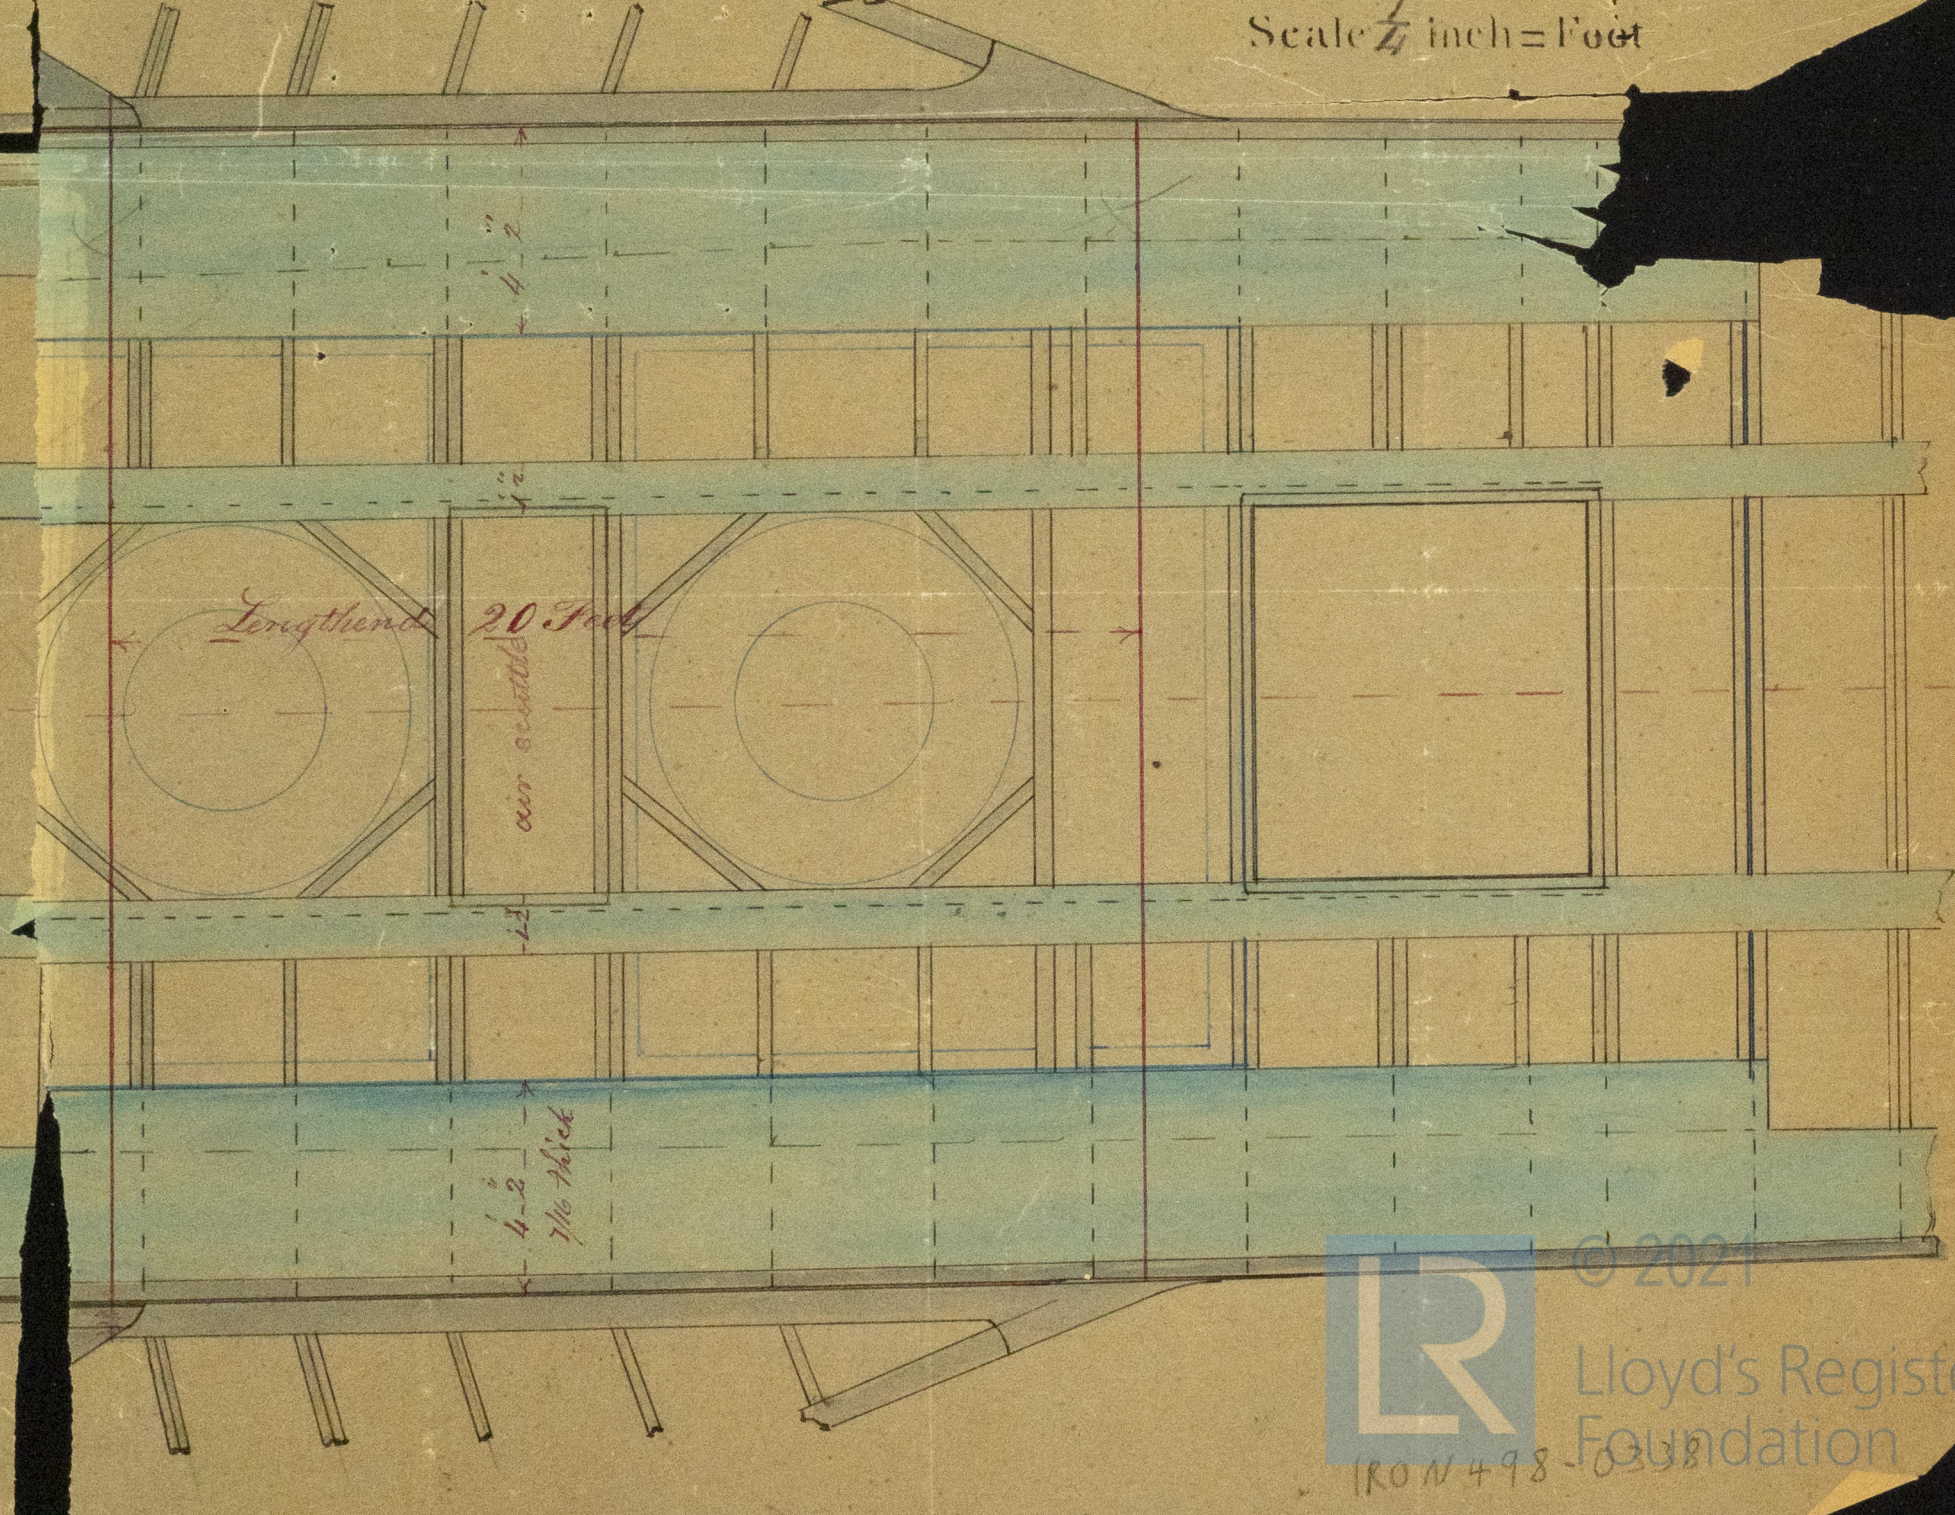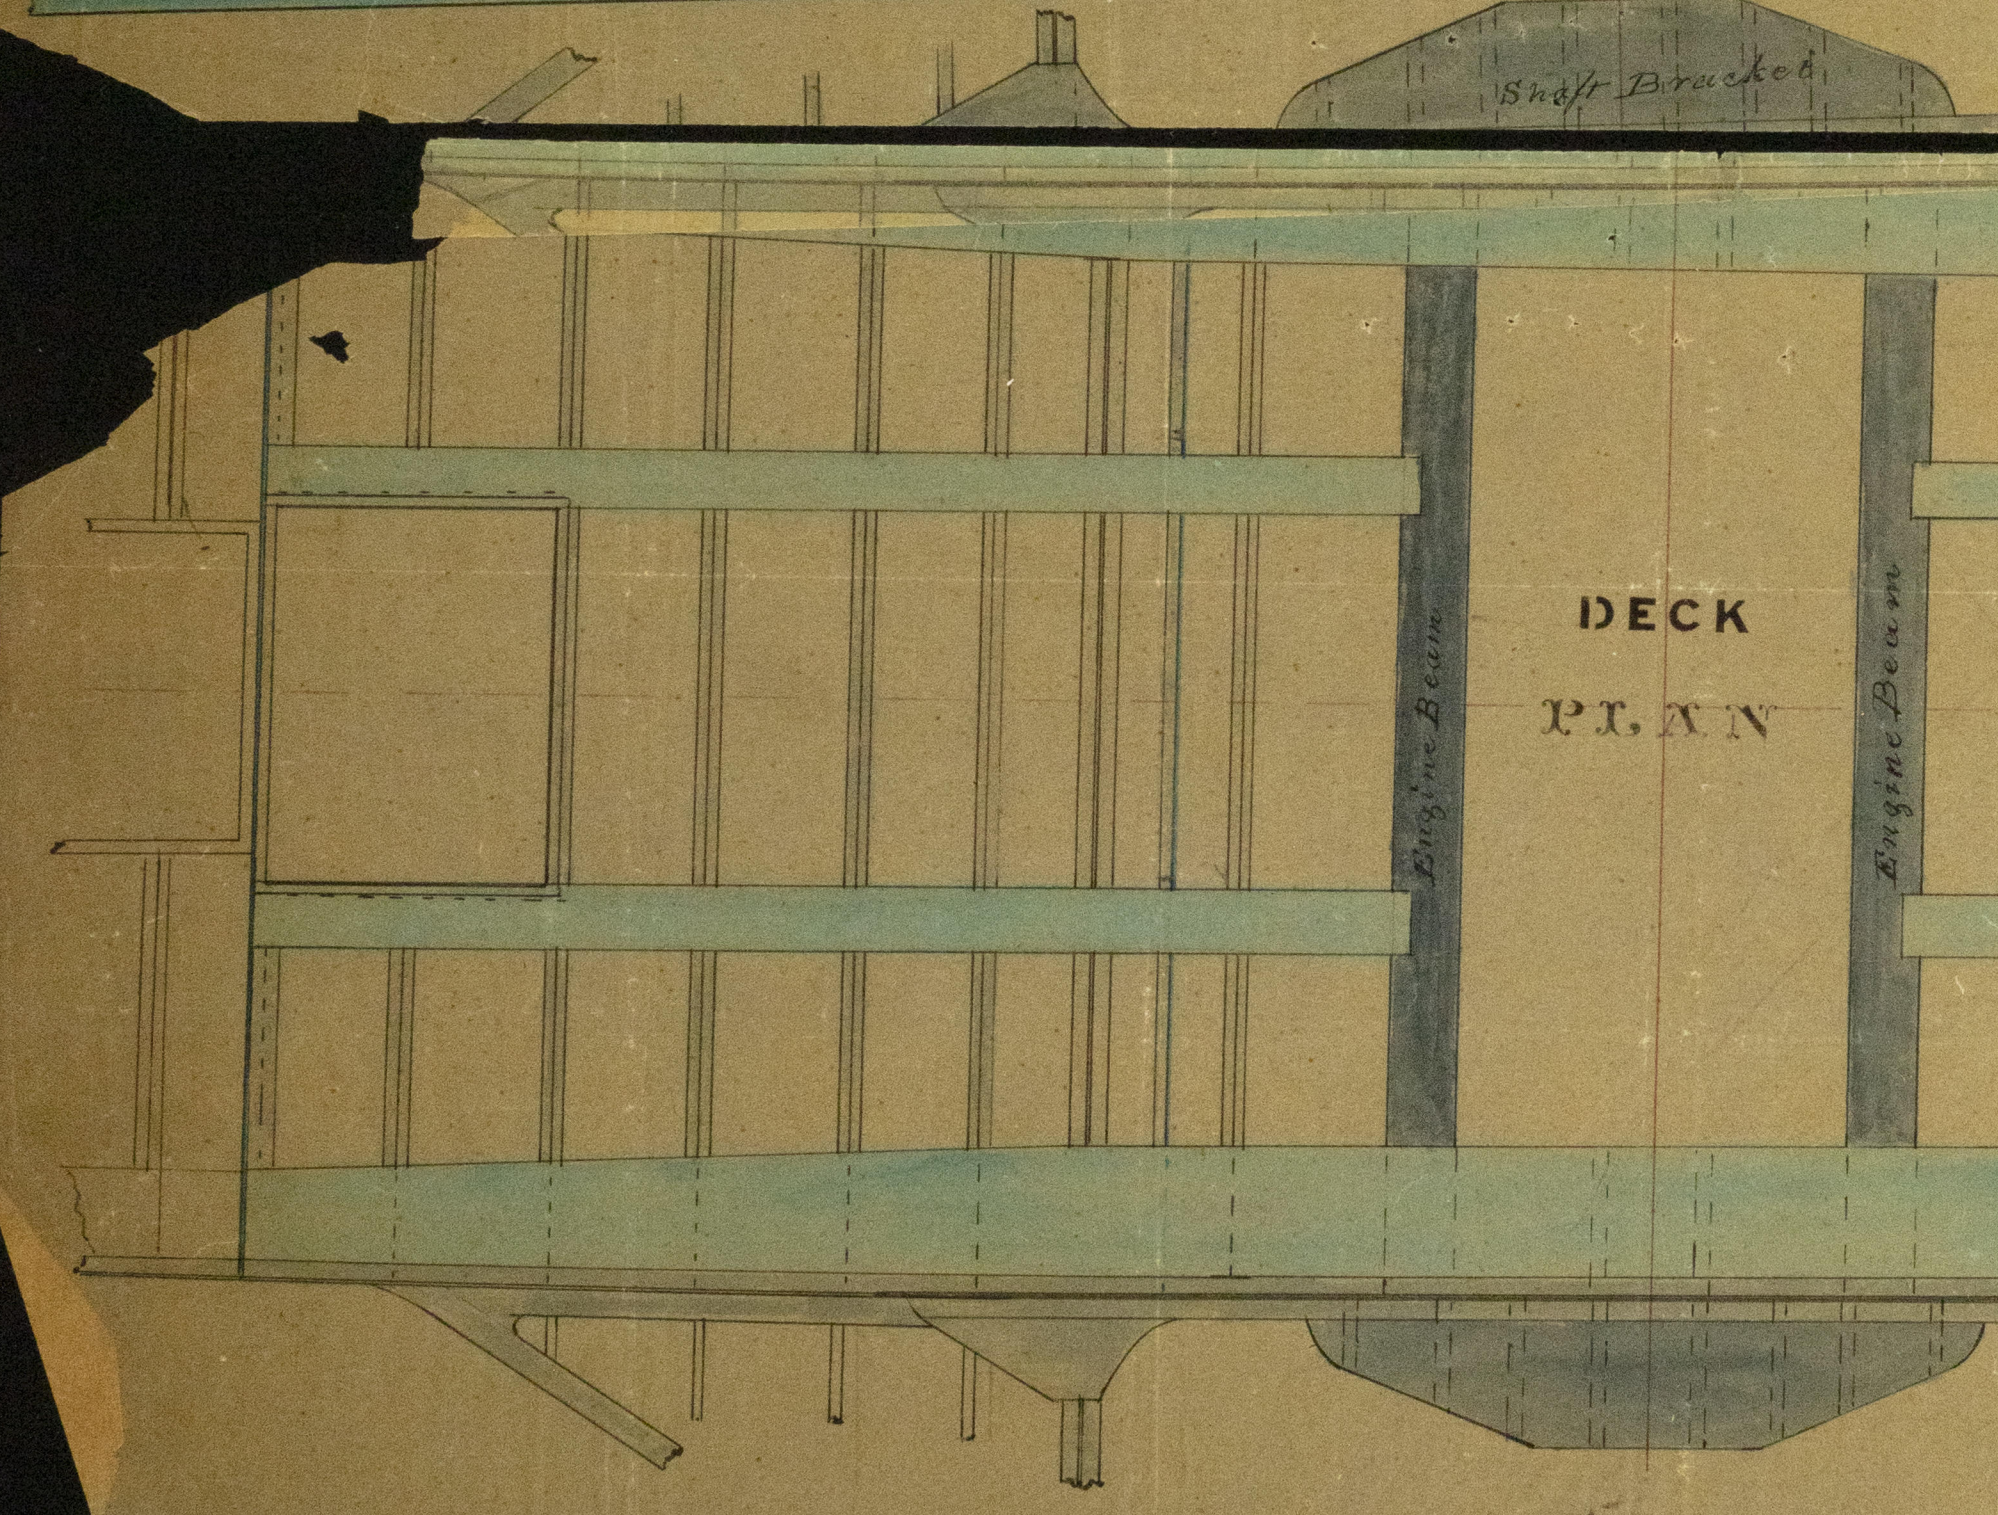

Scale 1/4 inch = Foot