


SCALE 1/2 INCH TO A FOOT

Nov 5888

Notes 6' x 3"

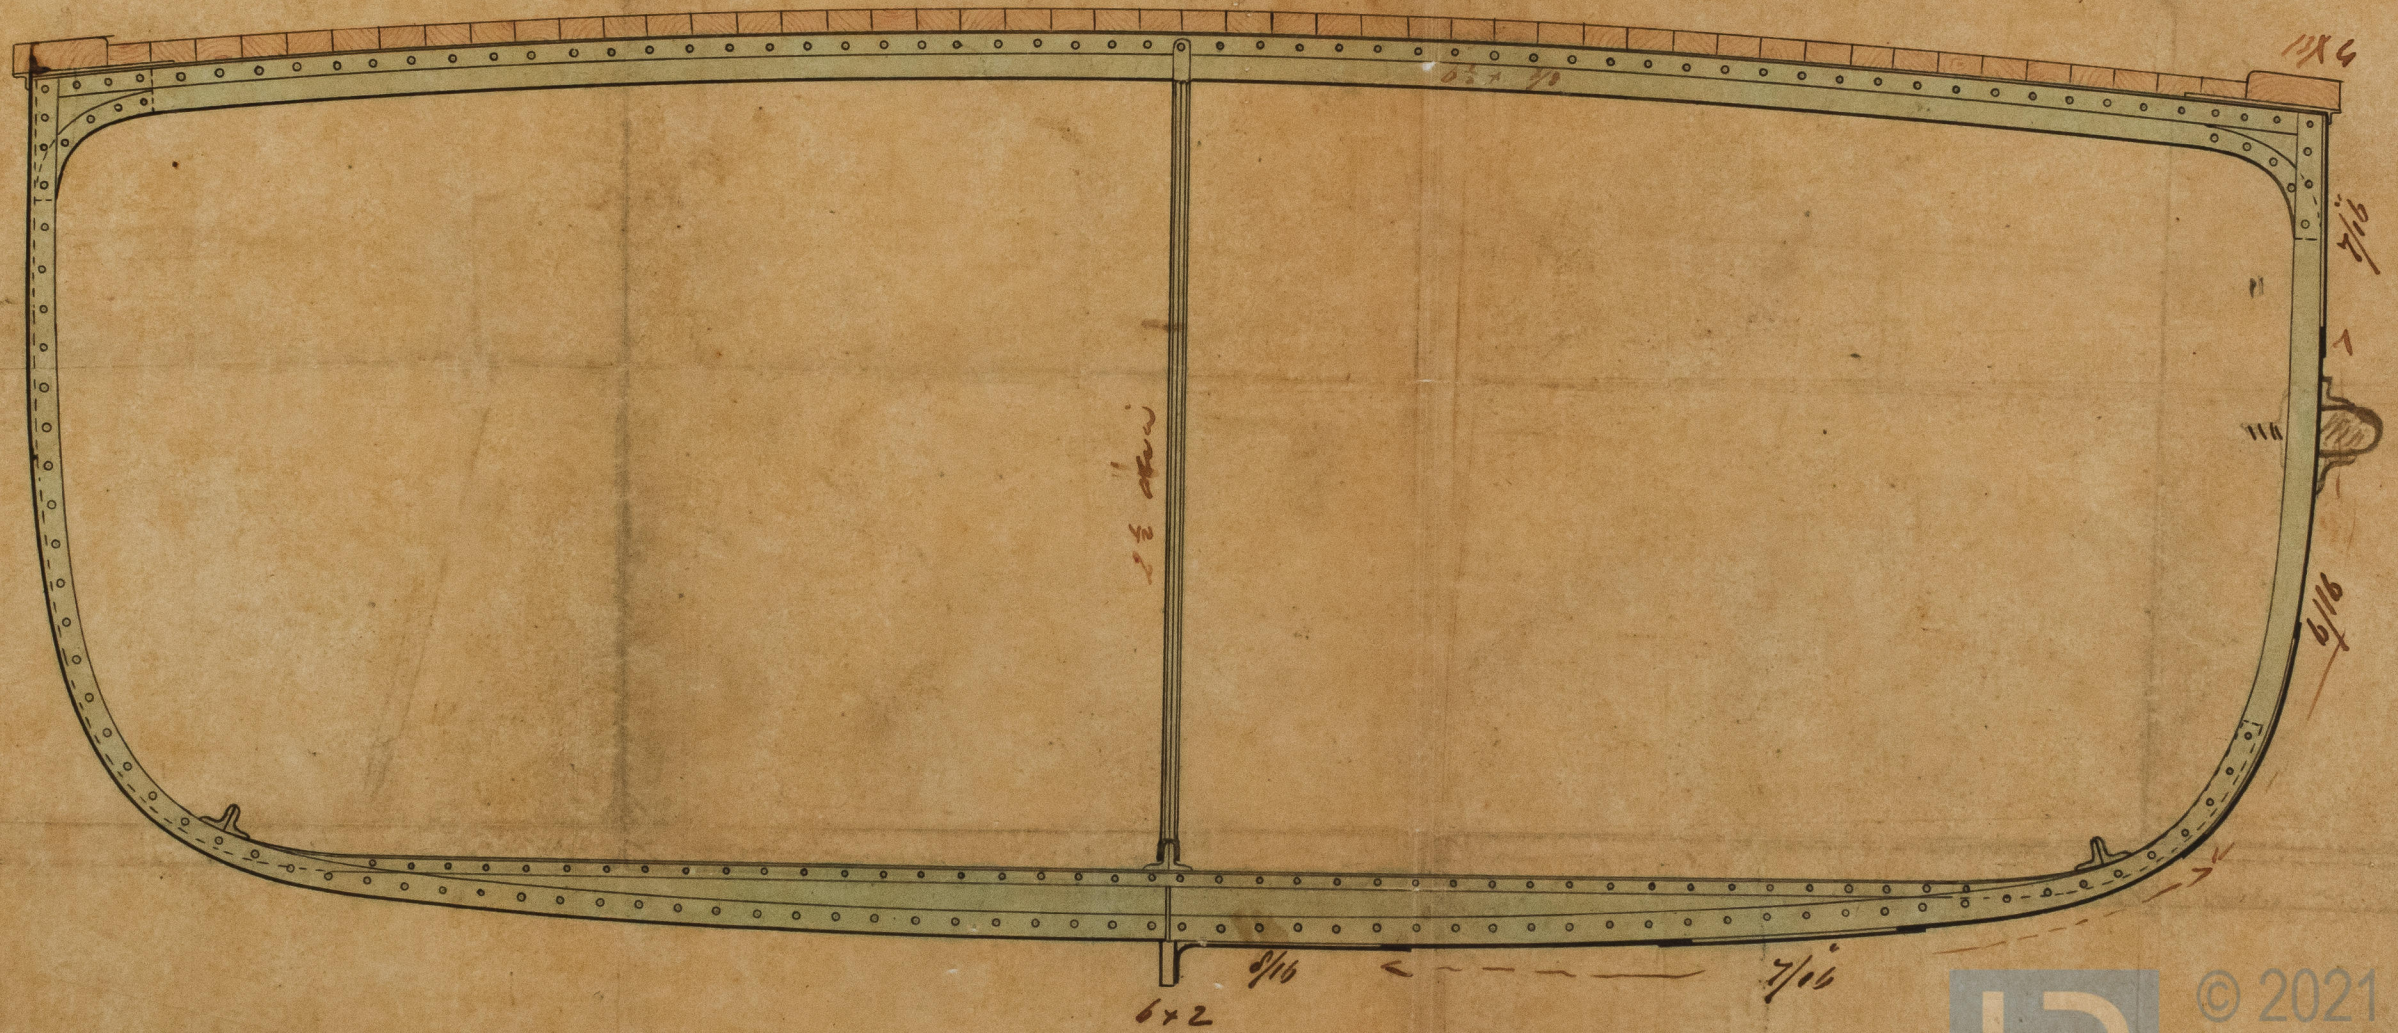

© 2021


Lloyd's Register
Foundation

IRON 498-0347

3582. Iron.

SCALE 1/8 INCH TO FOOT

IRON 498-0847

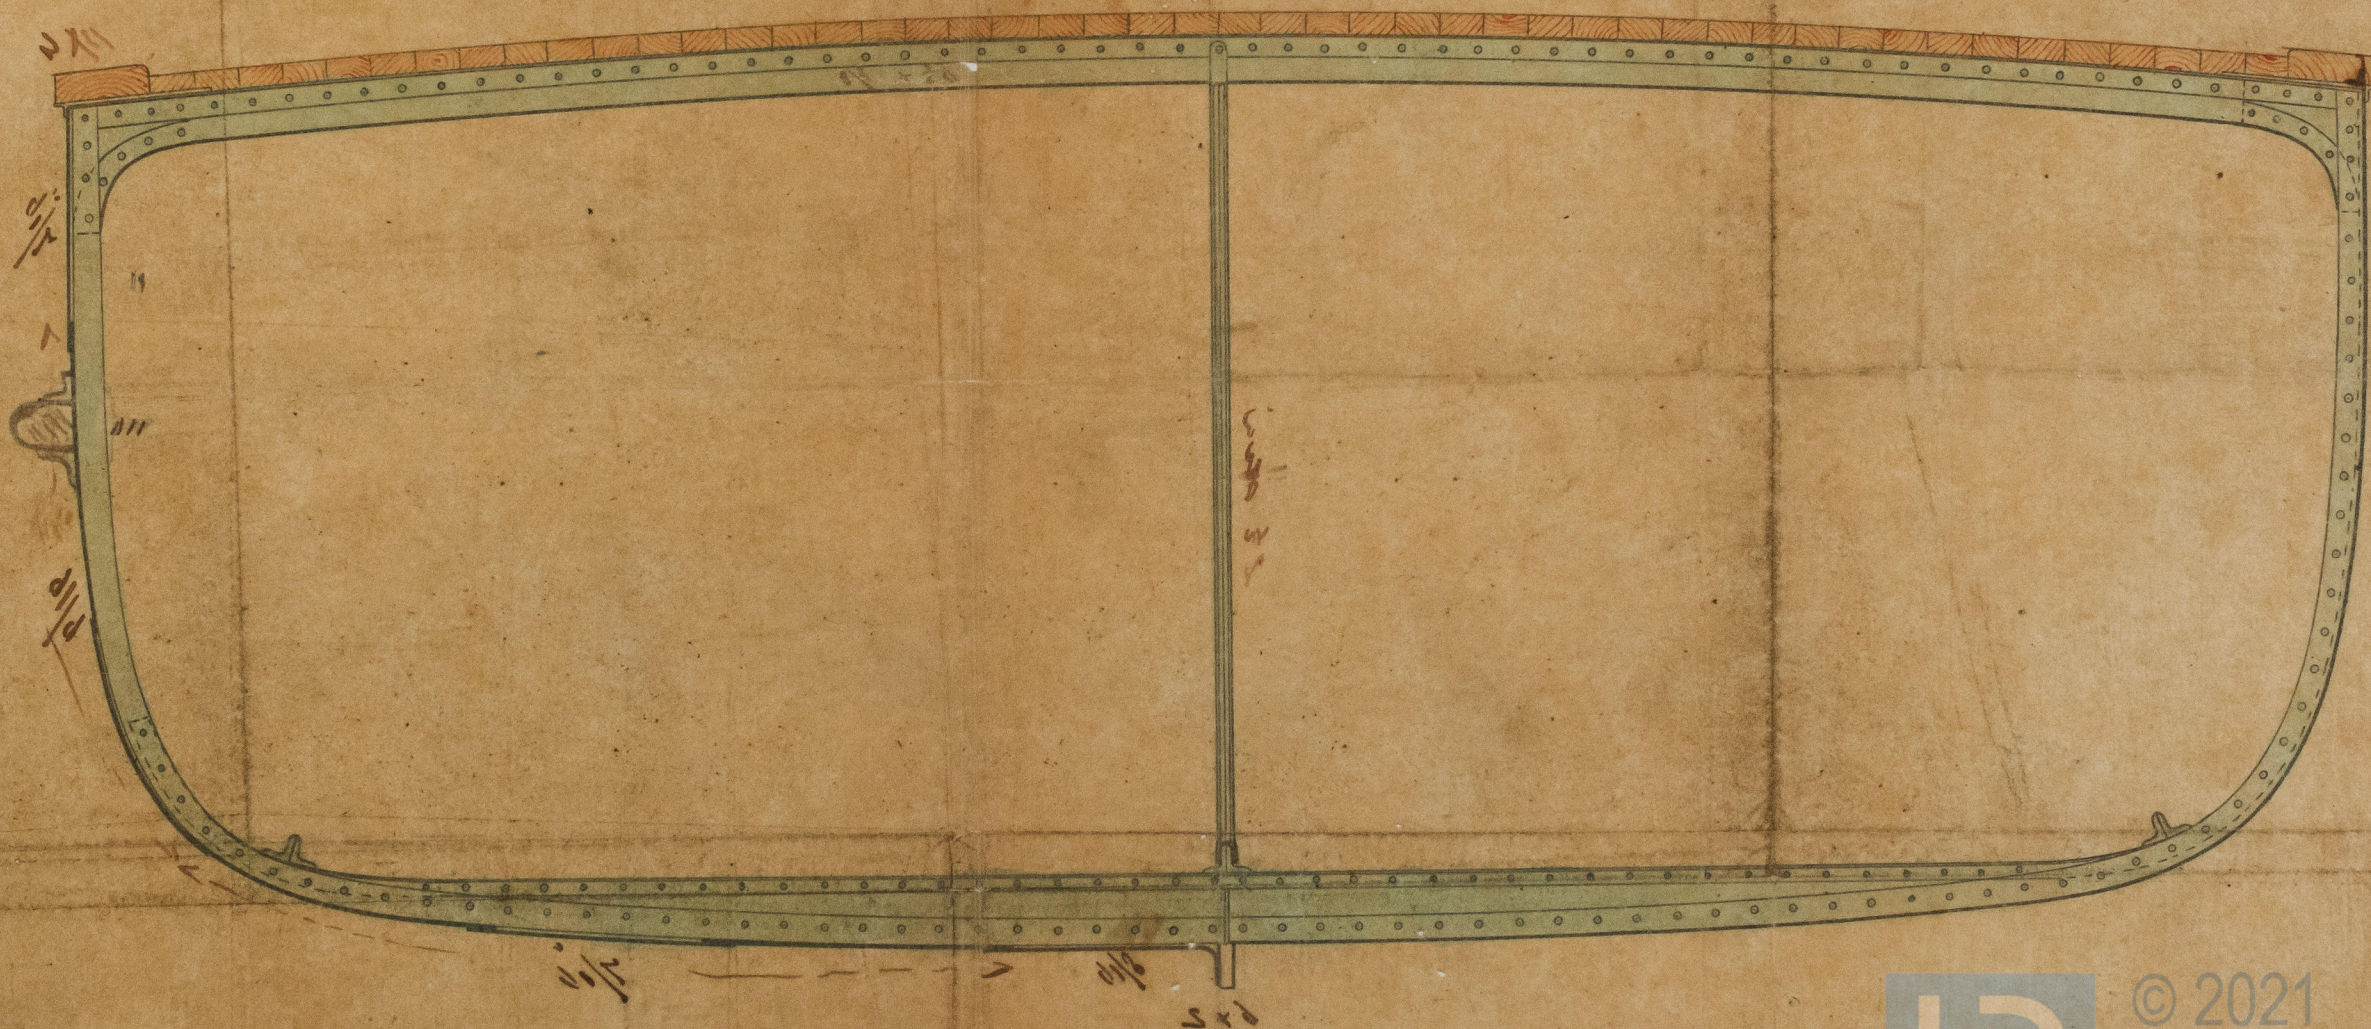

© 2021

Lloyd's Register
Foundation