


Section through Engine Seat
 Showing Arrangement of Engine Ribs and Stringers
 Main Rib and Paddle Beam

Scale 1/4 inch = 1 Foot

Recd from Mr Robinson of Cork
 21/3/64 & from Cork Surveyors
 2/4/64 & 15/4/64



Section through Boiler Seat
 Showing Arrangement of Ribs and Stringers

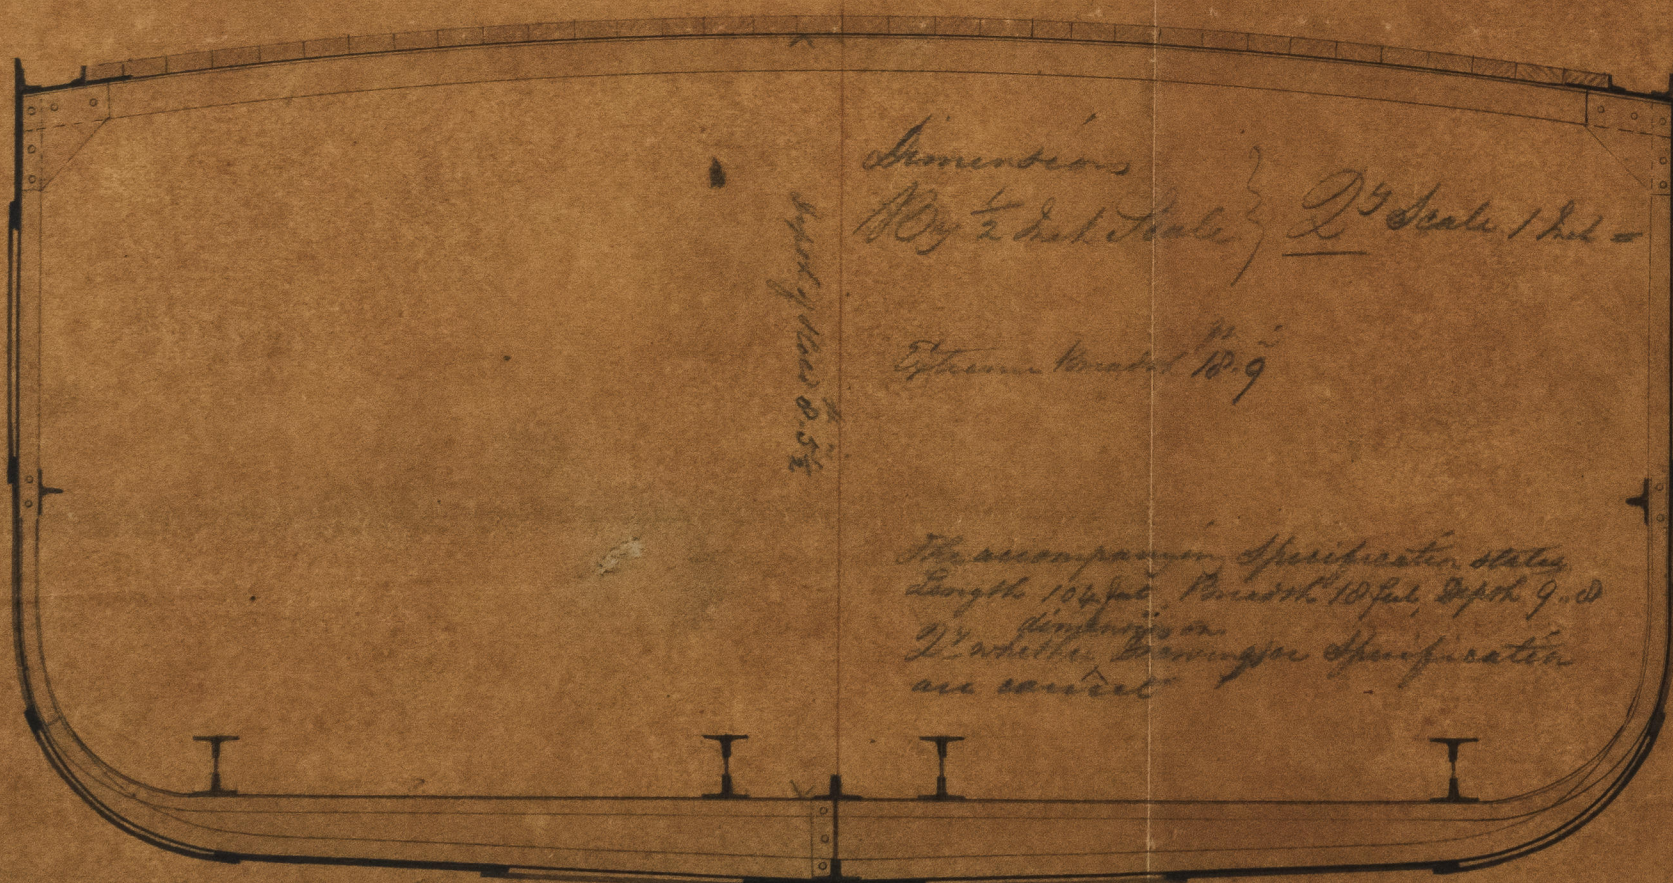

Dimensions
 By 1/2 inch Scale } 2 1/2 inch Scale 1 inch = 1 Foot as stated above



The accompanying Specification states



© 2021
 Lloyd's Register
 Foundation

IRON 499-0009

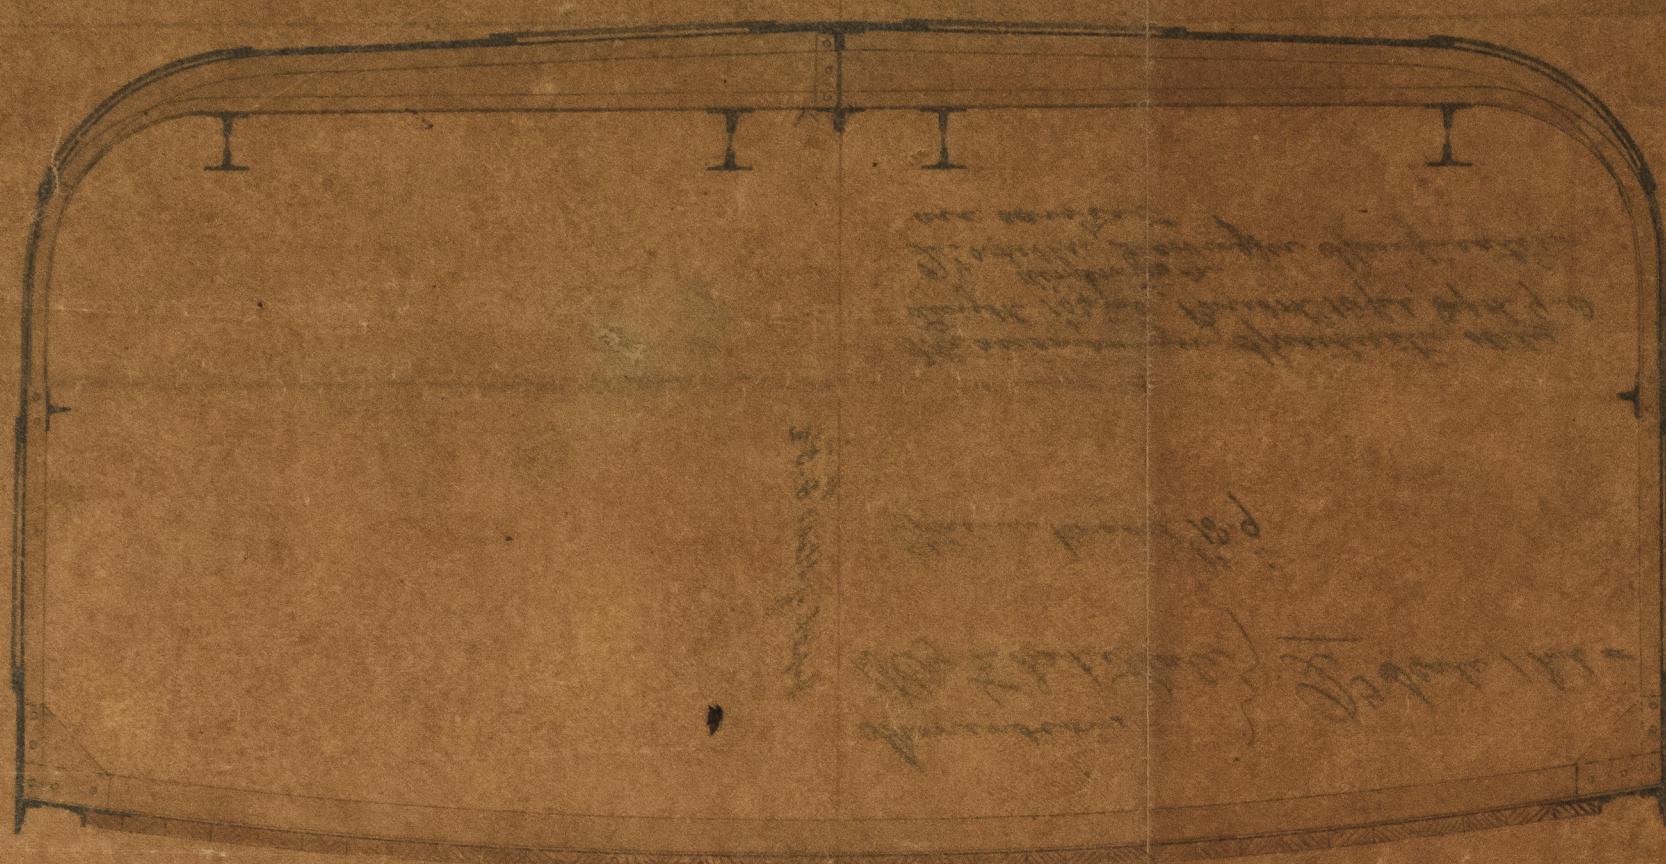





