


Midship Section of ~~the ship of 1400 tons~~ the Ship "Am. Earns"
Scale $\frac{1}{2}$ inch = One Foot 14.22 Tons.



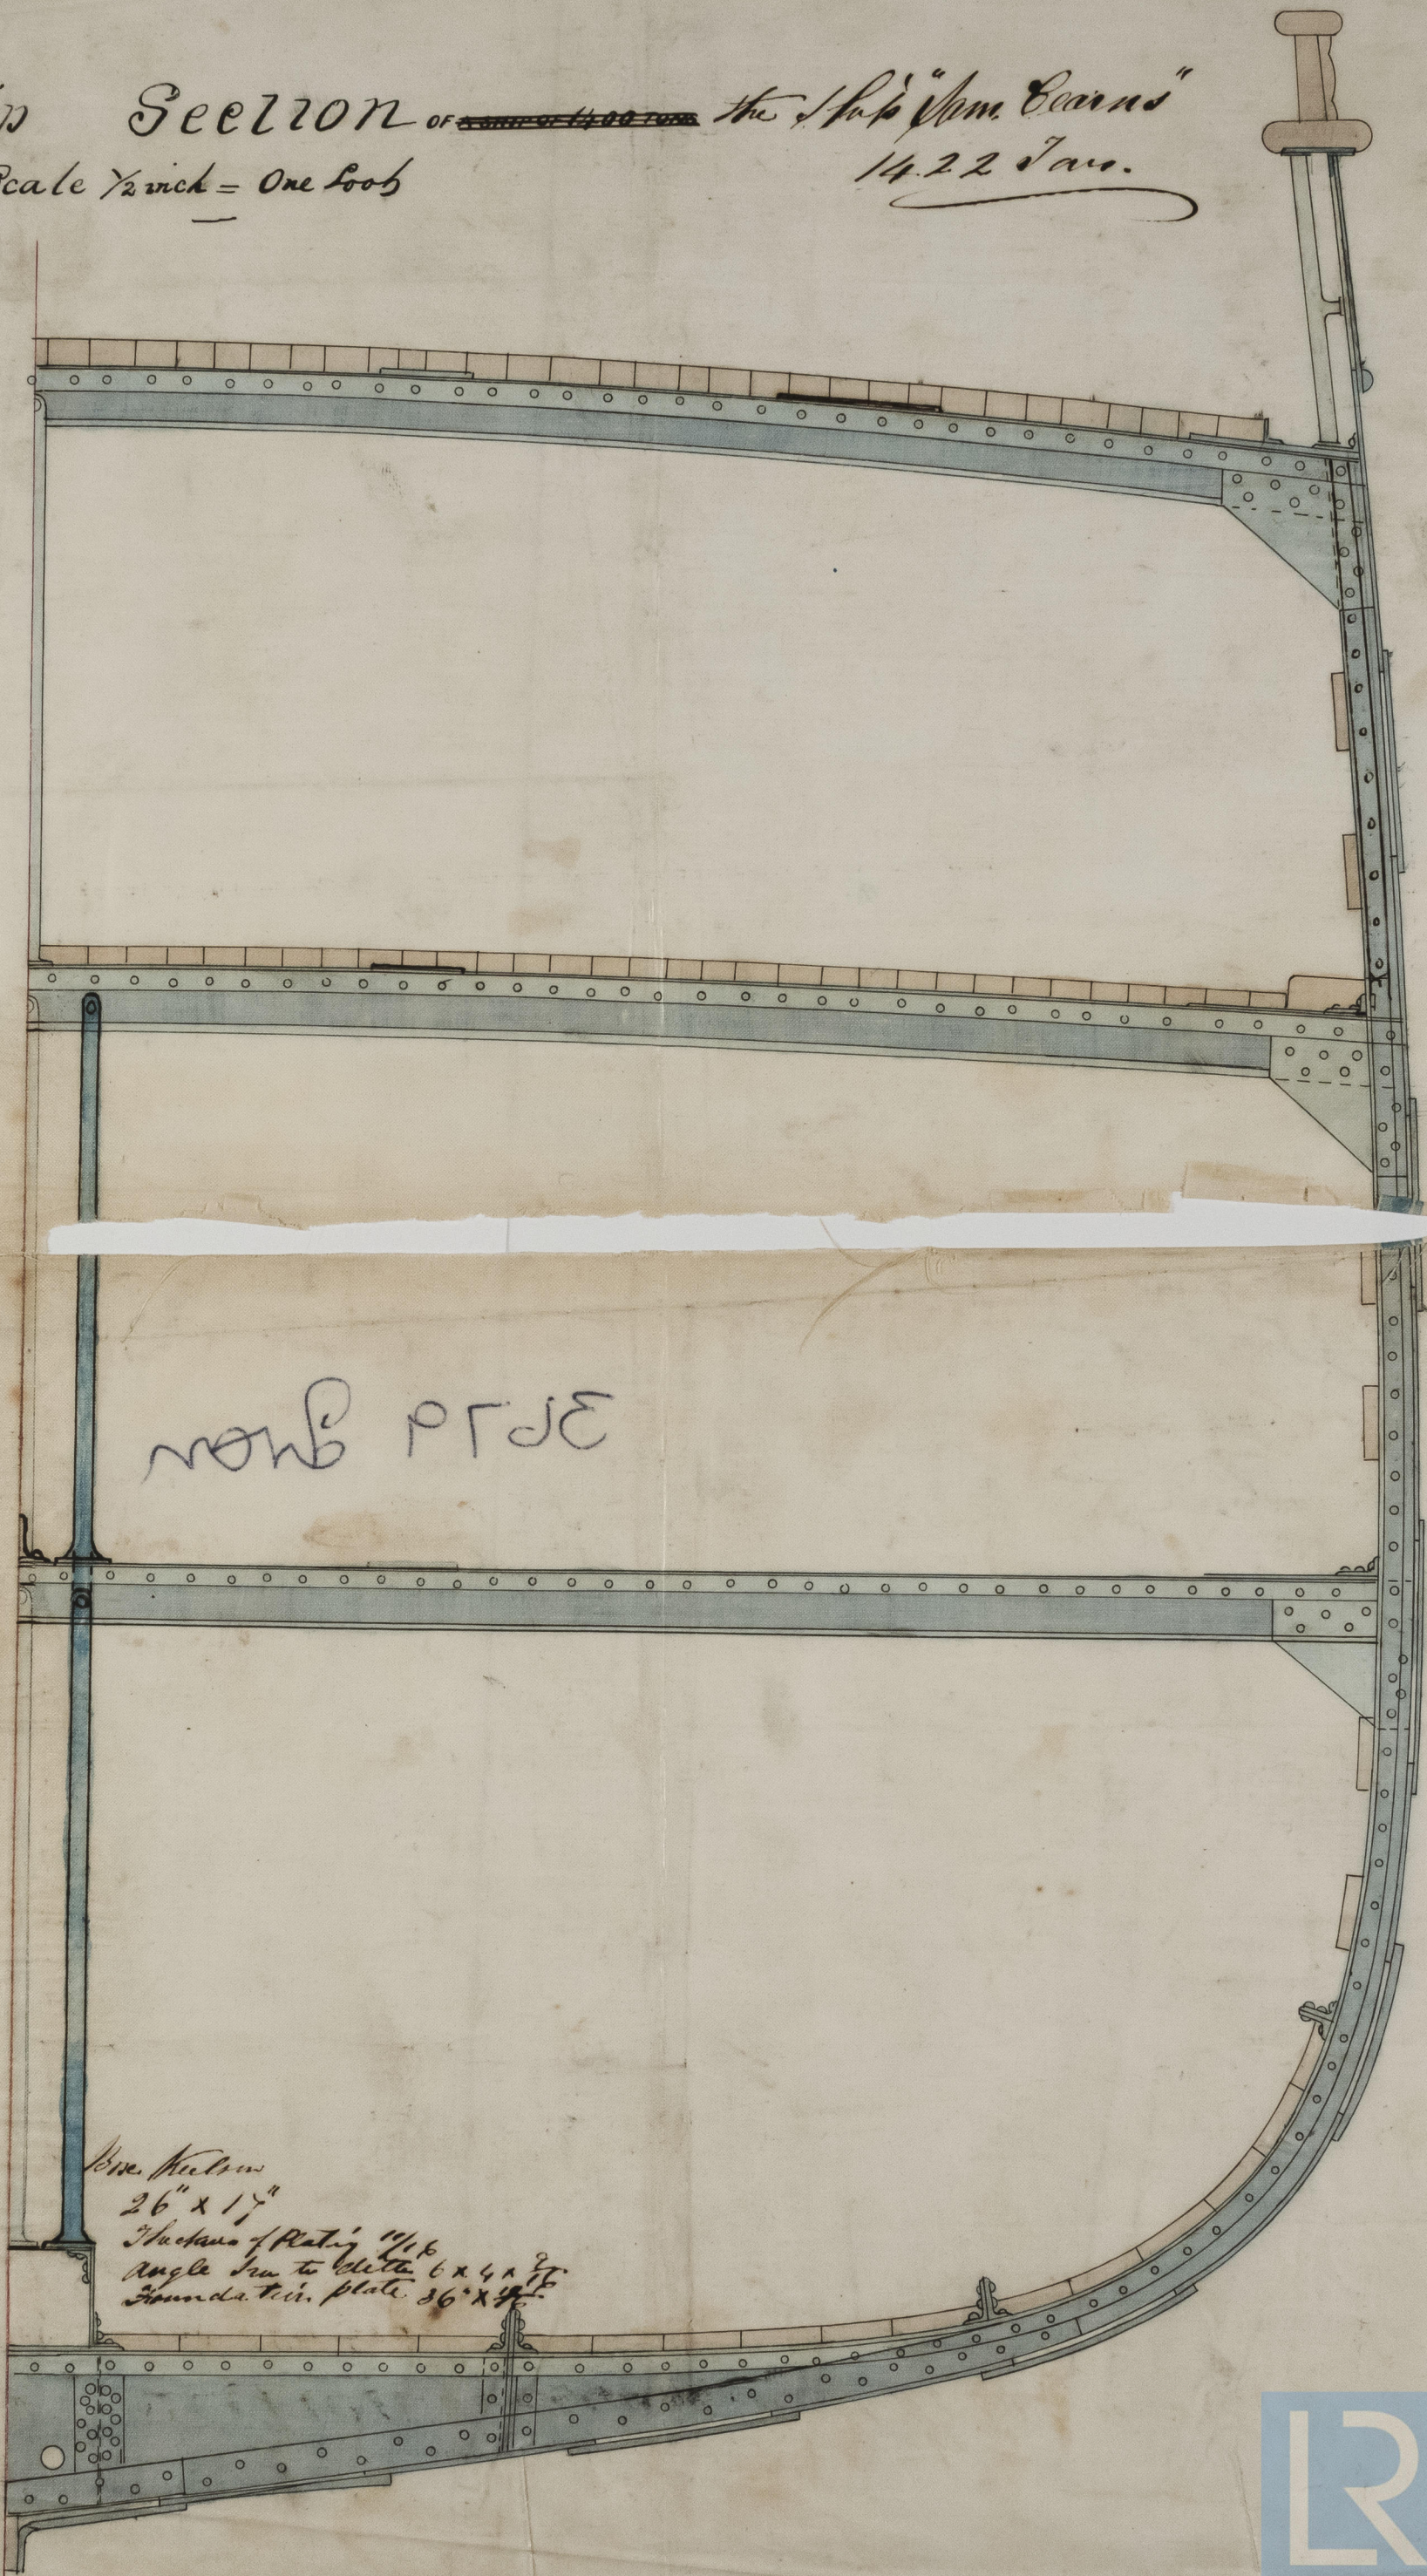



26" x 17"

Thickness of Plating $1\frac{1}{2}$ p

Angle Iron to Clutch $6 \times 4 \times \frac{1}{2}$
Ground. tin. plate $36 \times \frac{1}{2}$

Founda. ter. plate 36" x 24"

Midship
 Scale 1 inch = One foot
 3675017 or 3675018
 The 1st Iron Beam
 14.22.10



3679 Iron






© 2021

Lloyd's Register
 Foundation

IRON 499-0010