



SCREW STEAMER "MULA"

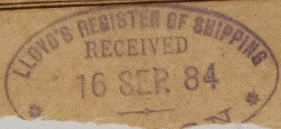

IRON 499-0015 1/3

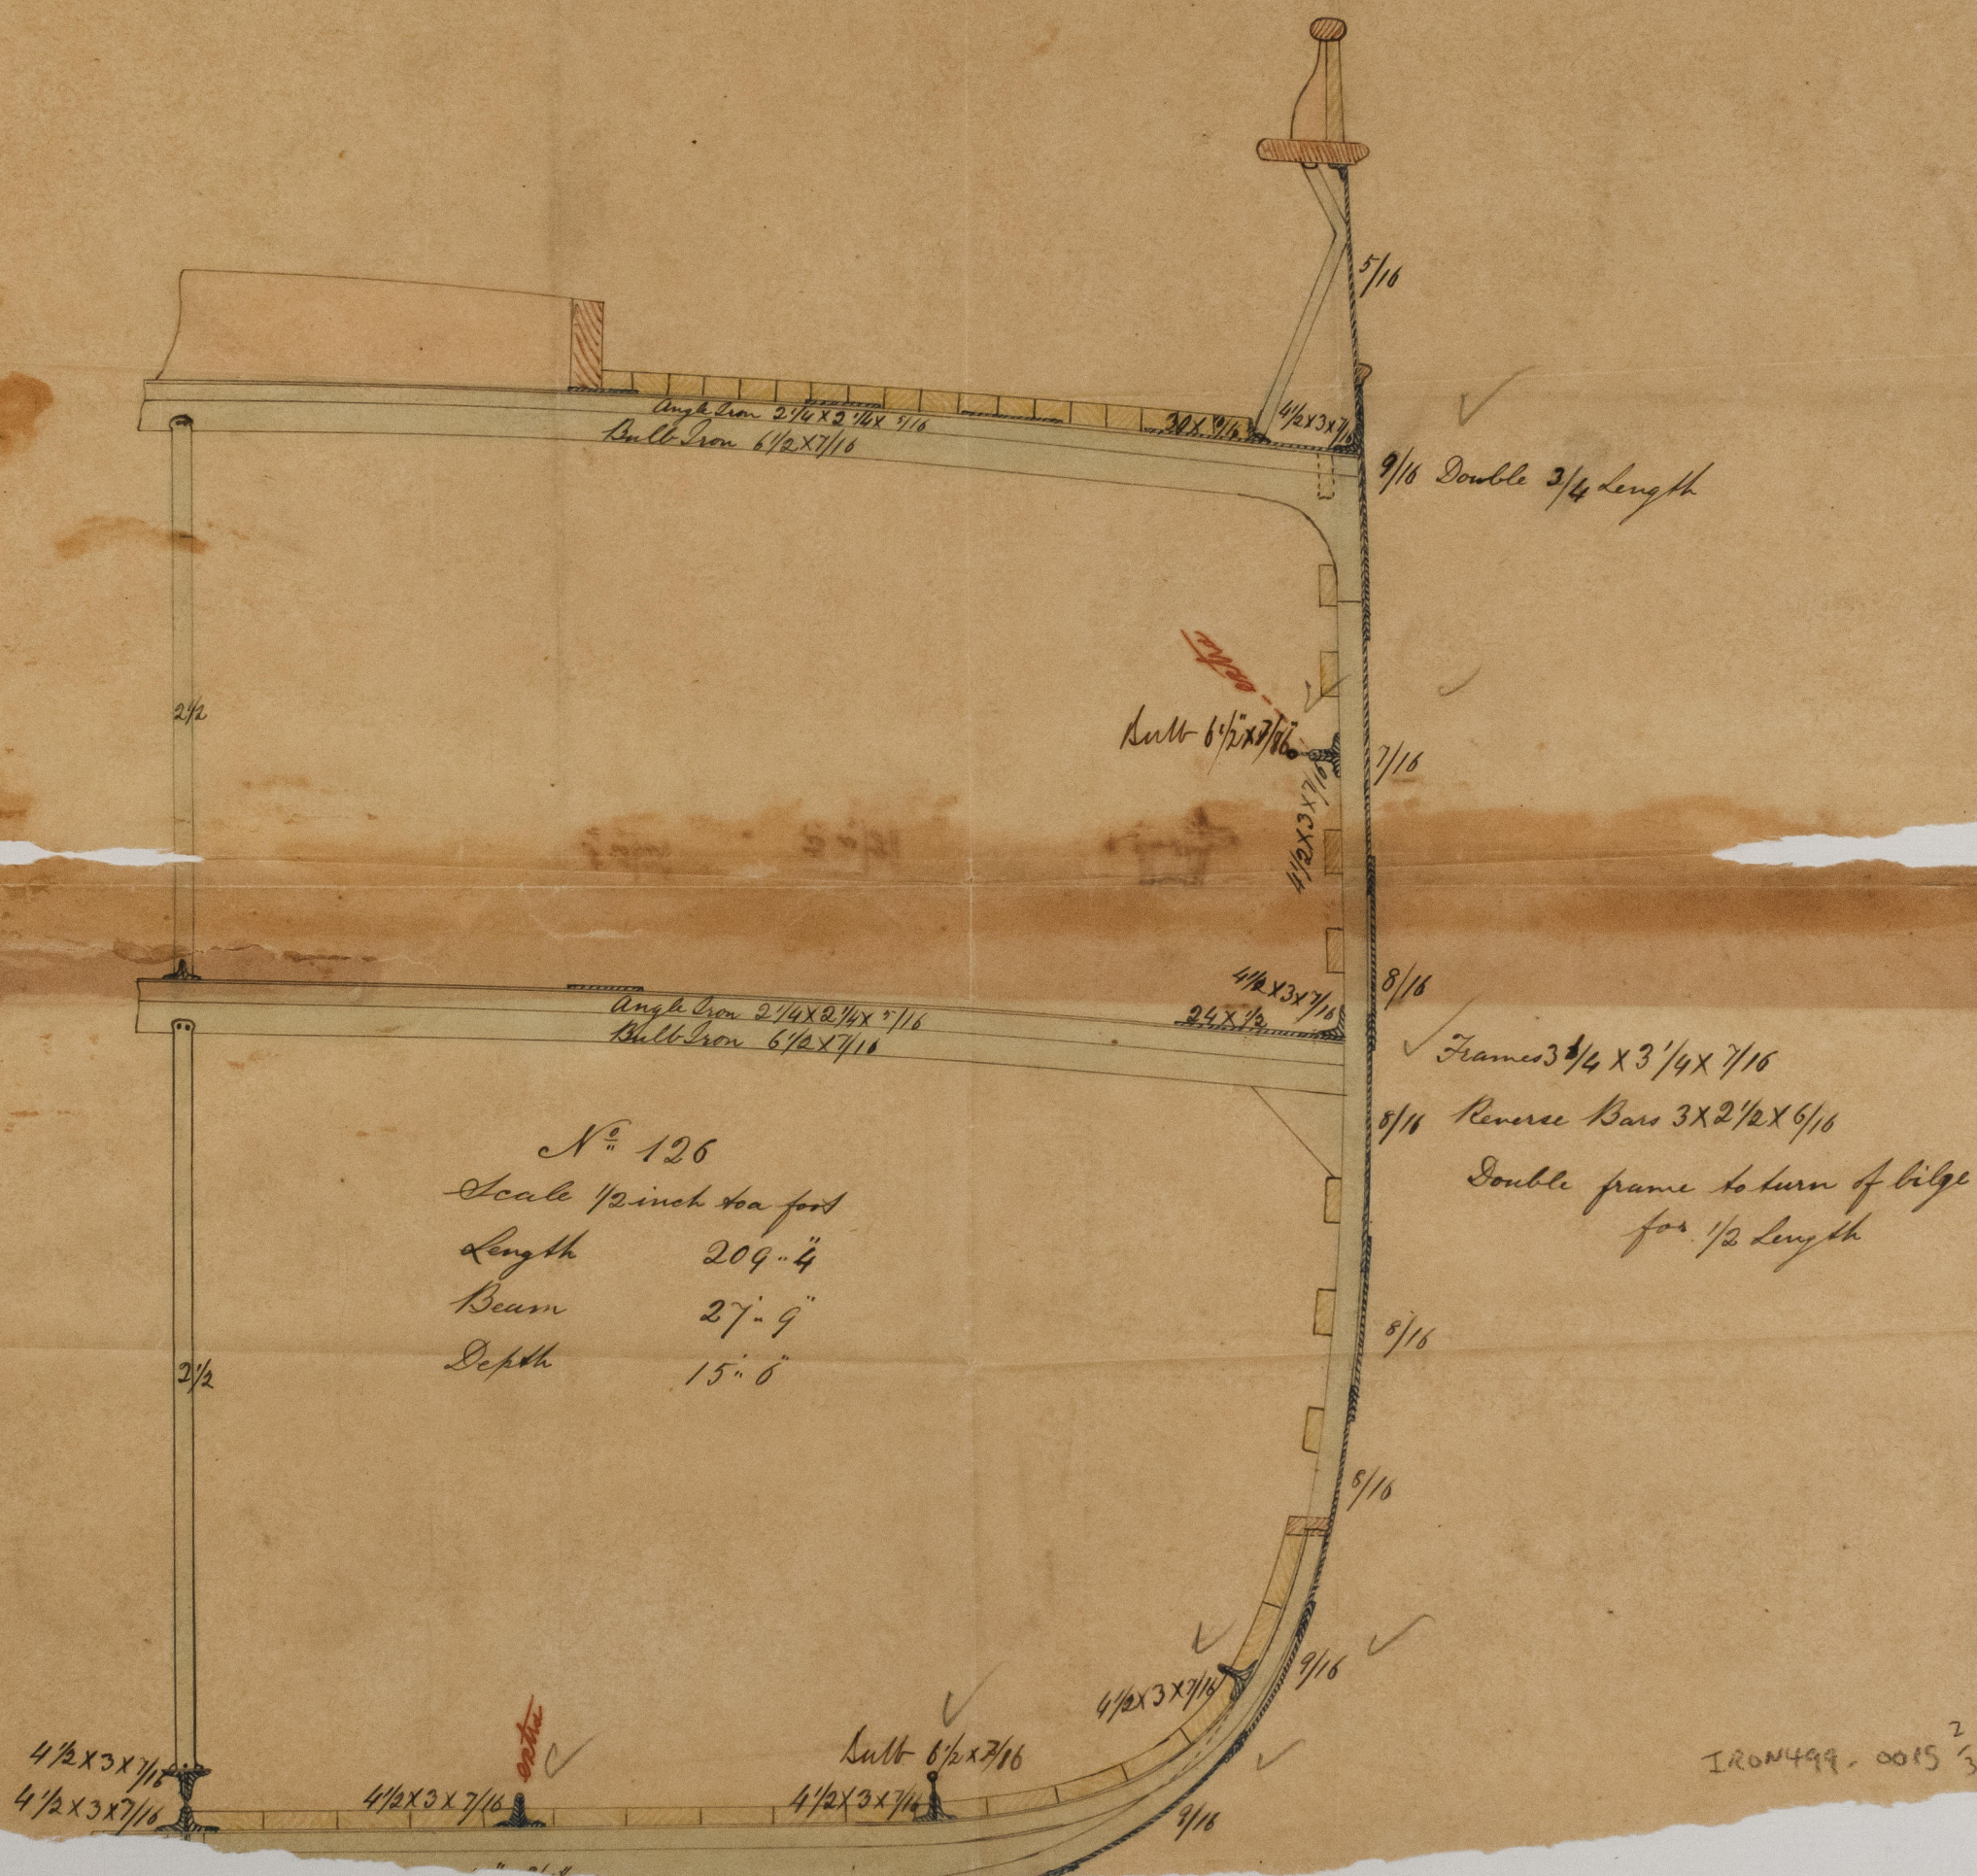

IRON 499.0015 ²/₃

 $8 \times 2\frac{1}{4}$

IRON 499.0015 $\frac{3}{4}$