


MIDSHIP - SECTION


SCALE $\frac{1}{2}$ INCH TO A FOOT

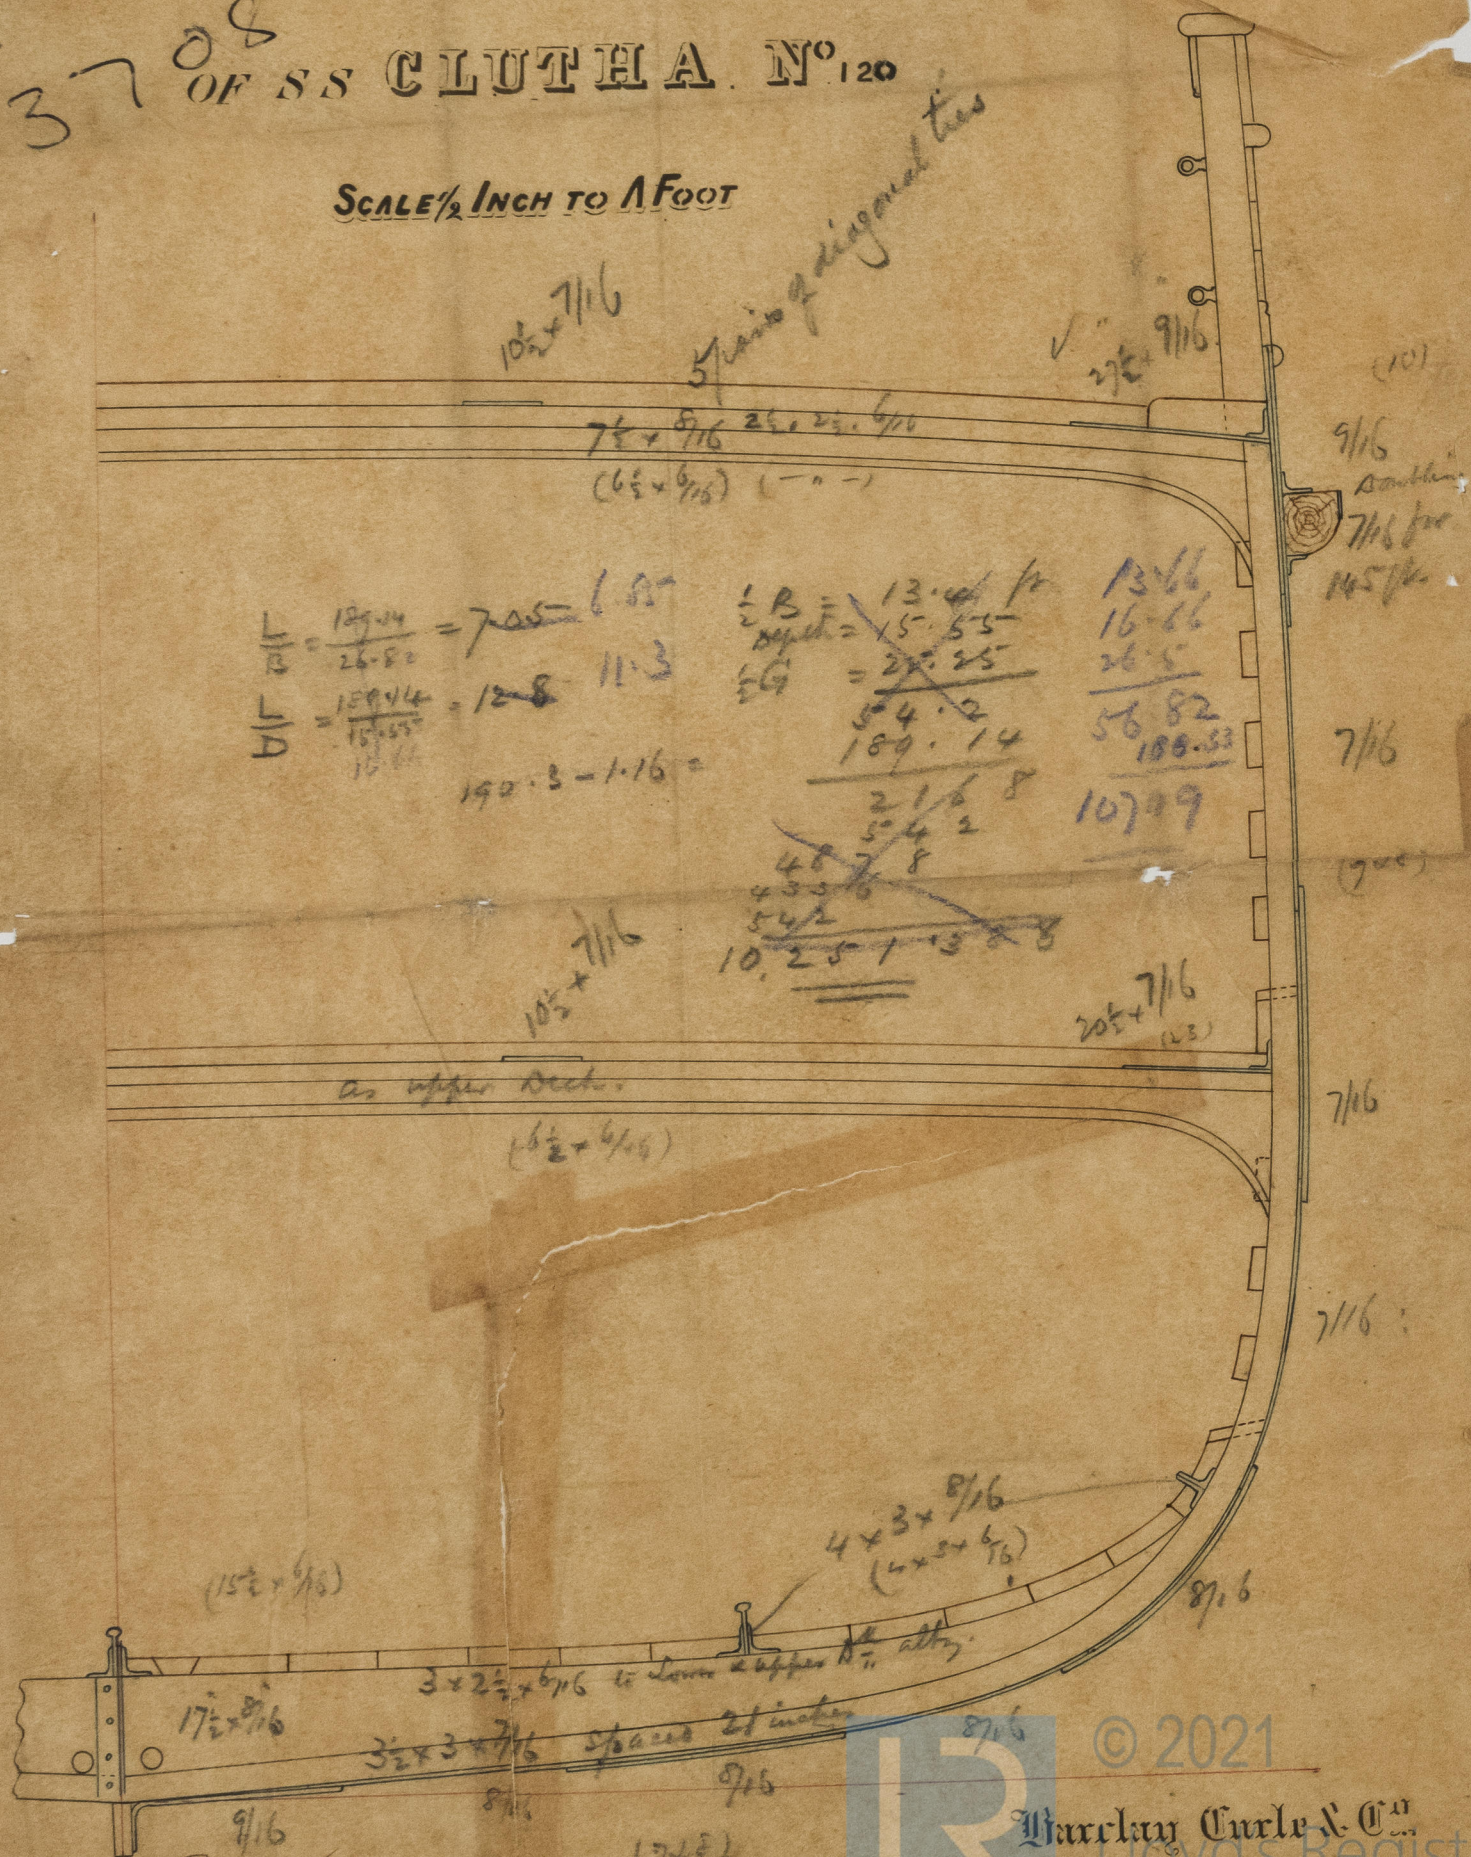

A. Darling

Ship Builders & Engineers
GLASGOW