


Midship Section S. Steamer

220 x 30 x 18.3

Scale 1/4 inch one Foot

Rec 9/1/64

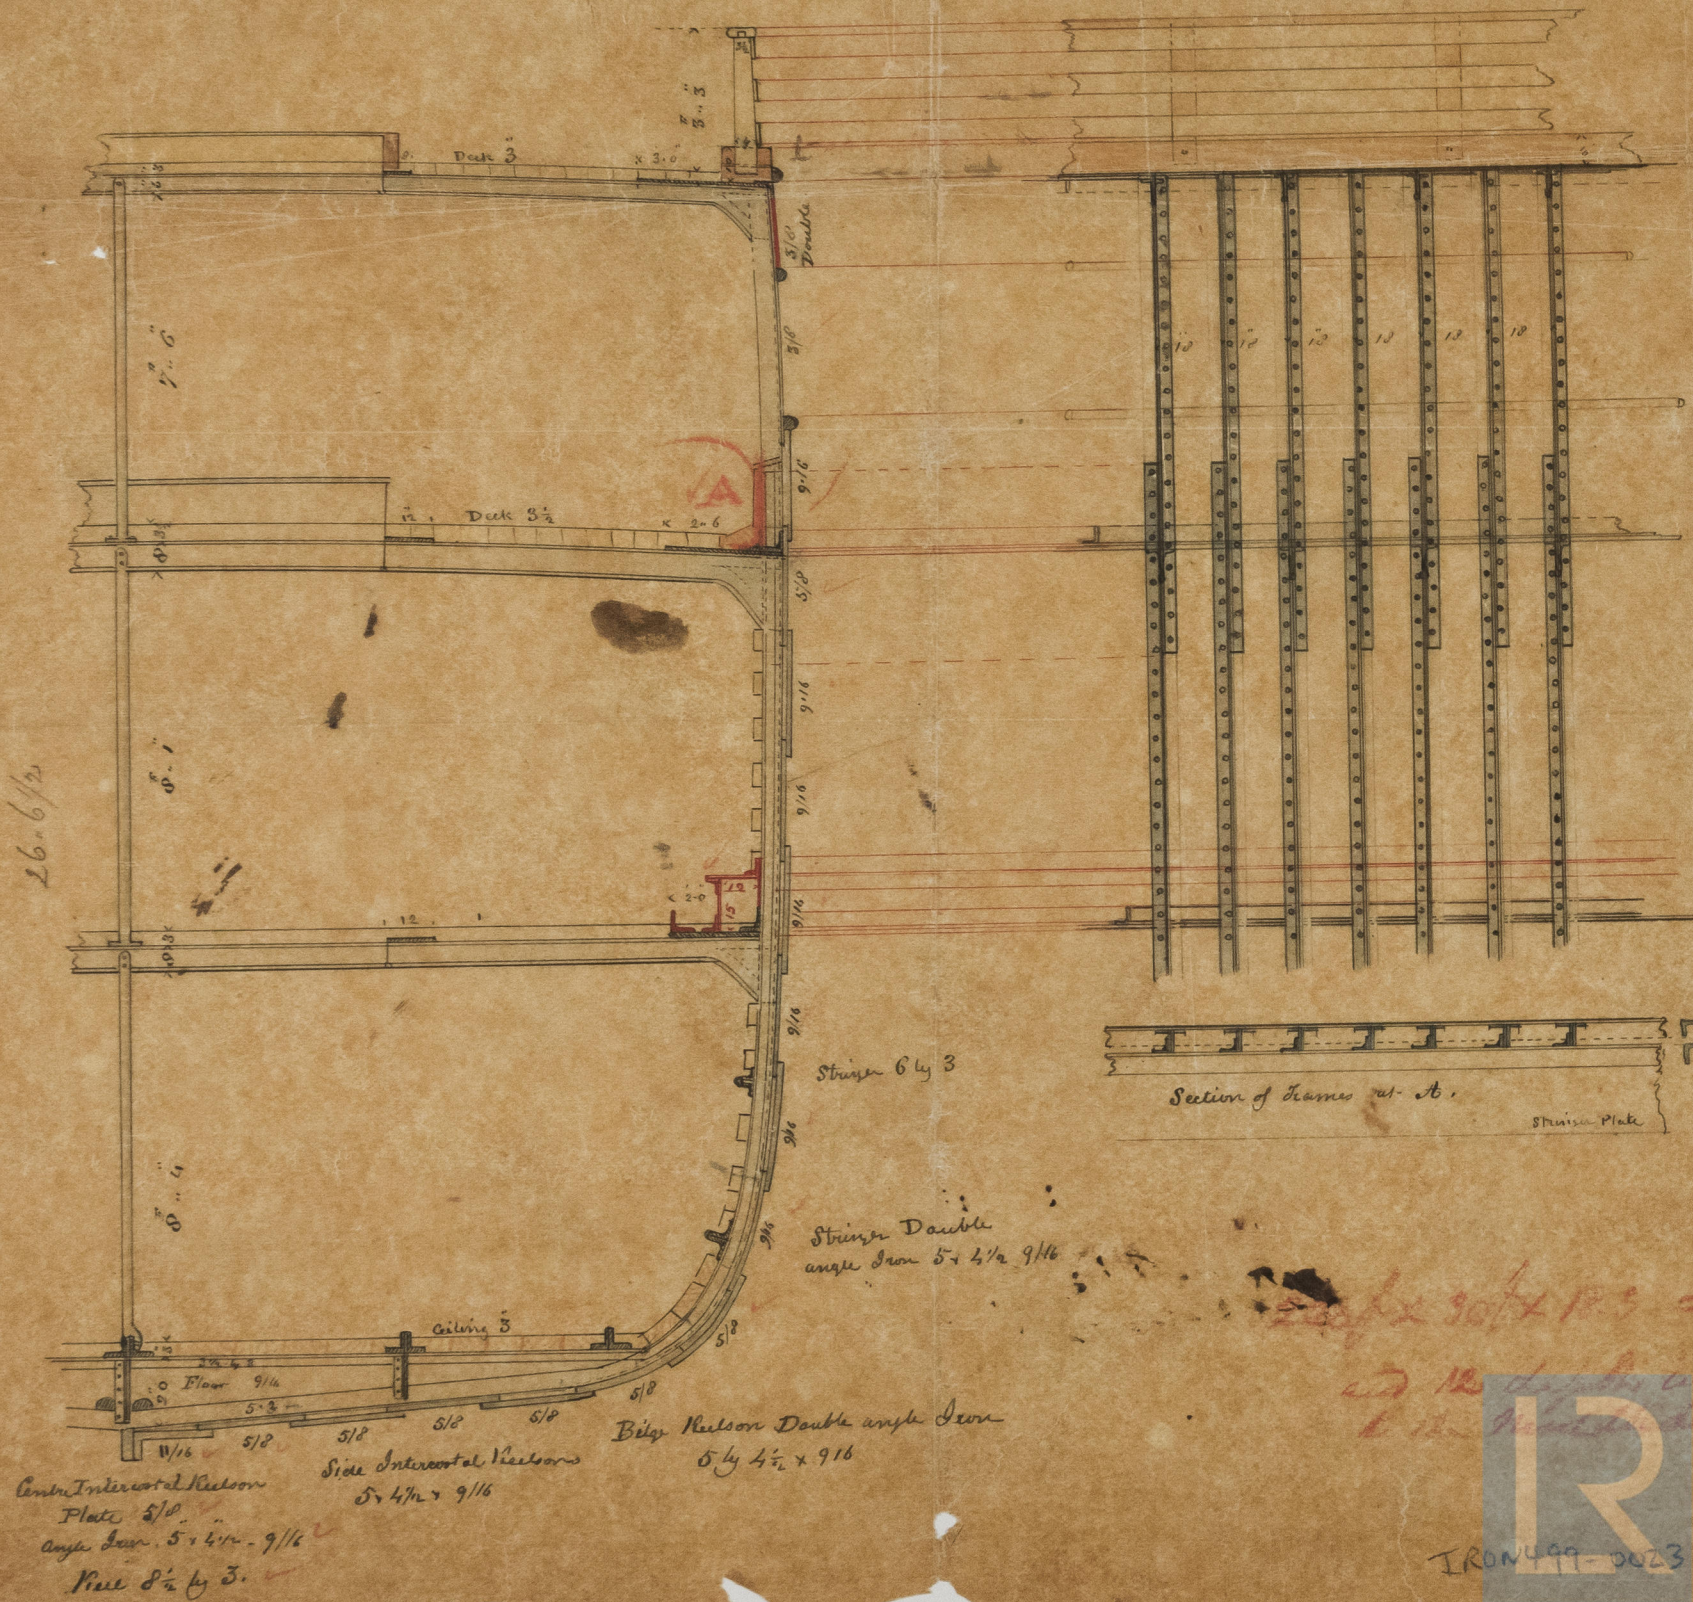

Beams 6 Patent Bulb
Stringer 3.0 x 2/8 Rib
Deck Tie 8 x 3/8
Angle Iron 4 x 3 1/2
Outside Plate

A
Beams 8 Patent Bulb
Stringer 2.6 x 9/16
Double angle Iron 5 x 4 1/2 x 9/16
Diagonal and Deck tie Plates
12 x 9/16

Beams 8 Patent Bulb
Stringer 2.0 x 9/16
Angle Iron 5 x 4 1/2 Single
Deck Tie 12 x 9/16
Box Piece in way of Engine
12 by 15

Section of Frames at St.

Stringer Plate

220 x 30 x 18.3 = 800 Tons

and 120 tons in length



© 2021

Lloyd's Register
Foundation

IRON 499-0023