

1500-1500-1500

Palmers Shipbuilding & Iron Co.

Limited
Newcastle-on-Tyne


2
7
M

18th July 1871

Midship Section
of
S.S. "Medora"

Scale $\frac{1}{2}$ inch = One foot

Dec. 22/7/71
AA

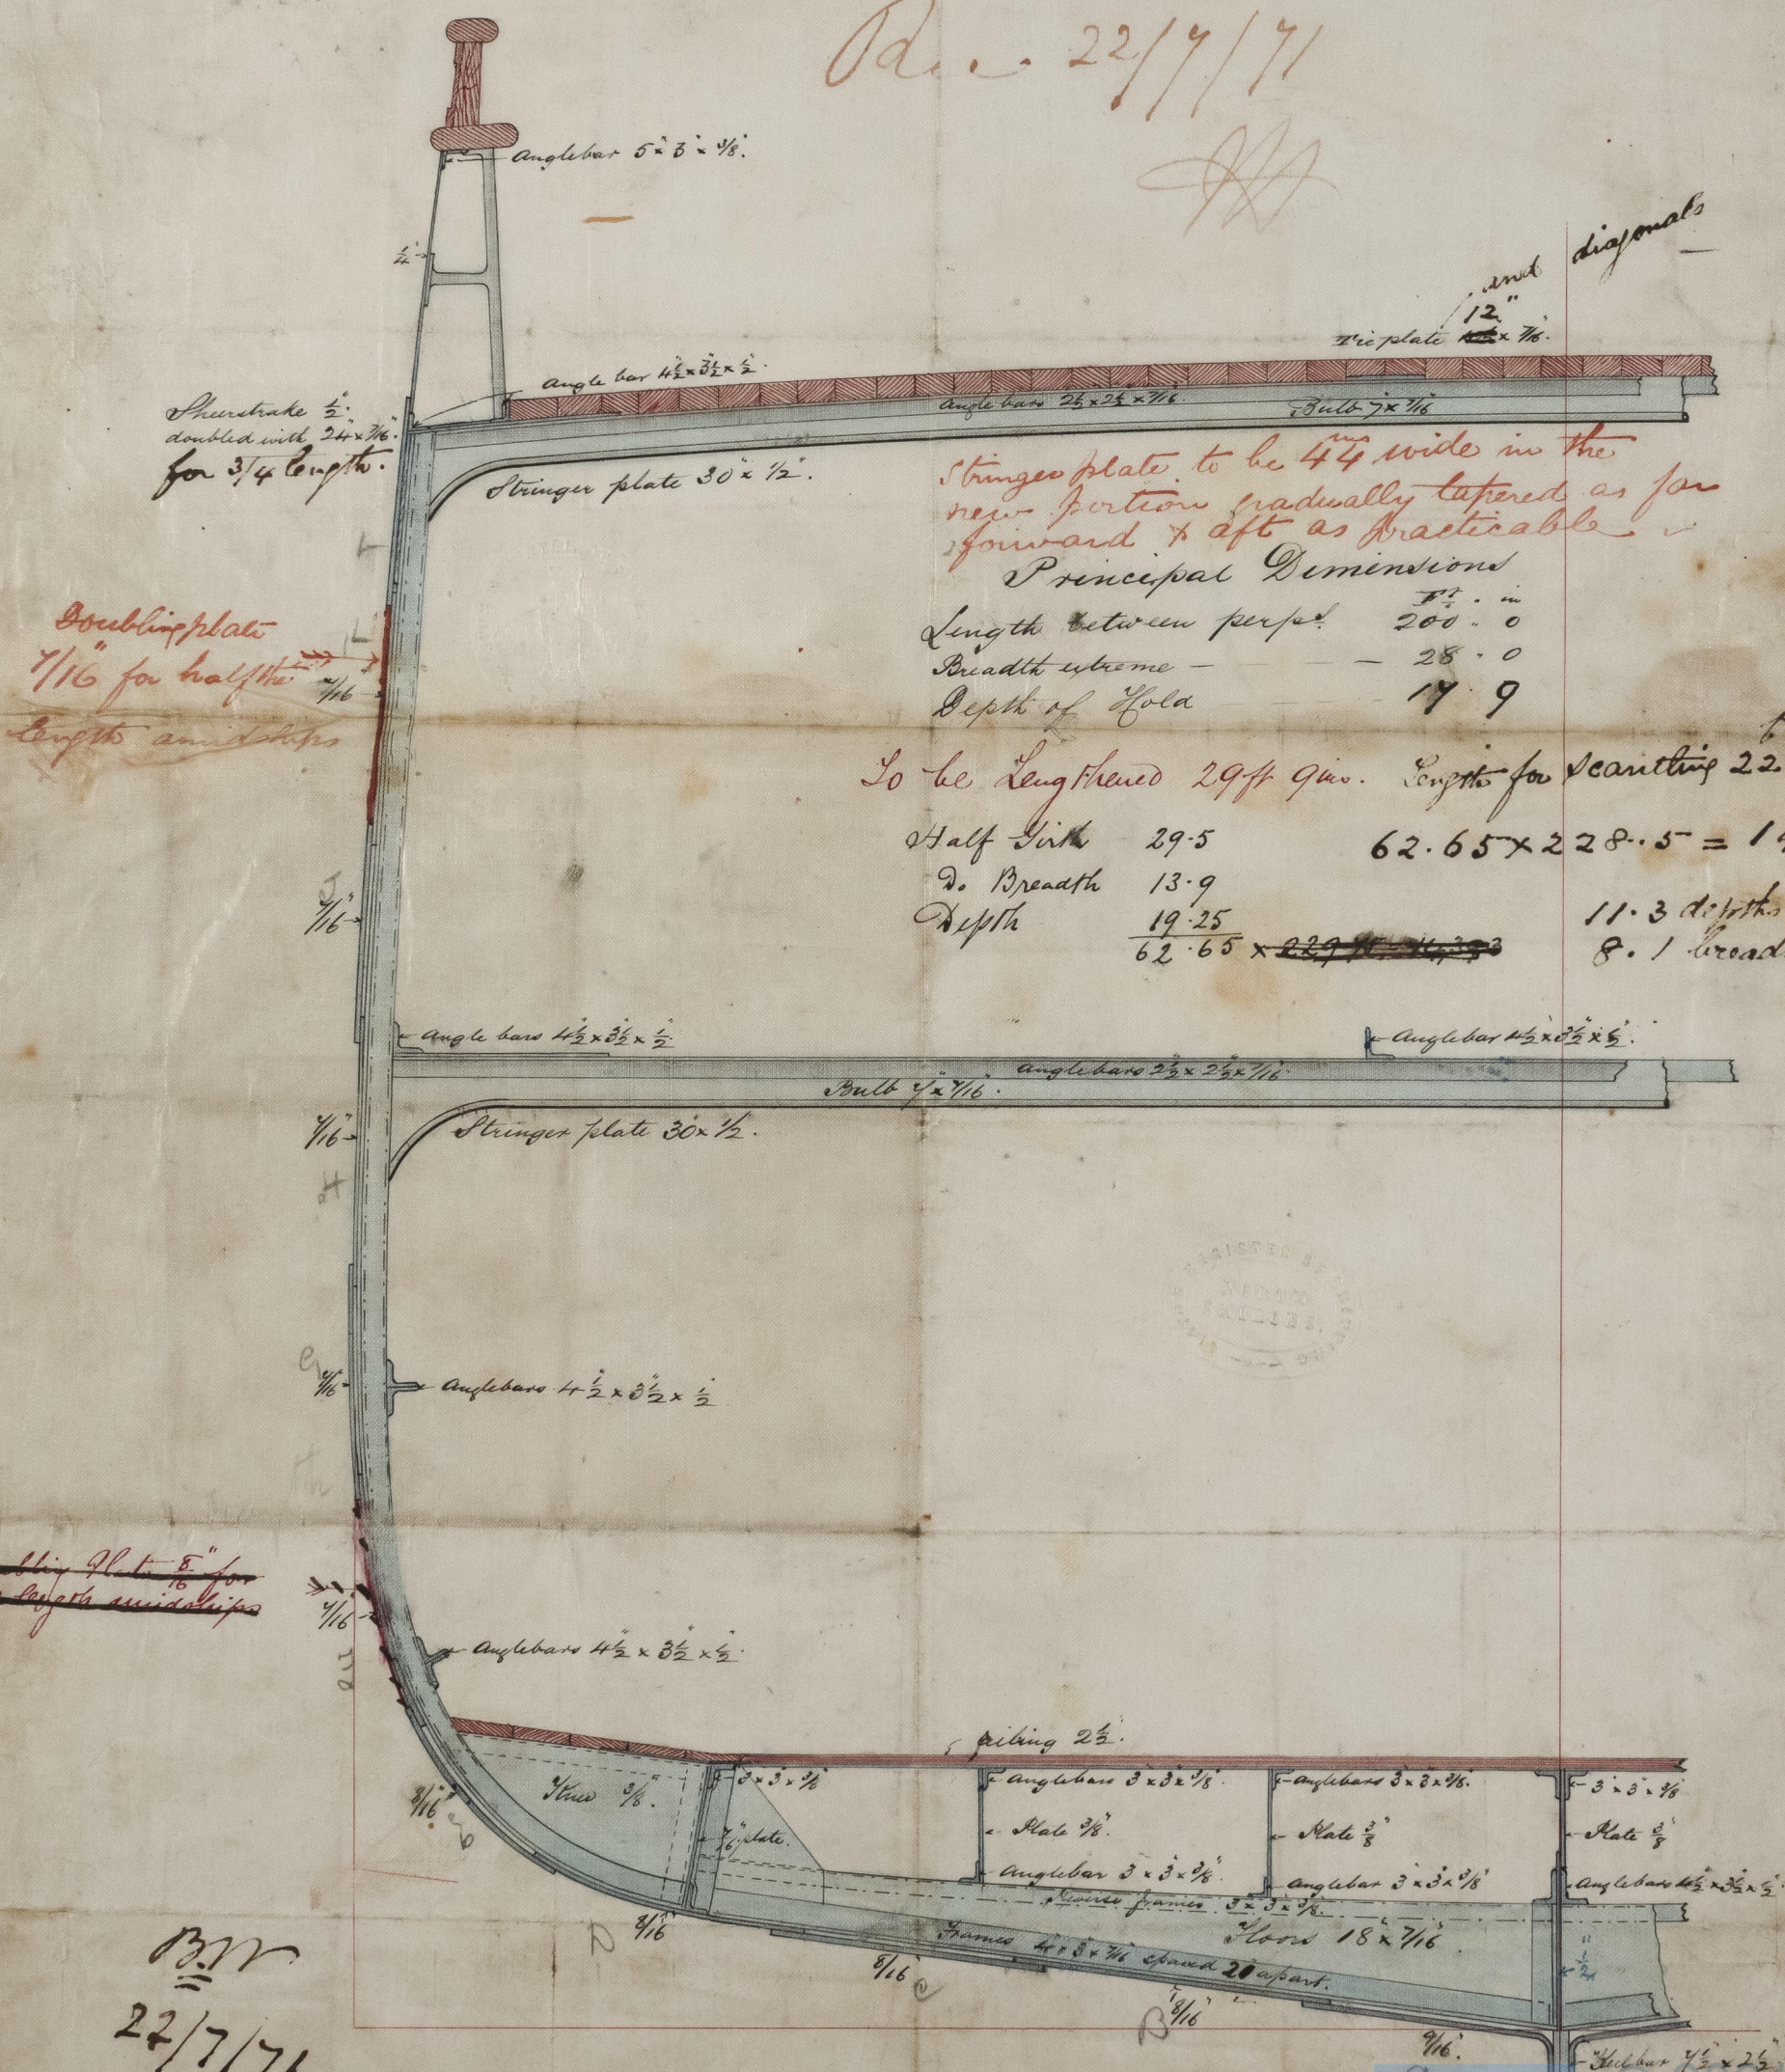

B.M.
22/7/71

