

on Type

Midship Section.


Nº 151.

Scale $\frac{1}{2}$ inch = One foot.

Rev. 7/8/64

3746

Speci-
to be double
in 3/4 in
the length

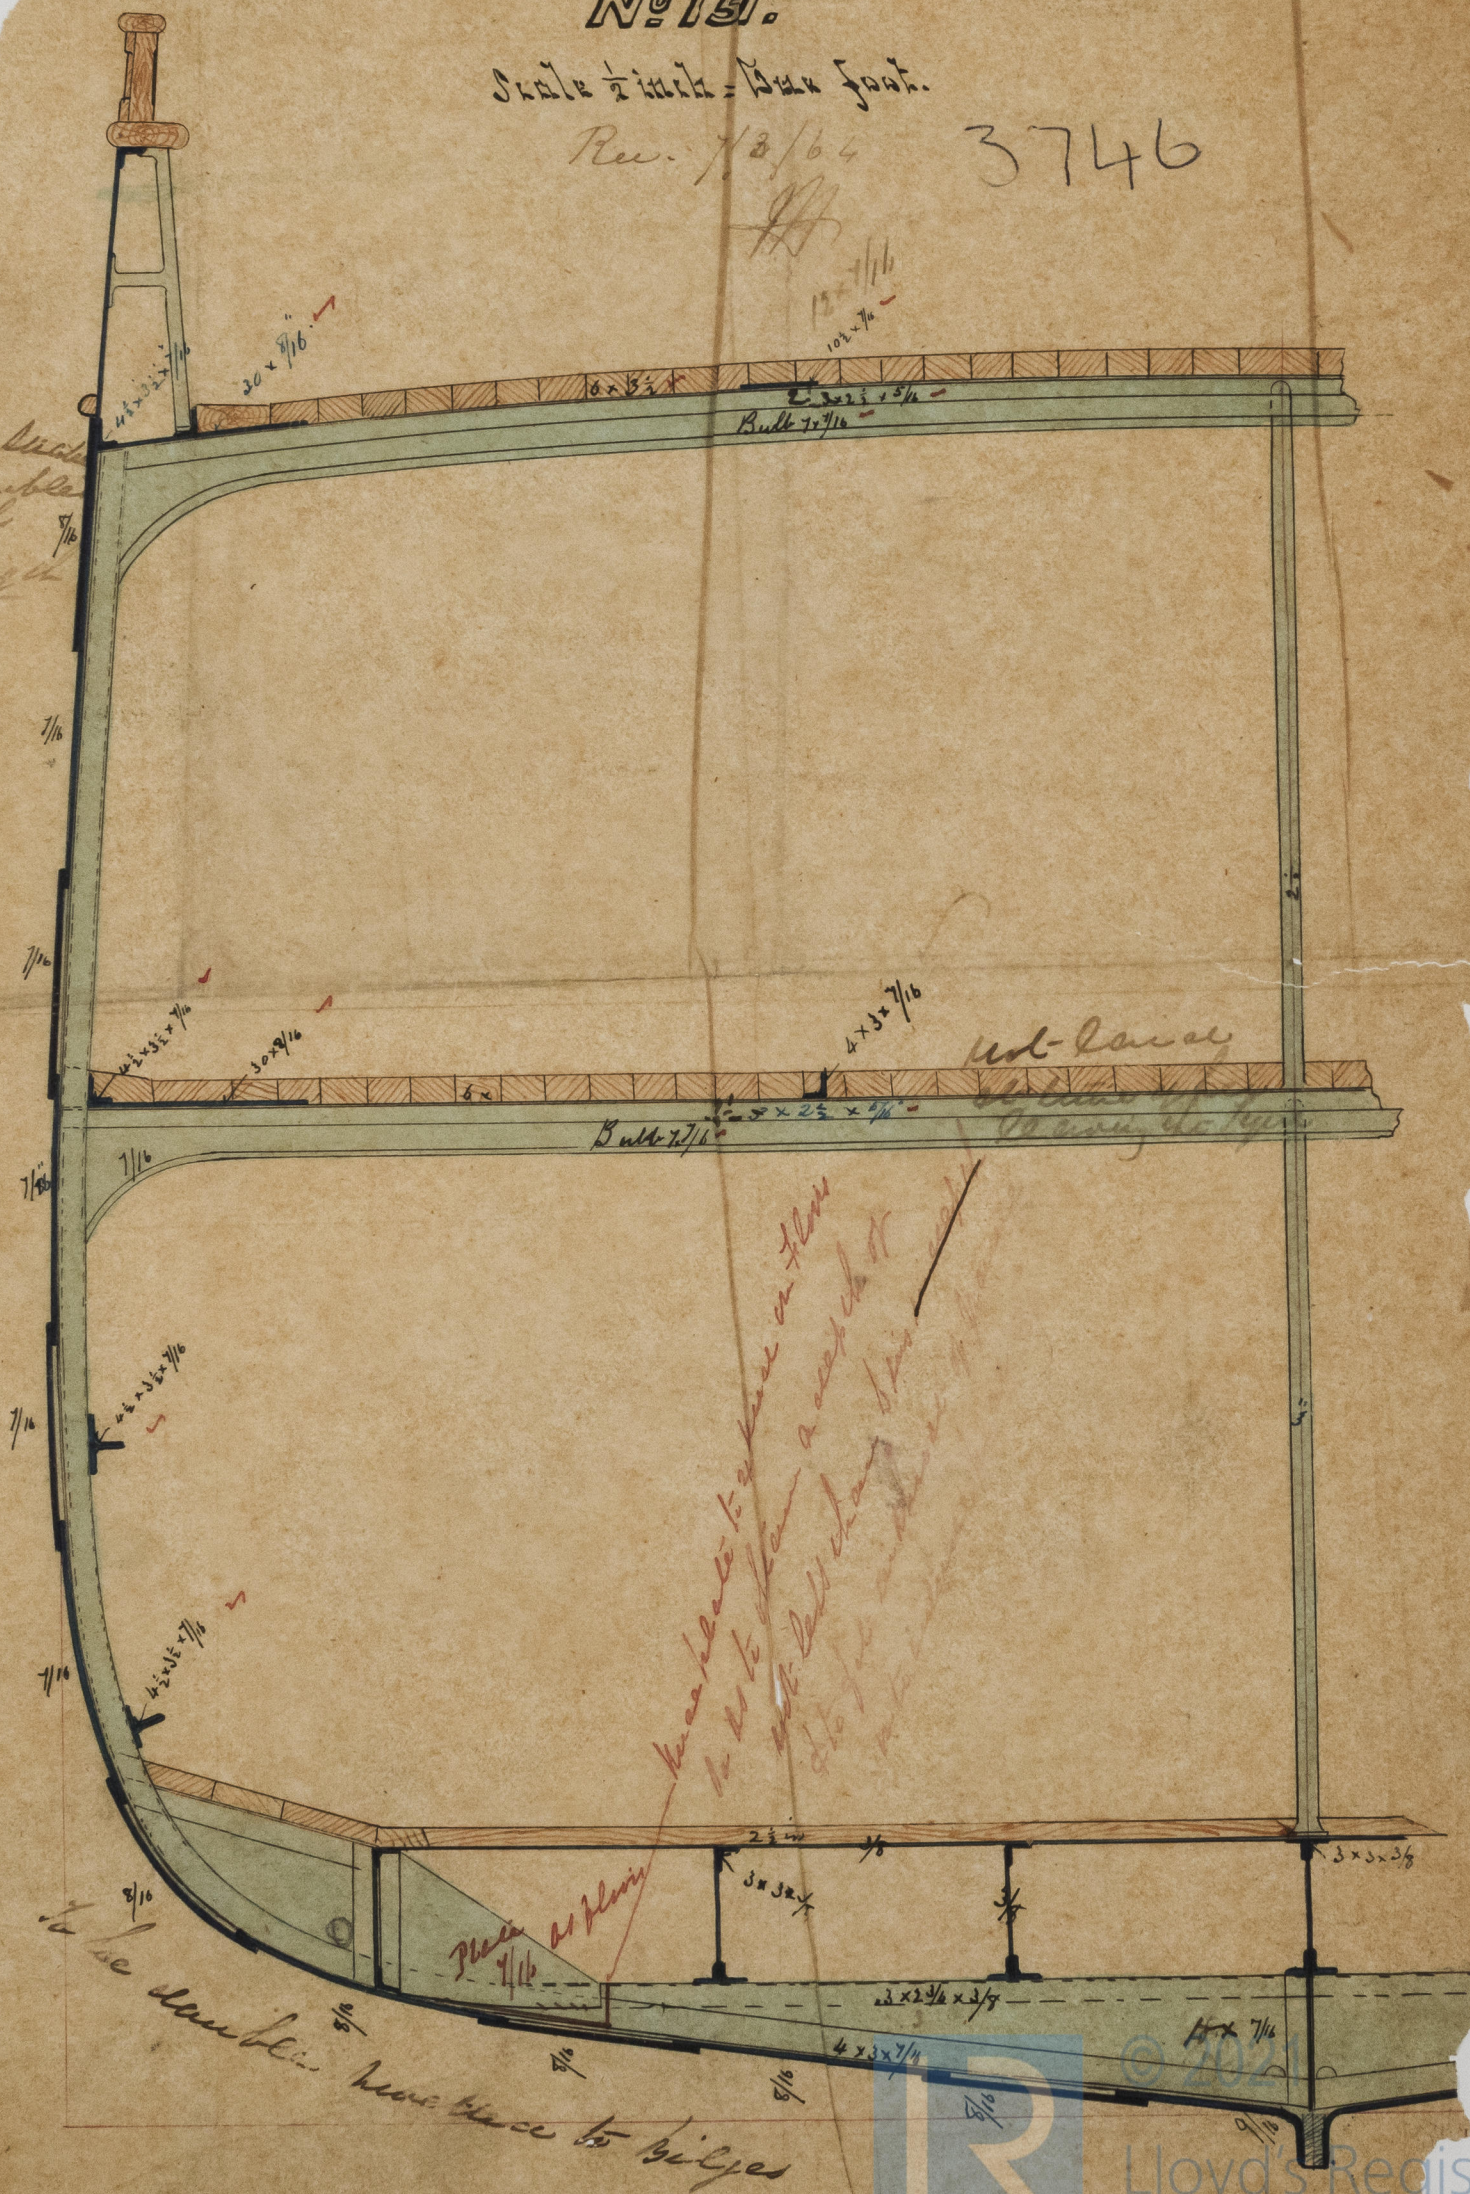

Not-


