

Length 222 feet
 Breadth 29

Depth 15.3

Request of Survey No. 327 & 328
 for *A* class


Midship Section I. S. Nos 121 & 122 Builders Ltd
 under 100 Tons for the *A* class
 Scale 1/2 Inch per Foot

Rec 17/3/64 for Orders No. 327 & 328 also 329 & 300
 Q 11/4/64

Length 222 feet
 Breadth 29 29 ft
 Depth 15 3/2

No. 3 - no.
 327 = 121 Builders Ltd
 328 = 122 Builders Ltd

372

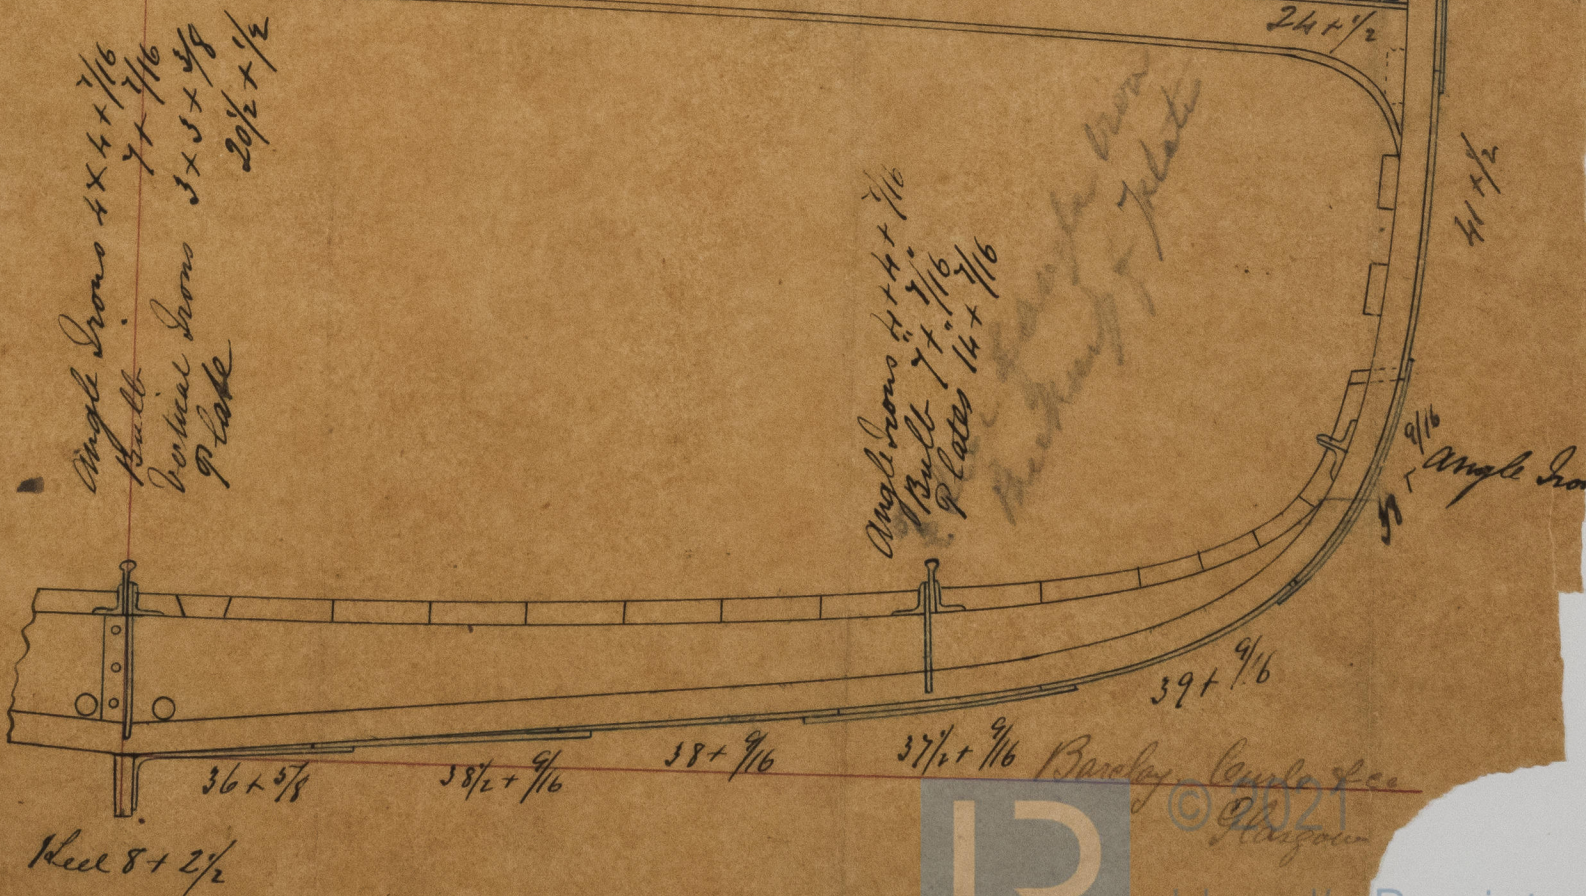

Lloyd's Register
 Foundation

IRON 499-0036