


Midship Section
 Scale $\frac{1}{2}$ in to the Foot
 S. L. 230 x 29 x 17' 8" moulded
 230 x 29 x 16.8 depth of Hold at
 G. B & C

Rec 16/1/64

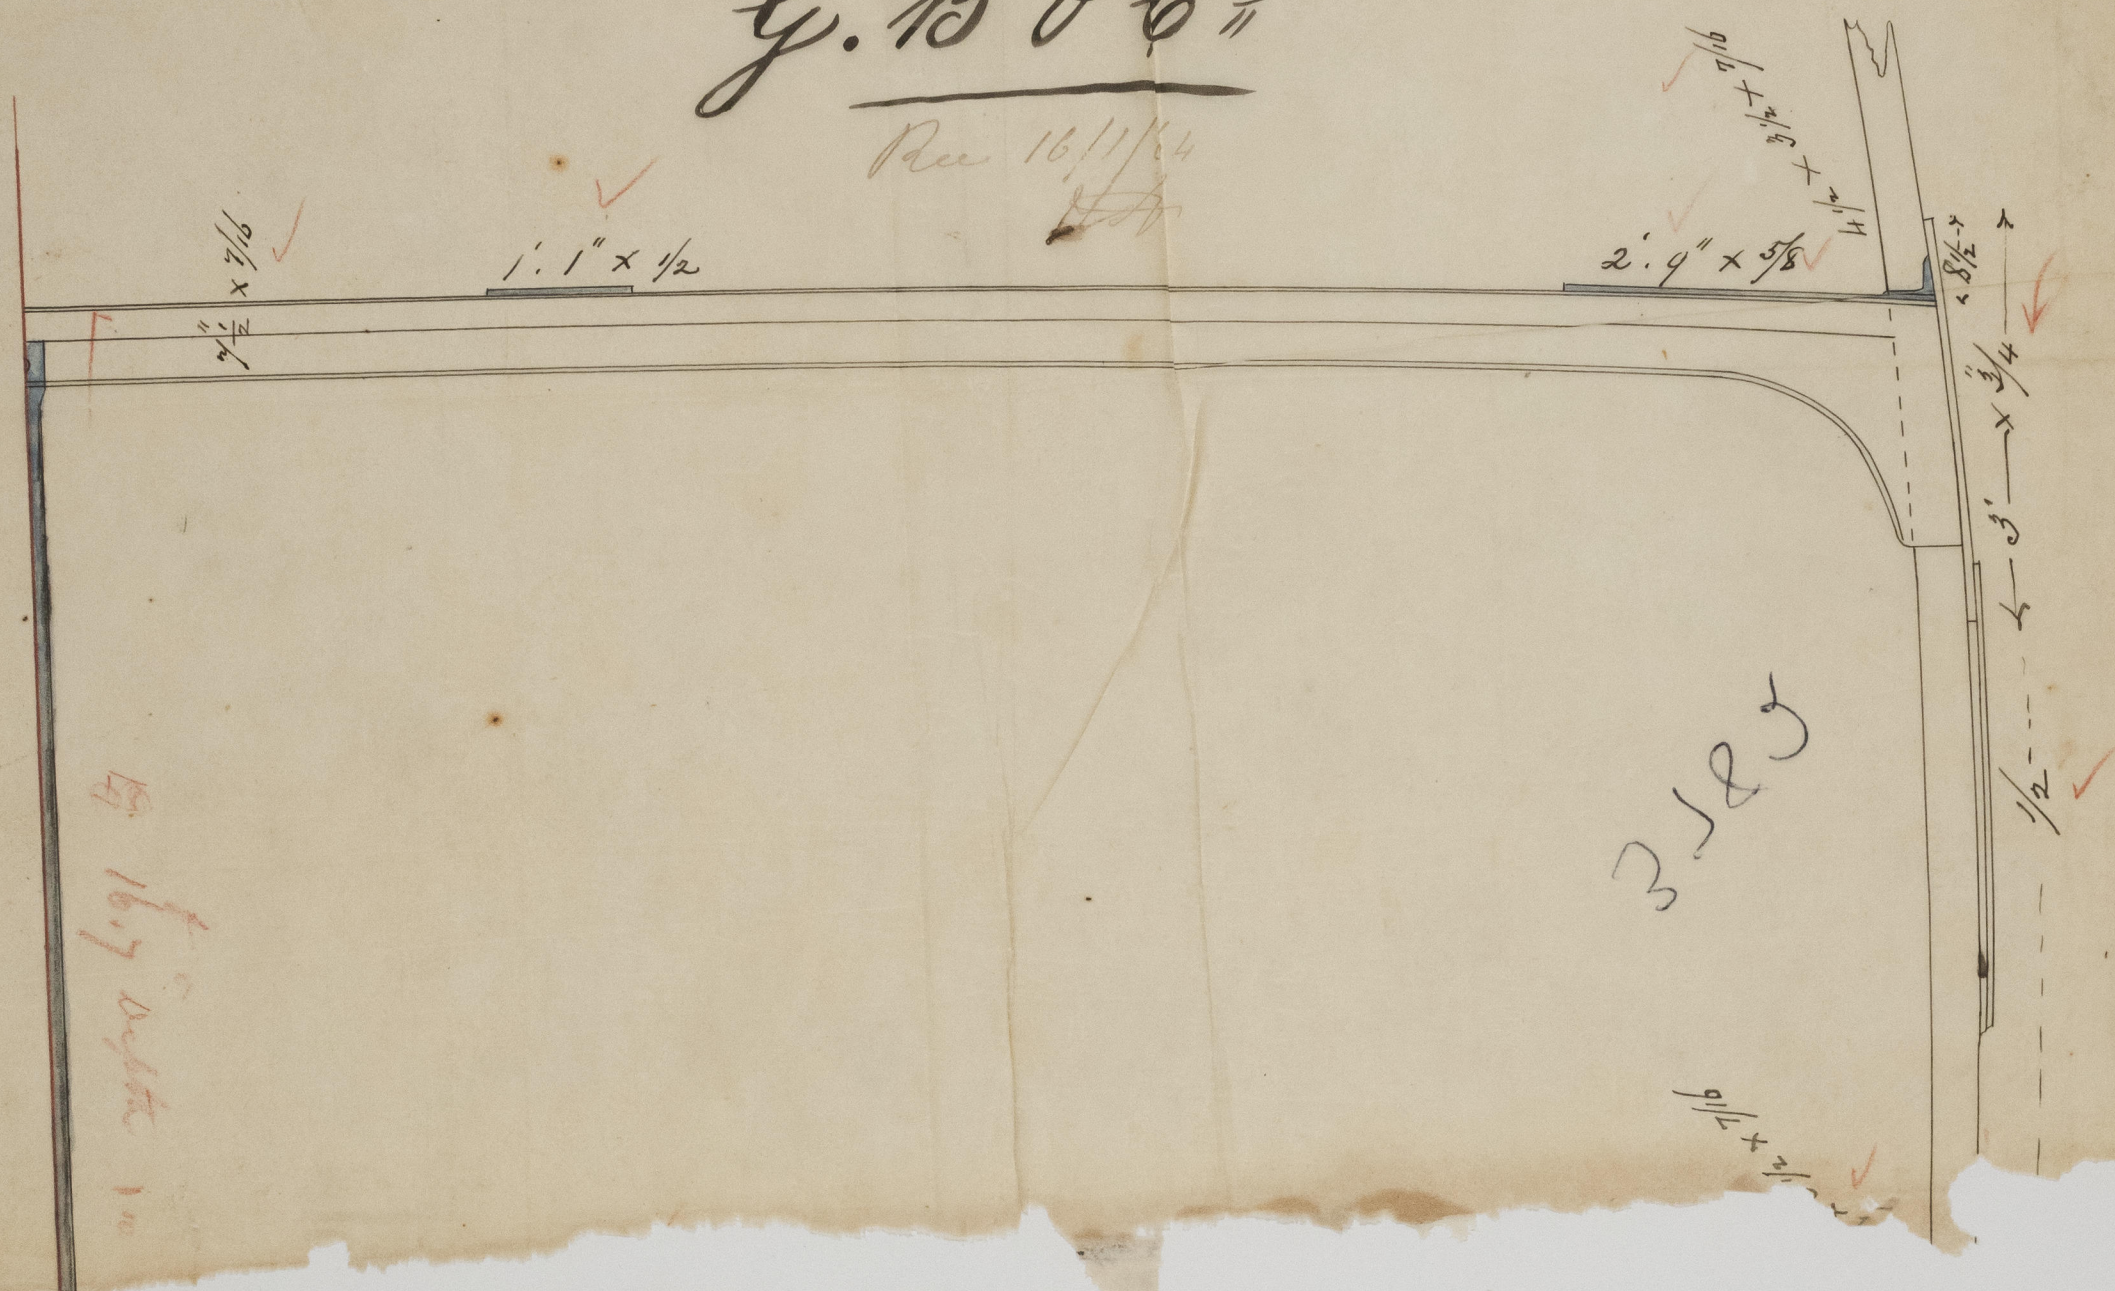

Compared with the
 600 Long Scale per Mr. [unclear]
 Telegram 20 Jan 1904
 756 tons S.M.
 21 1 64

1870
 1871
3782

[illegible]

IRON 499-0039