


Nº 32

MIDSHIP SECTION

Length. 185-
- Breadth. 28
Depth
Moulded } 14
- " - in Hull 16

4. Class A.
B.
Akant. 130 Lons

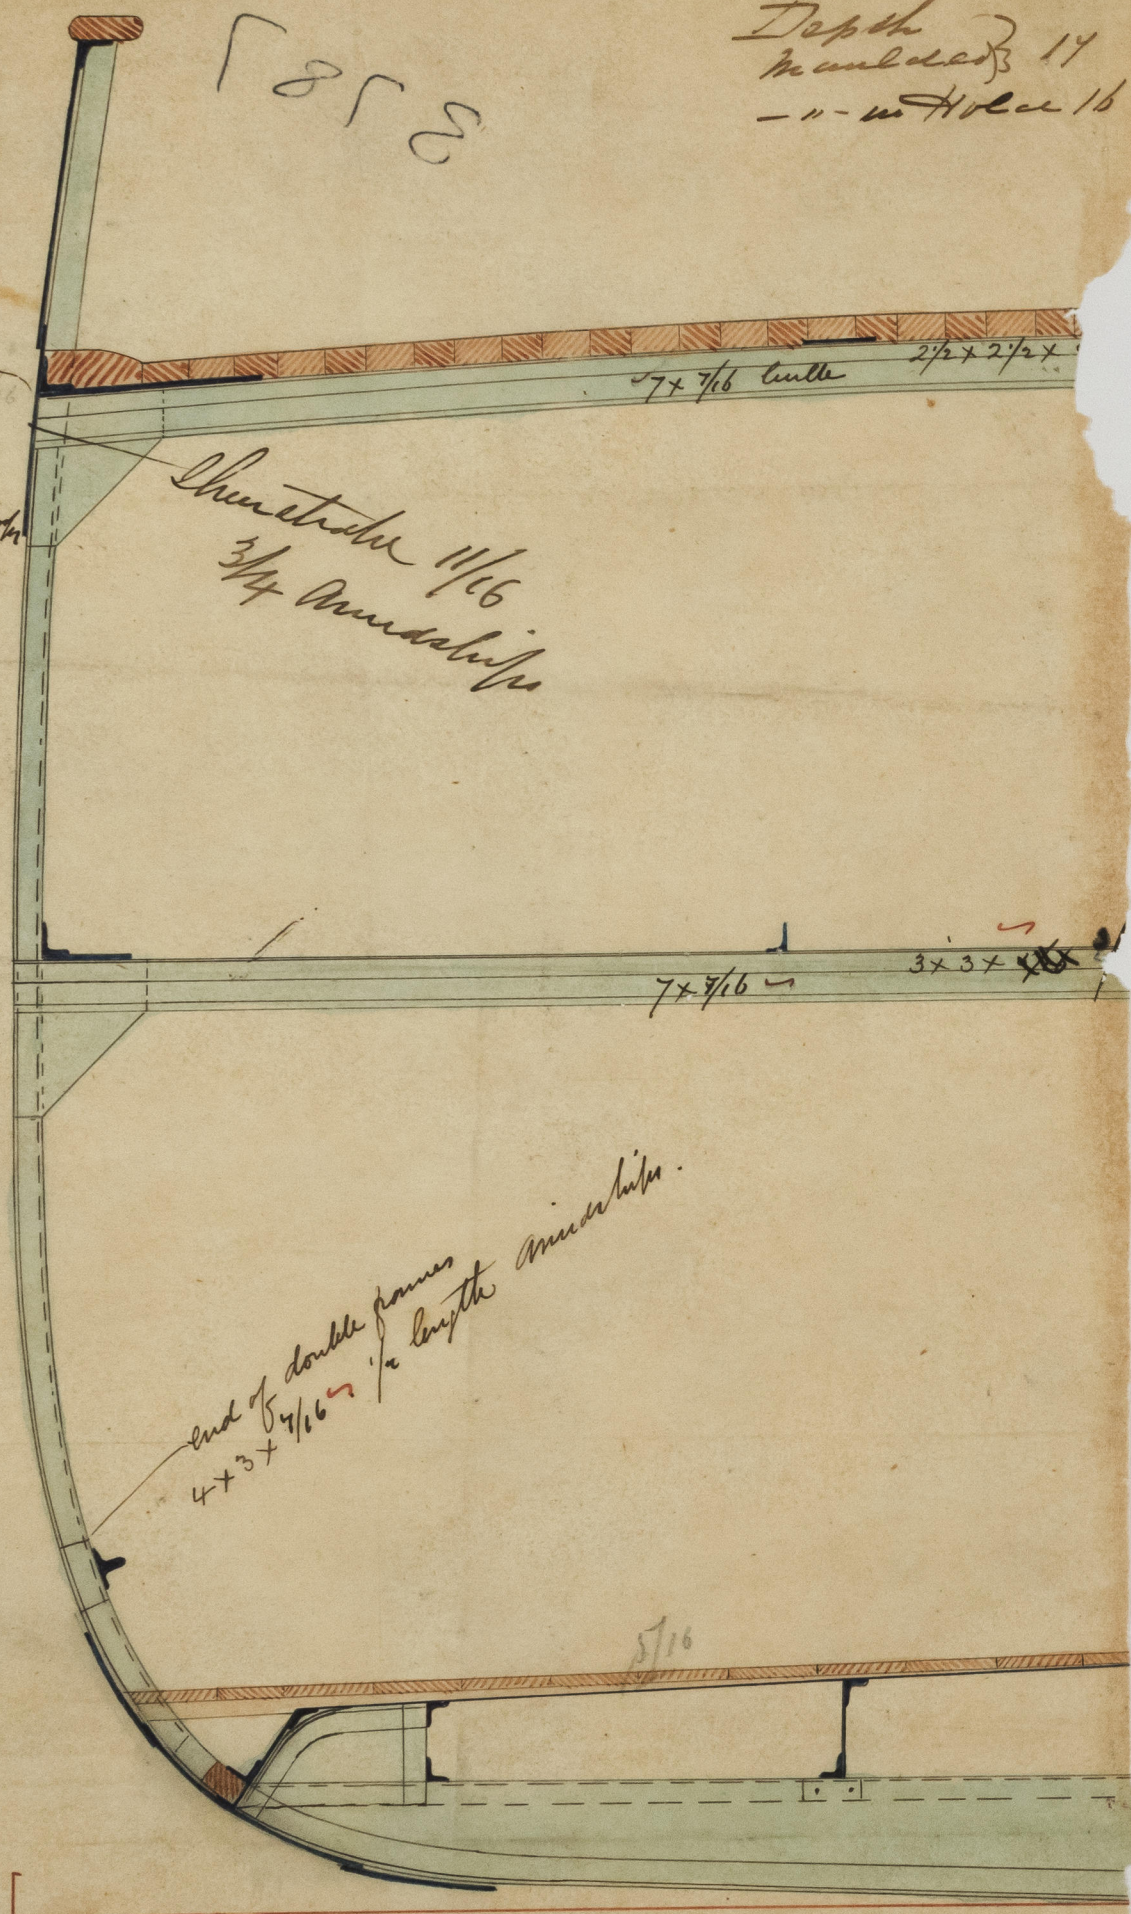

Rec 16/4/64
 William Richardson Esq

13th April 1862



3787


1/10

[illegible]

SECTION












[Handwritten signature]

13th June 1864