


# 3855 Iron Ship

Scale  $\frac{1}{2}$  inch = 1 foot

Union Ship-build Co Glasgow  
Rev. 8/6/64

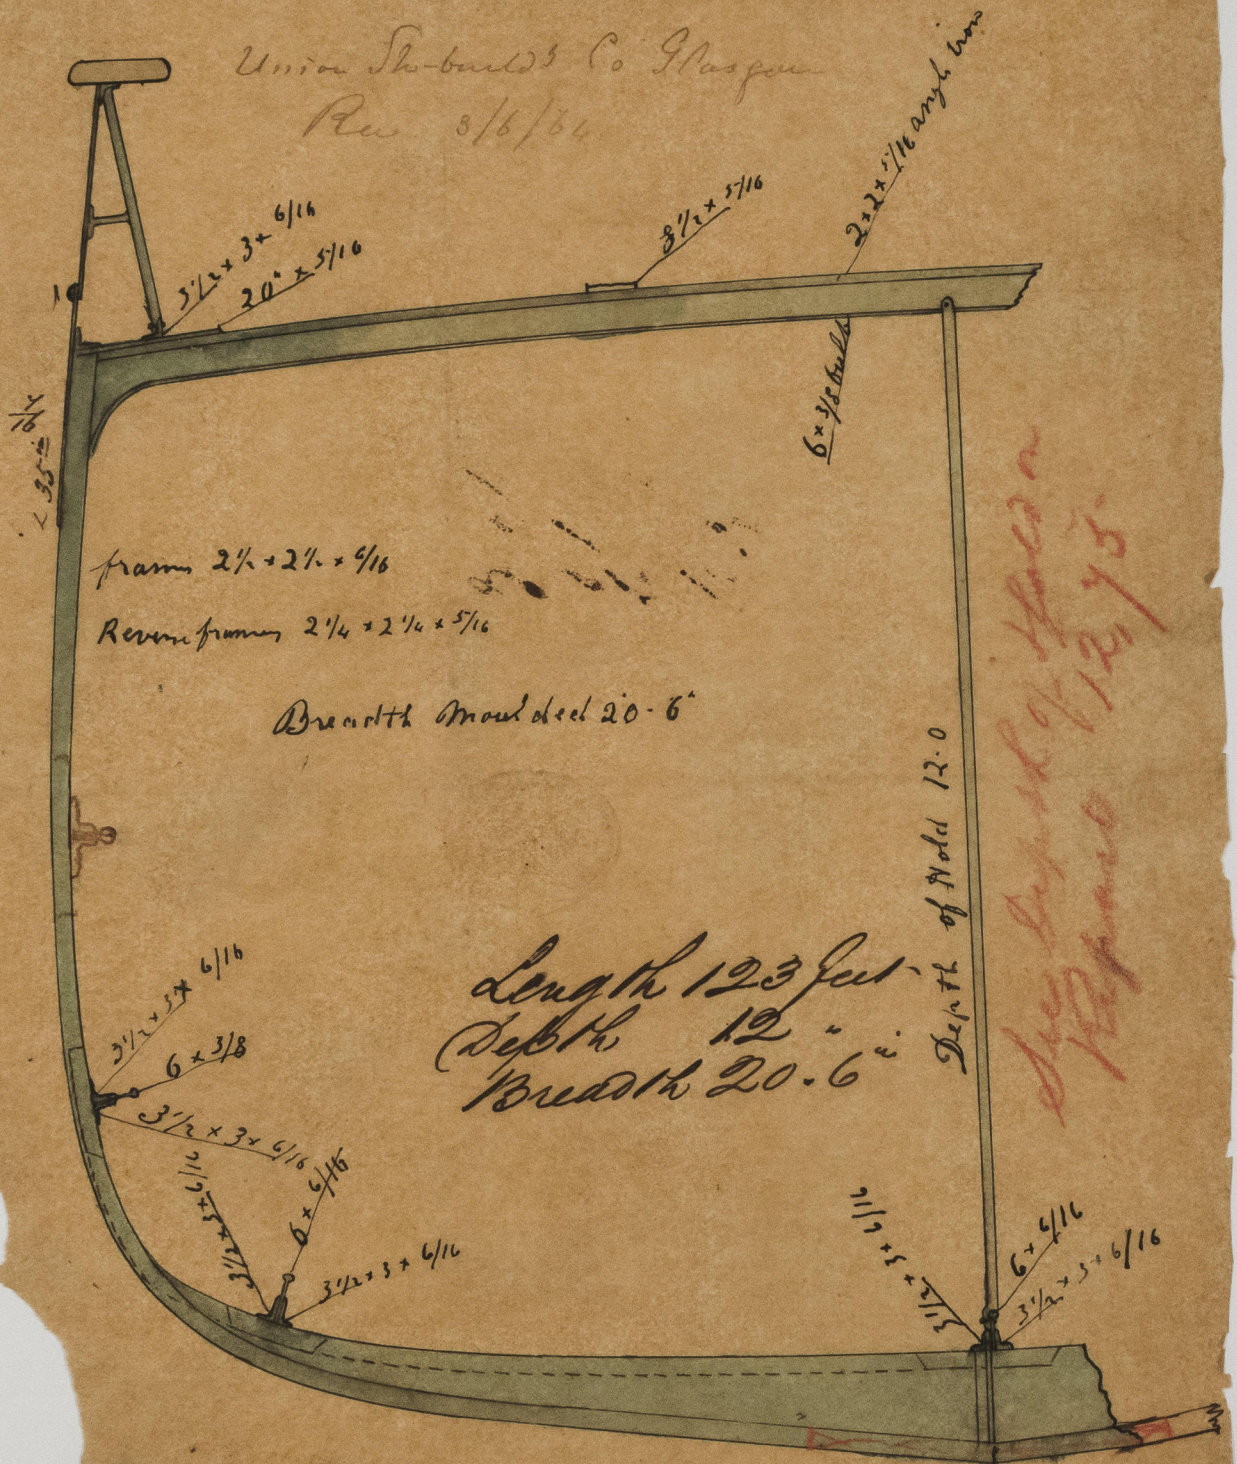

Length 123 feet  
Depth 12 "  
Breadth 20.6 "

See list of plates  
12, 75

to class S & x years tonnage 198



Lloyd's Register  
Foundation

IRON 499-0068