


100
38679m
1700-1799-1001

MIDSHIP SECTION

S. S. "Pasha"

IRON SHIPBUILDERS
GLASGOW


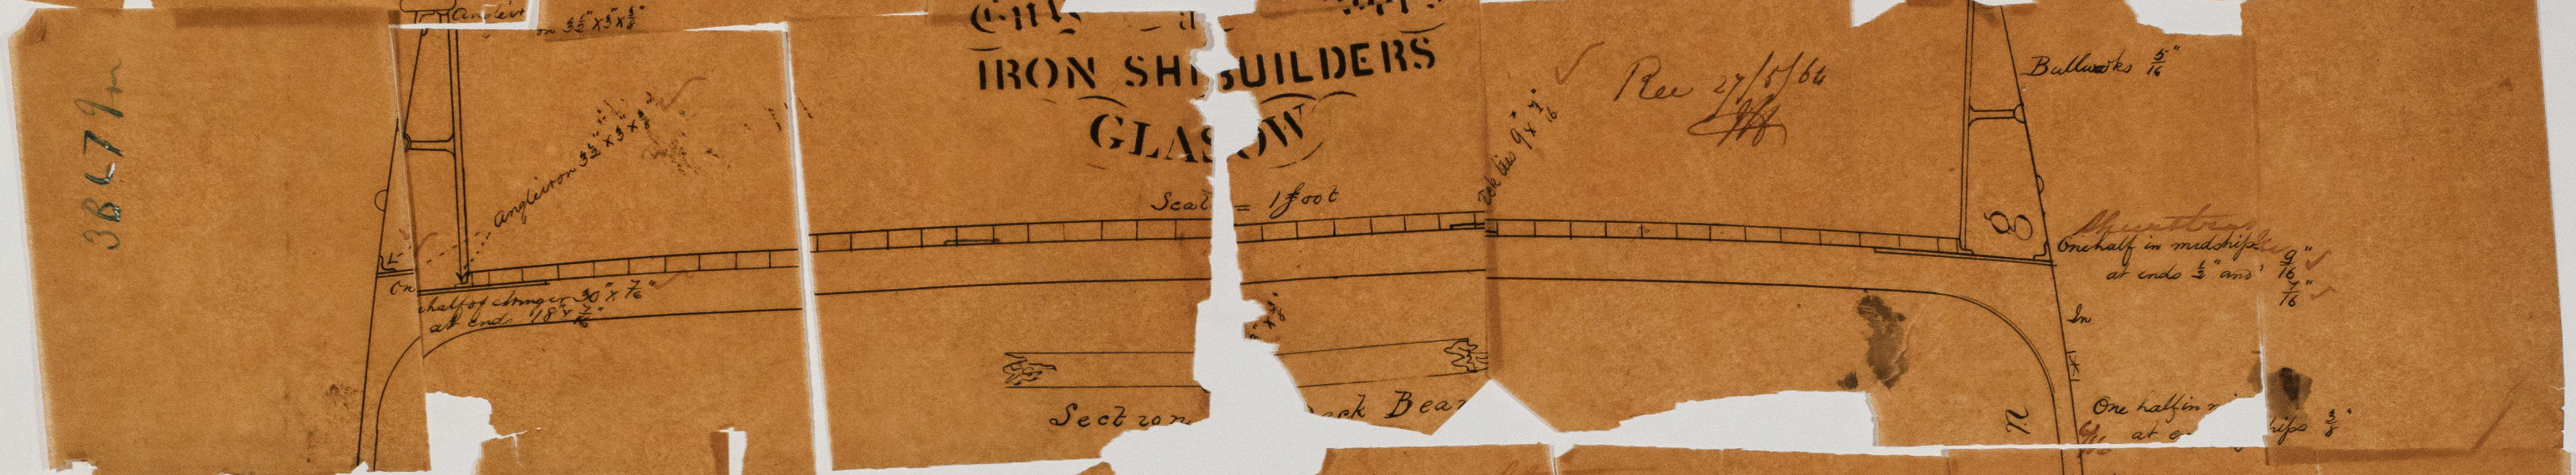


38679m





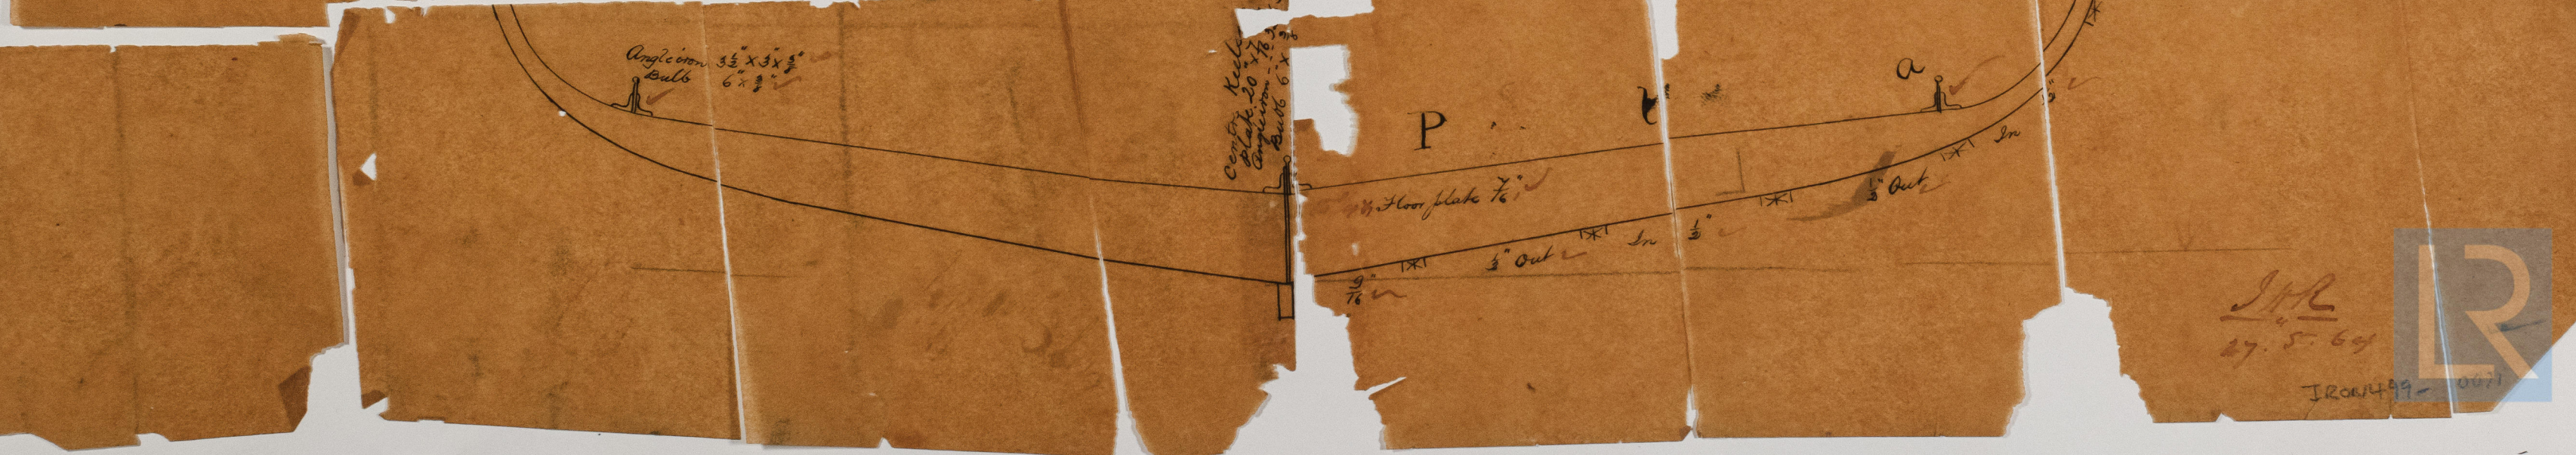

3867/1

© 2021

IRON 499 - 0071

11/11/21



Lloyd's Register
Foundation