


Midship Section  
of  
88 "Bertha"  
built by  
Thos. Wingate & Co  
Glasgow.

Scale  $\frac{1}{2}$  in = 1 foot

Rec. 26/5/73

Recd 27/5/64  
 Recd, MS

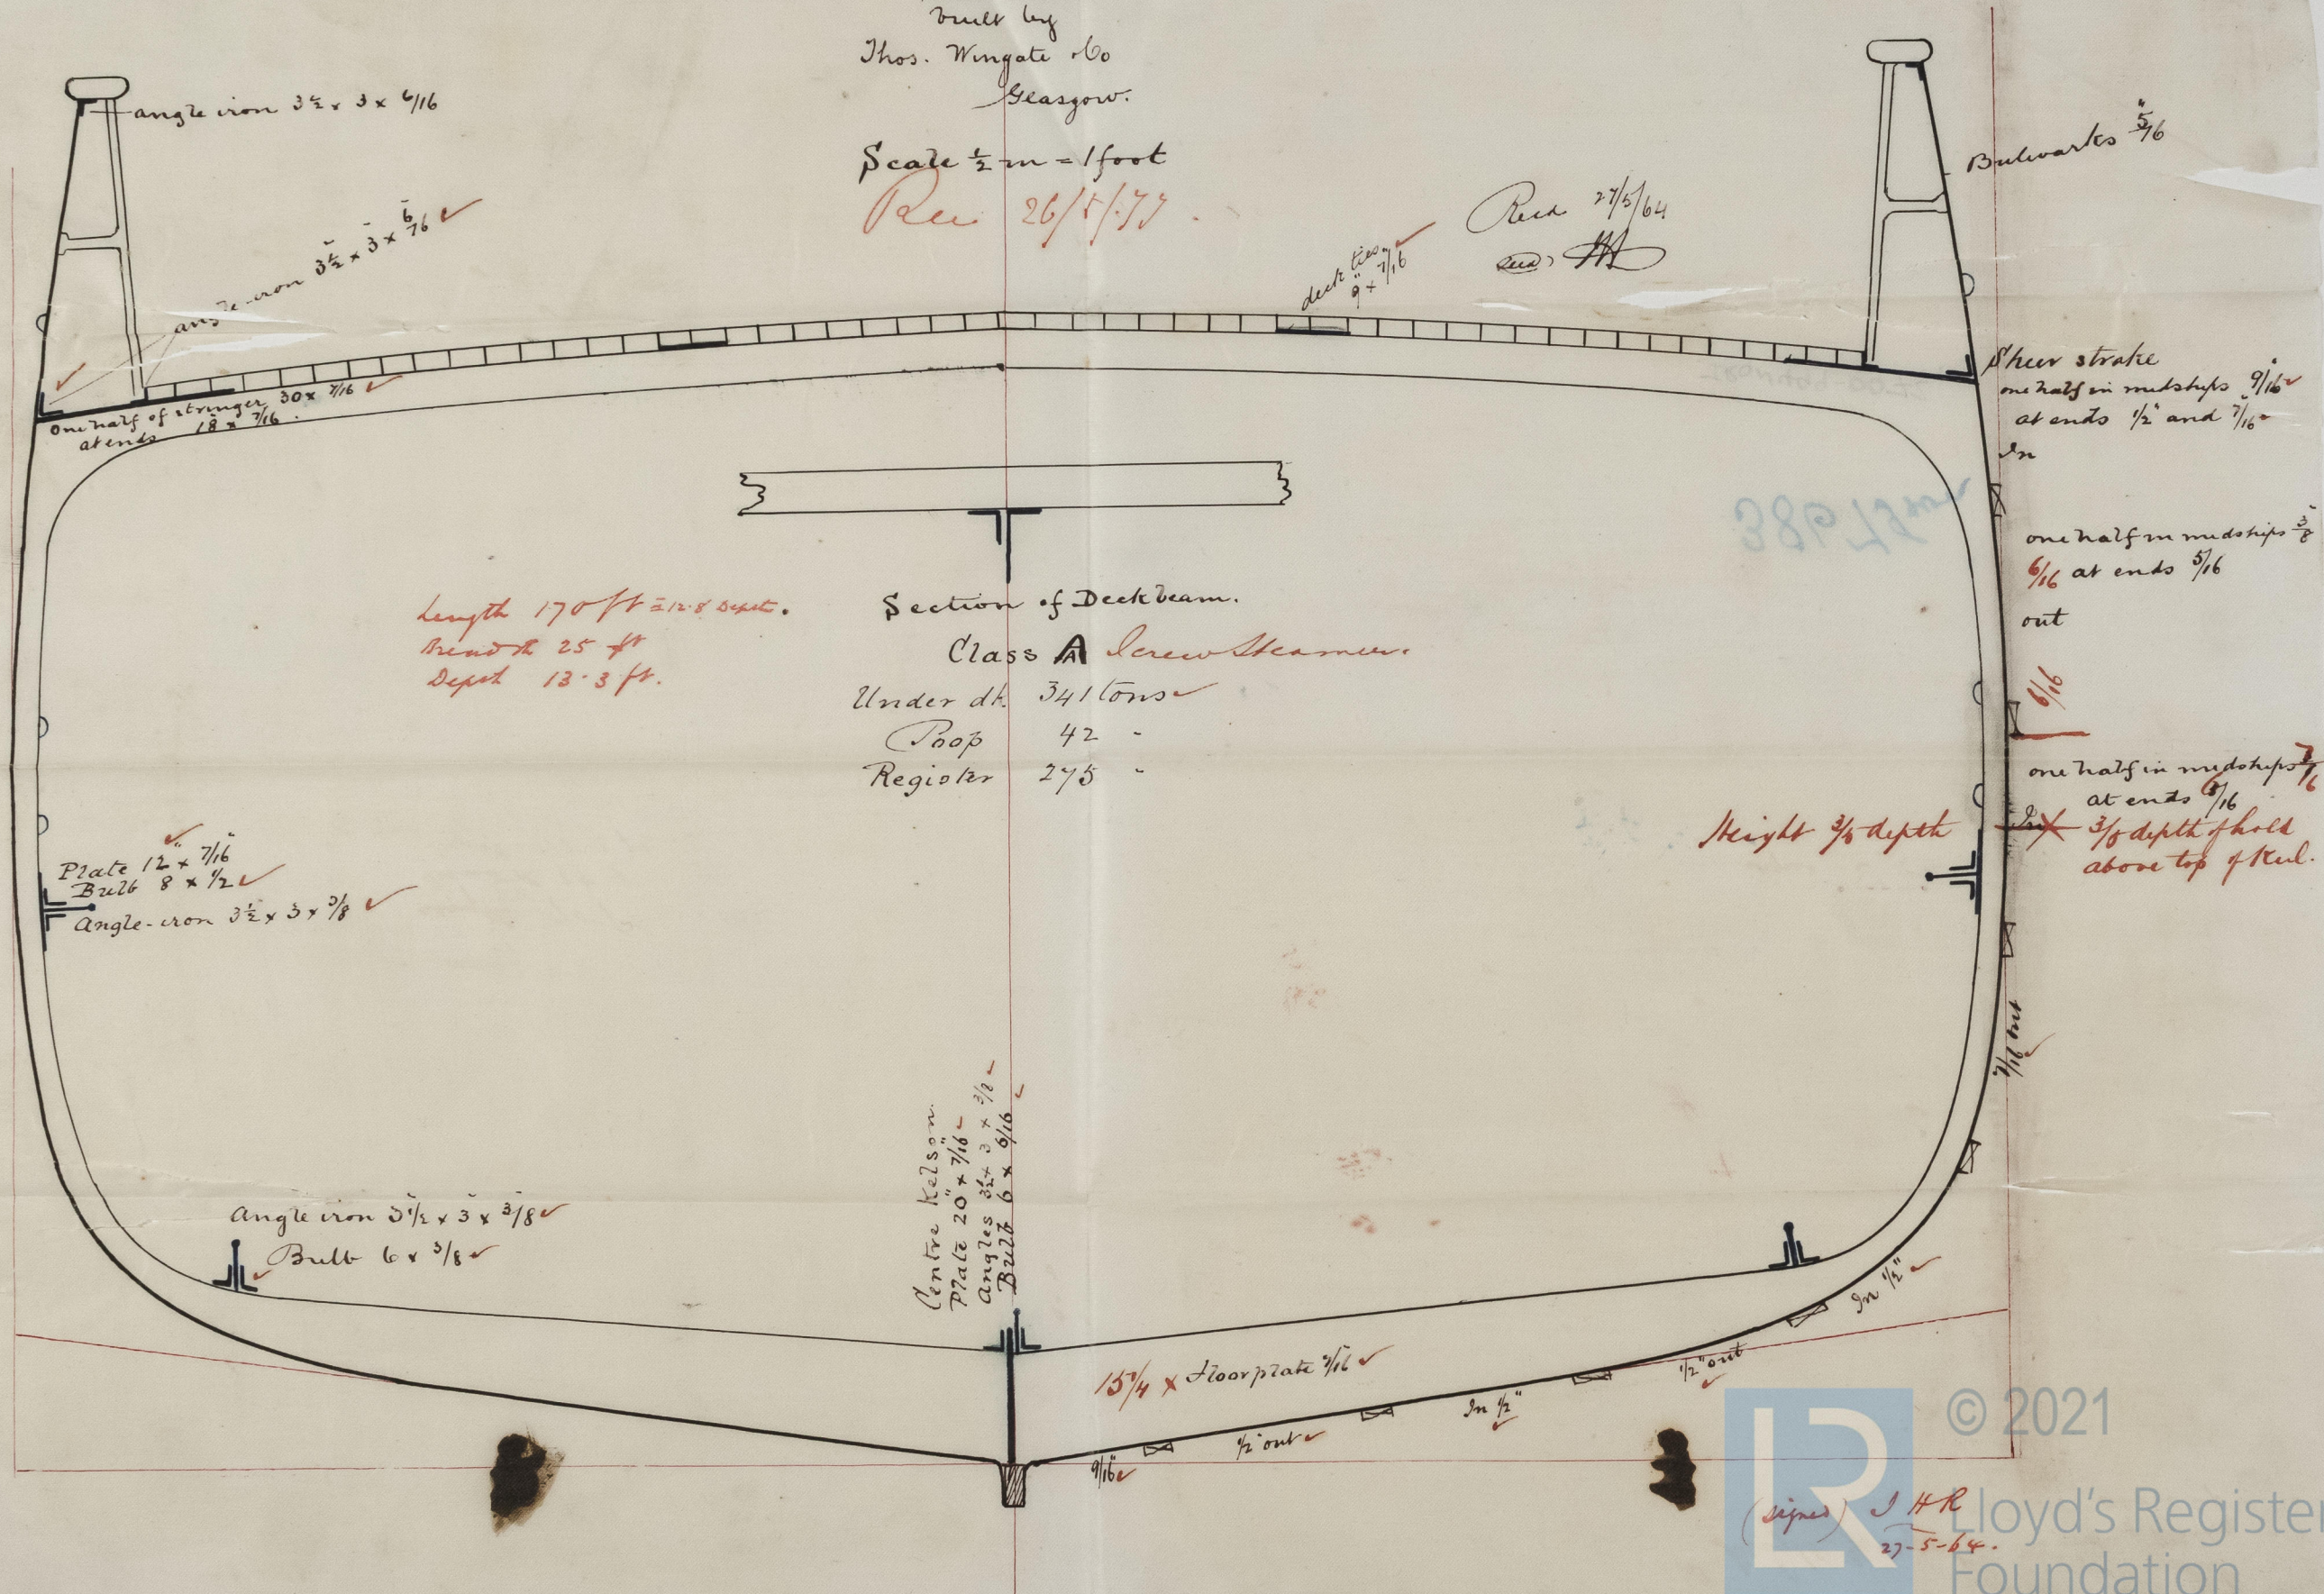

© 2021

(signed) JHR  
27-5-64.

IRON 499-0072



