No 123

391B Fron

Section thro: centre of Paddle Shaft

for A1 class

SCALE OF ½ INCH TO FOOT

	ft	ins
Length on Water line	180	0
Breadth	19	0
Depth moulded	9	9
" Hold	9	3-14-tbs

Lines to be shewn

Diagonal & Tie Rods required

60

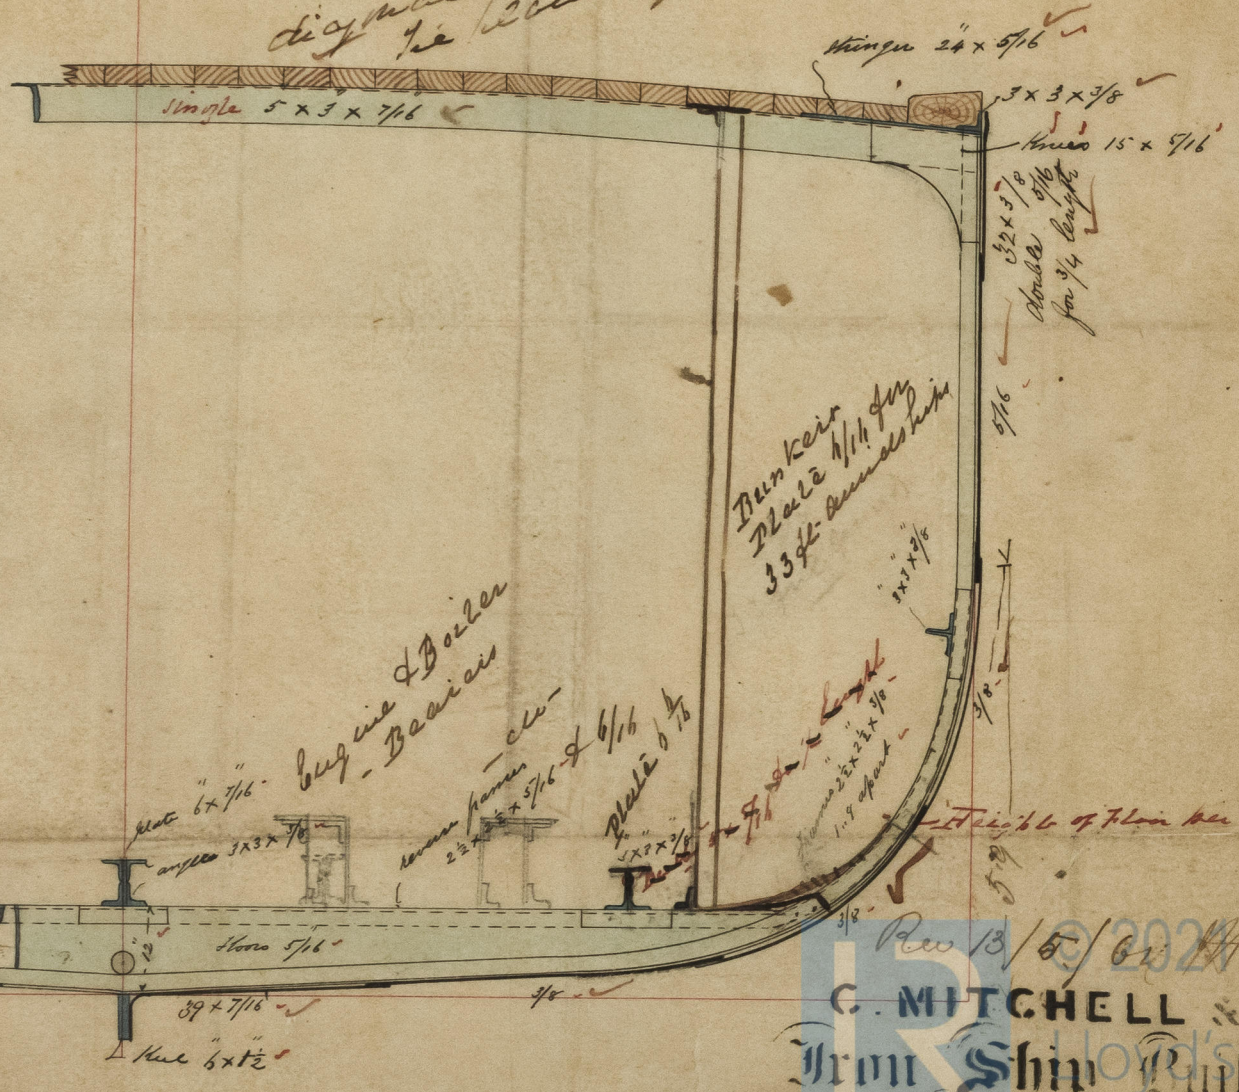

IRON499-0079

Rec 13/5/02

© 2024

C. MITCHELL & Co

Iron Ship Builders

LOW WALKER

Ormastle on Tyne

Lloyd's Register Foundation