

3969

IRON

495 tons

McLaurin's Vessel

Length 202.0


27/8/64

Breadth 25.0

29/11/64

Depth 15.0


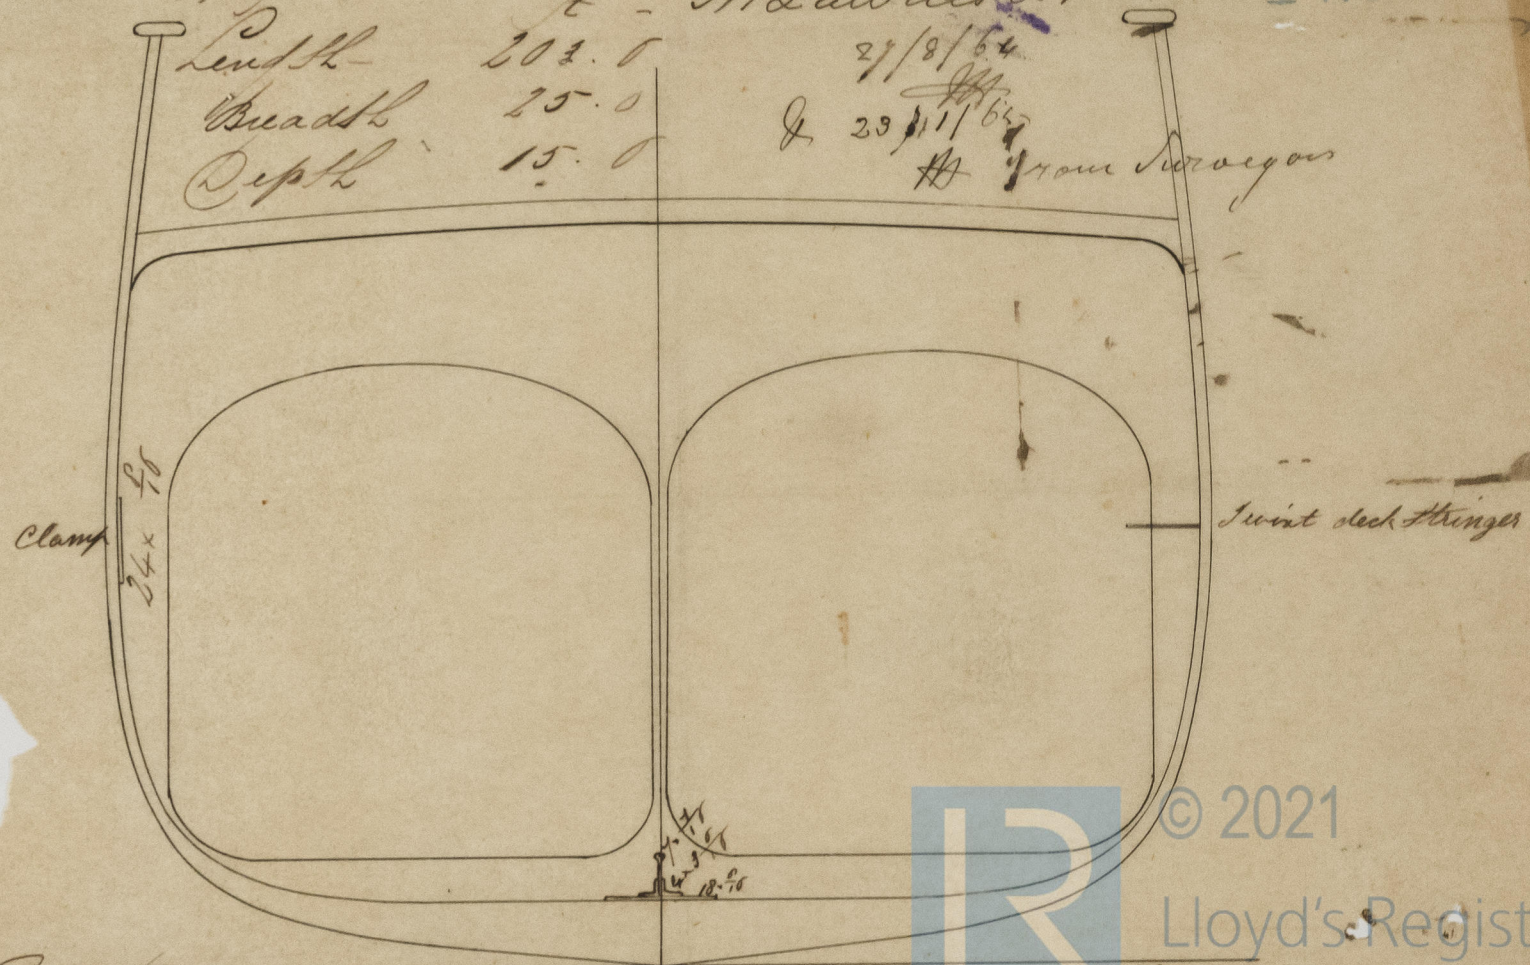

A. B. Darling

IRON 499. 0094

Foundation

29.8 tons