


MIDSHIP SECTION

OF S.S. N°129

SCALE: INCH TO A FOOT

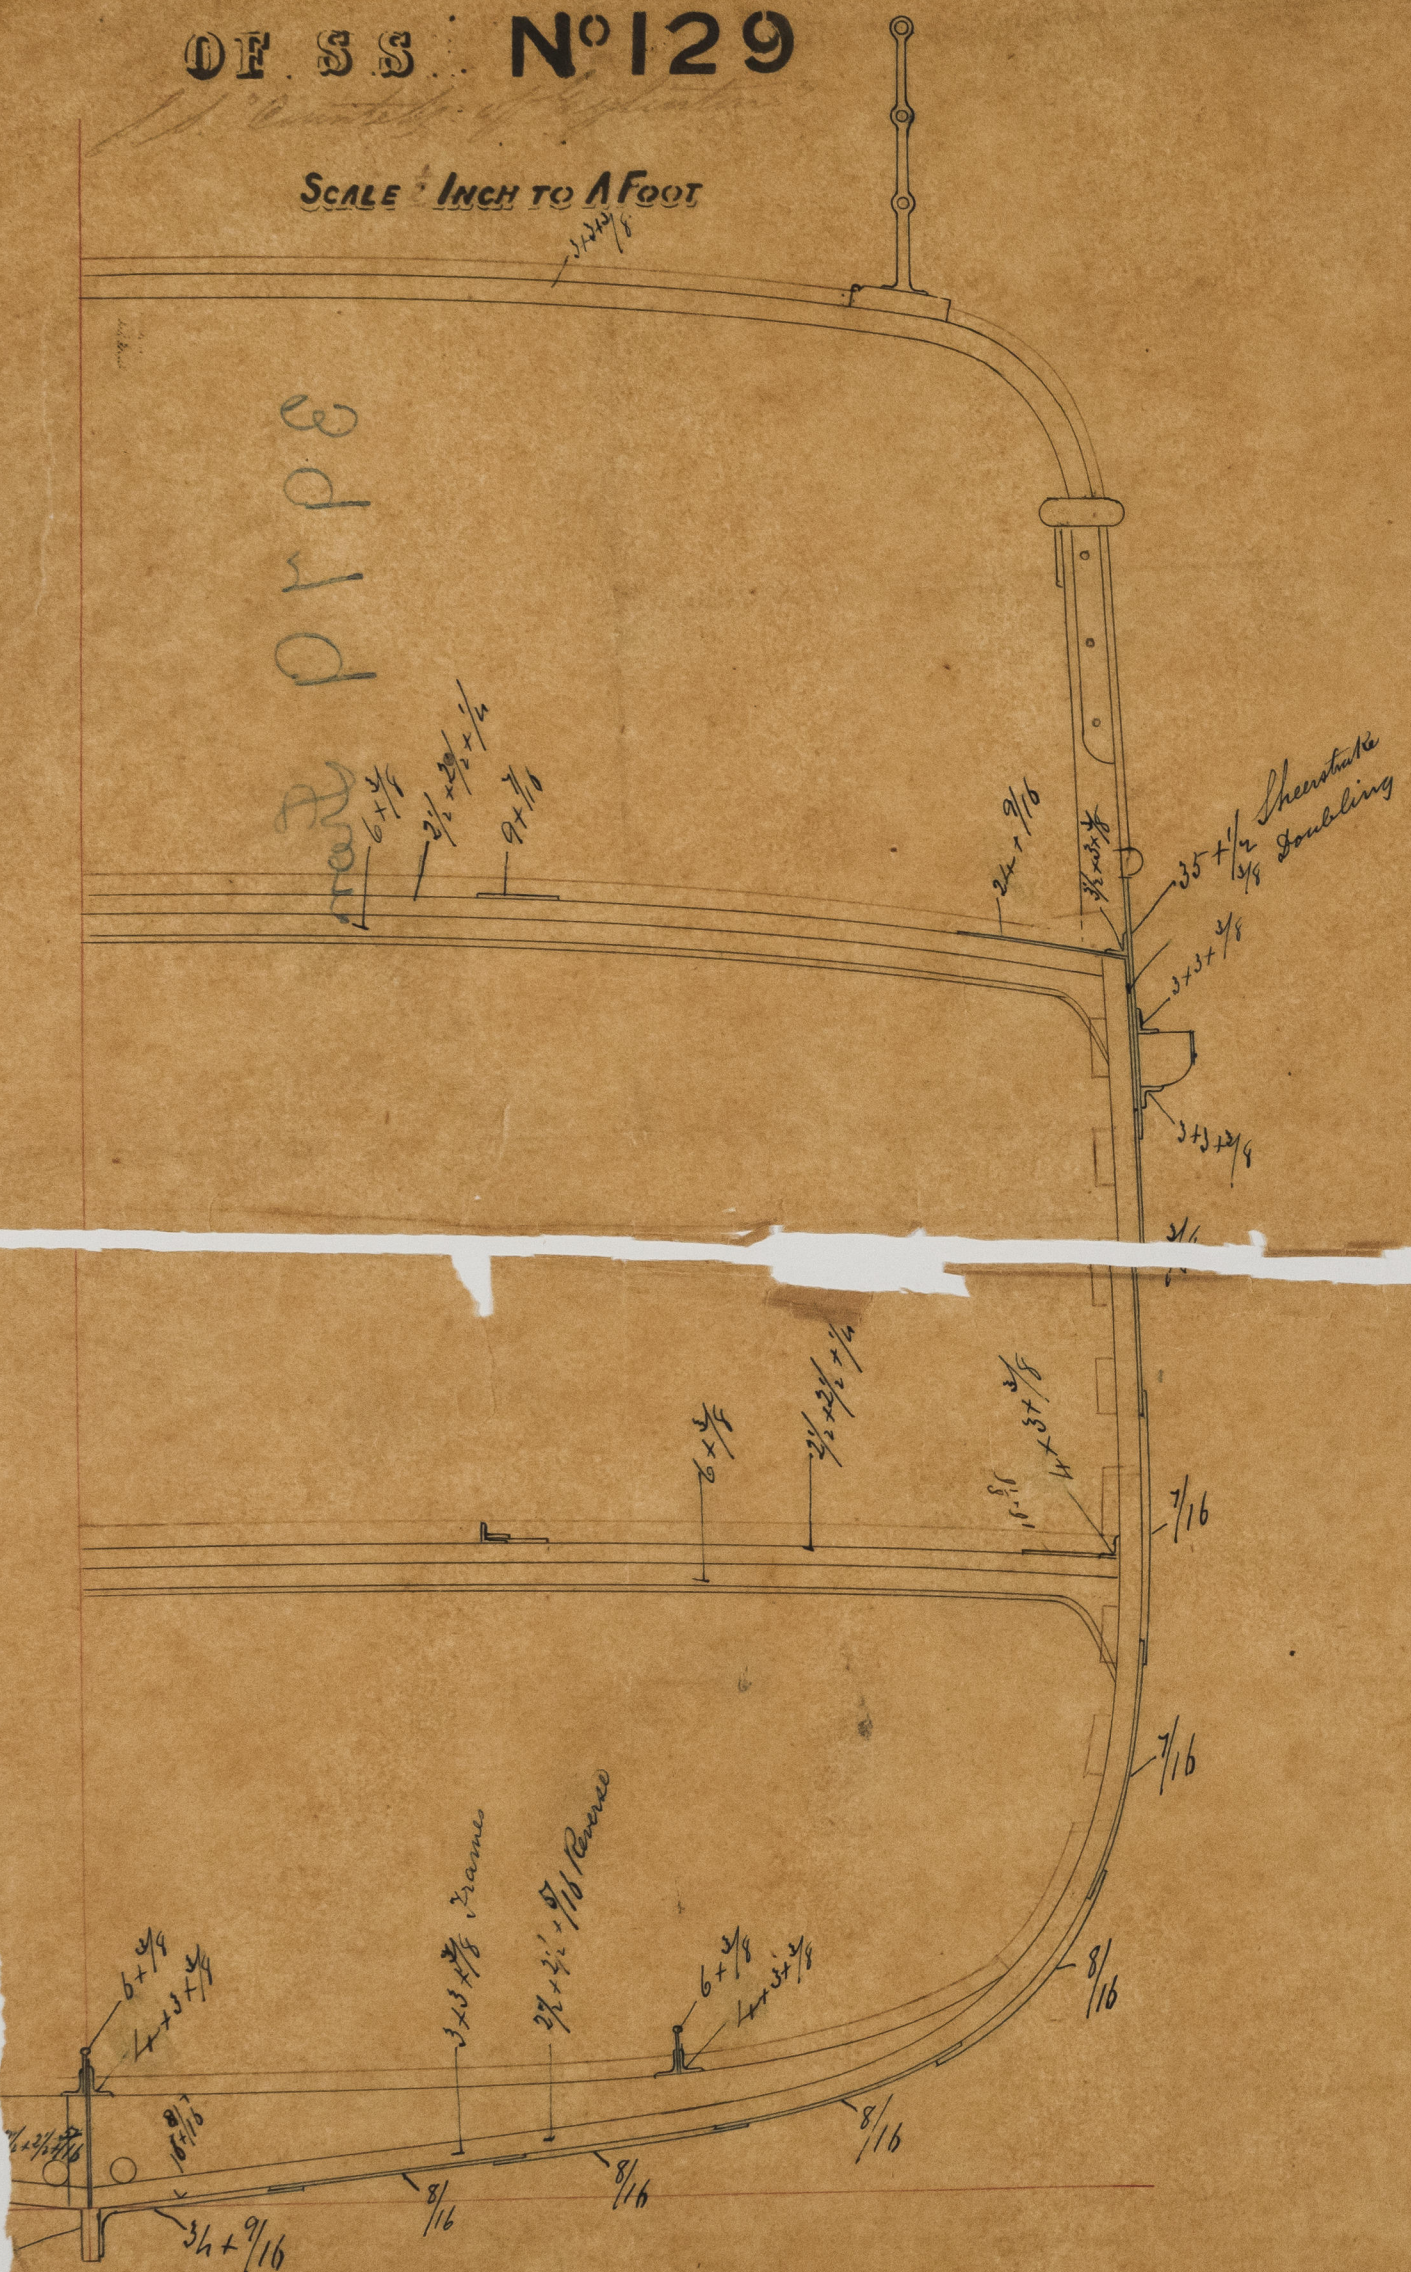

IRON 499 - 0095

Warran & Co.
Ship Builders & Engineers.

GLASGOW 17/2/65

© 2021

Lloyd's Register
Foundation

IRON 499 - 0095

[Faint, illegible handwritten text]

Quintus Curtius

Lloyd's Register
Foundation



IRON 499-0098




