


Midship Section of Barque Building by R. & J. Evans & Co.
 Ships Length 150 feet for Mr John Gambles
 Breadth 26 ft 6 in
 depth 17 ft 6 in
 524 Long
 deck inches
 Rev 27/8/64
 JH

Mr. Metcal 22nd May 1864
 Mr. L. R. Knicker 30/8/64

Keel 7.2 1/2
 Frames 3 1/2 2 1/4
 Reverse do 3.2 1/2
 Lower Beams 6 1/2 3/4
 Upper do 6 1/2 3/4
 Floor plates 18 3/4 Carried up 3 1/2 in
 Nelson plates 14 3/4 double
 Top plate 10 3/4
 Main Deck Stringer 18 3/4
 Lower do 18 3/4
 Vertical do 16 3/4 over hold beam
 Tie plates 10 3/4 1/2 to Beam 3 in

Planks 4.4 3/4
 do for upper beams 3.2 1/2 3/4
 do for lower beams 2 1/2 3/4
 Plates
 Garboard 1 1/2
 to Bilge 9/16
 Bilge Strake 10/16
 2 Strakes above do 9/16
 Thence to Main Strake 7/16
 Main Strake 10/16
 Bulwarks 5/16
 Built iron between bilge keelsons 6 in by 7/16

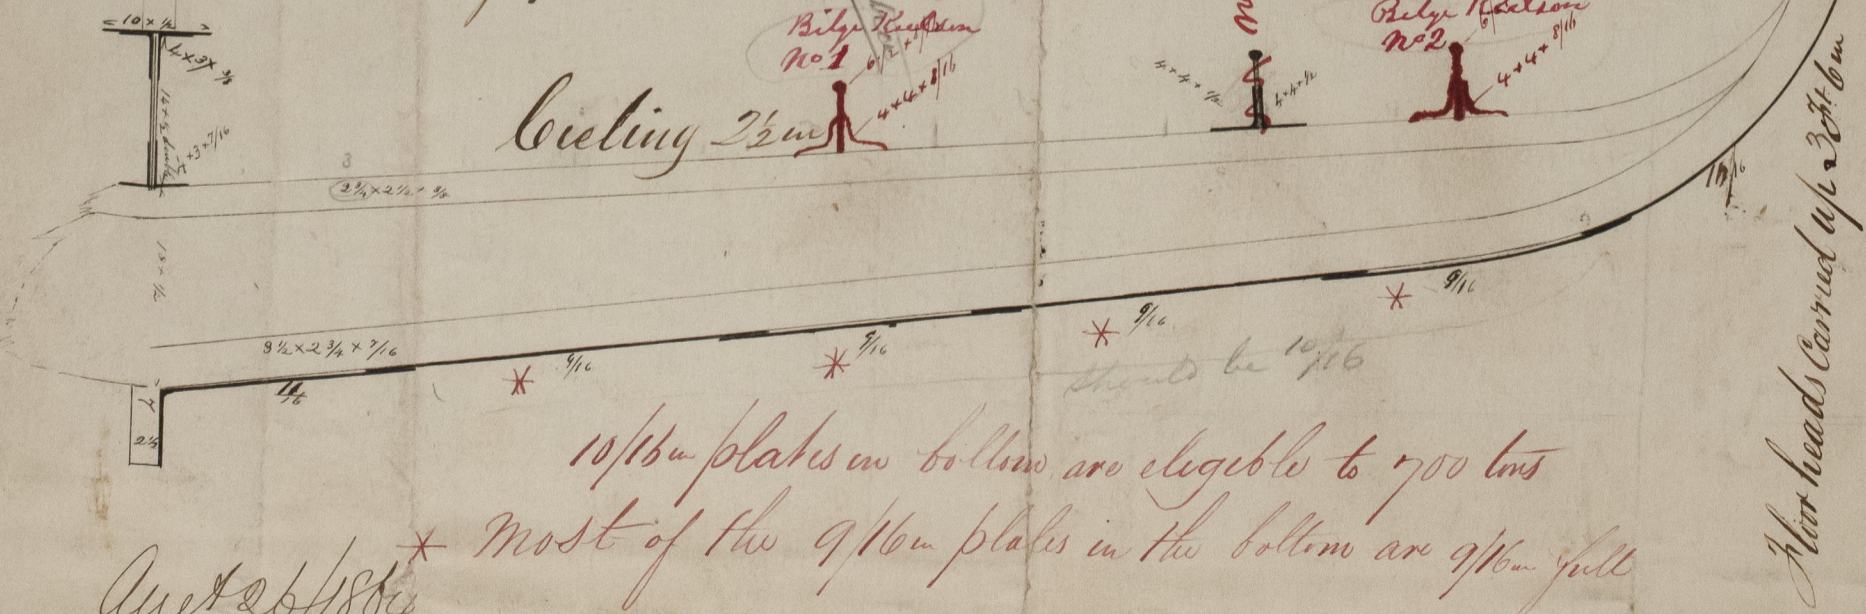

Coasting 2 1/2 in

10/16 plates in bottom are eligible to 700 tons
 Most of the 9/16 plates in the bottom are 9/16 full

Aug 26/1864
 JH

Scale 3/4 of an inch to a foot

IRON 499. 0108

4010 Lm



© 2021

Lloyd's Register
Foundation

IRON499-0108