


Scantling entered on  
this section from 1st entry report  
by D.S. when copy was made  
for owner 11/6/85

ROBERT DUNCAN & CO  
Ship Builders & Co  
PORT GLASGOW

March 1885

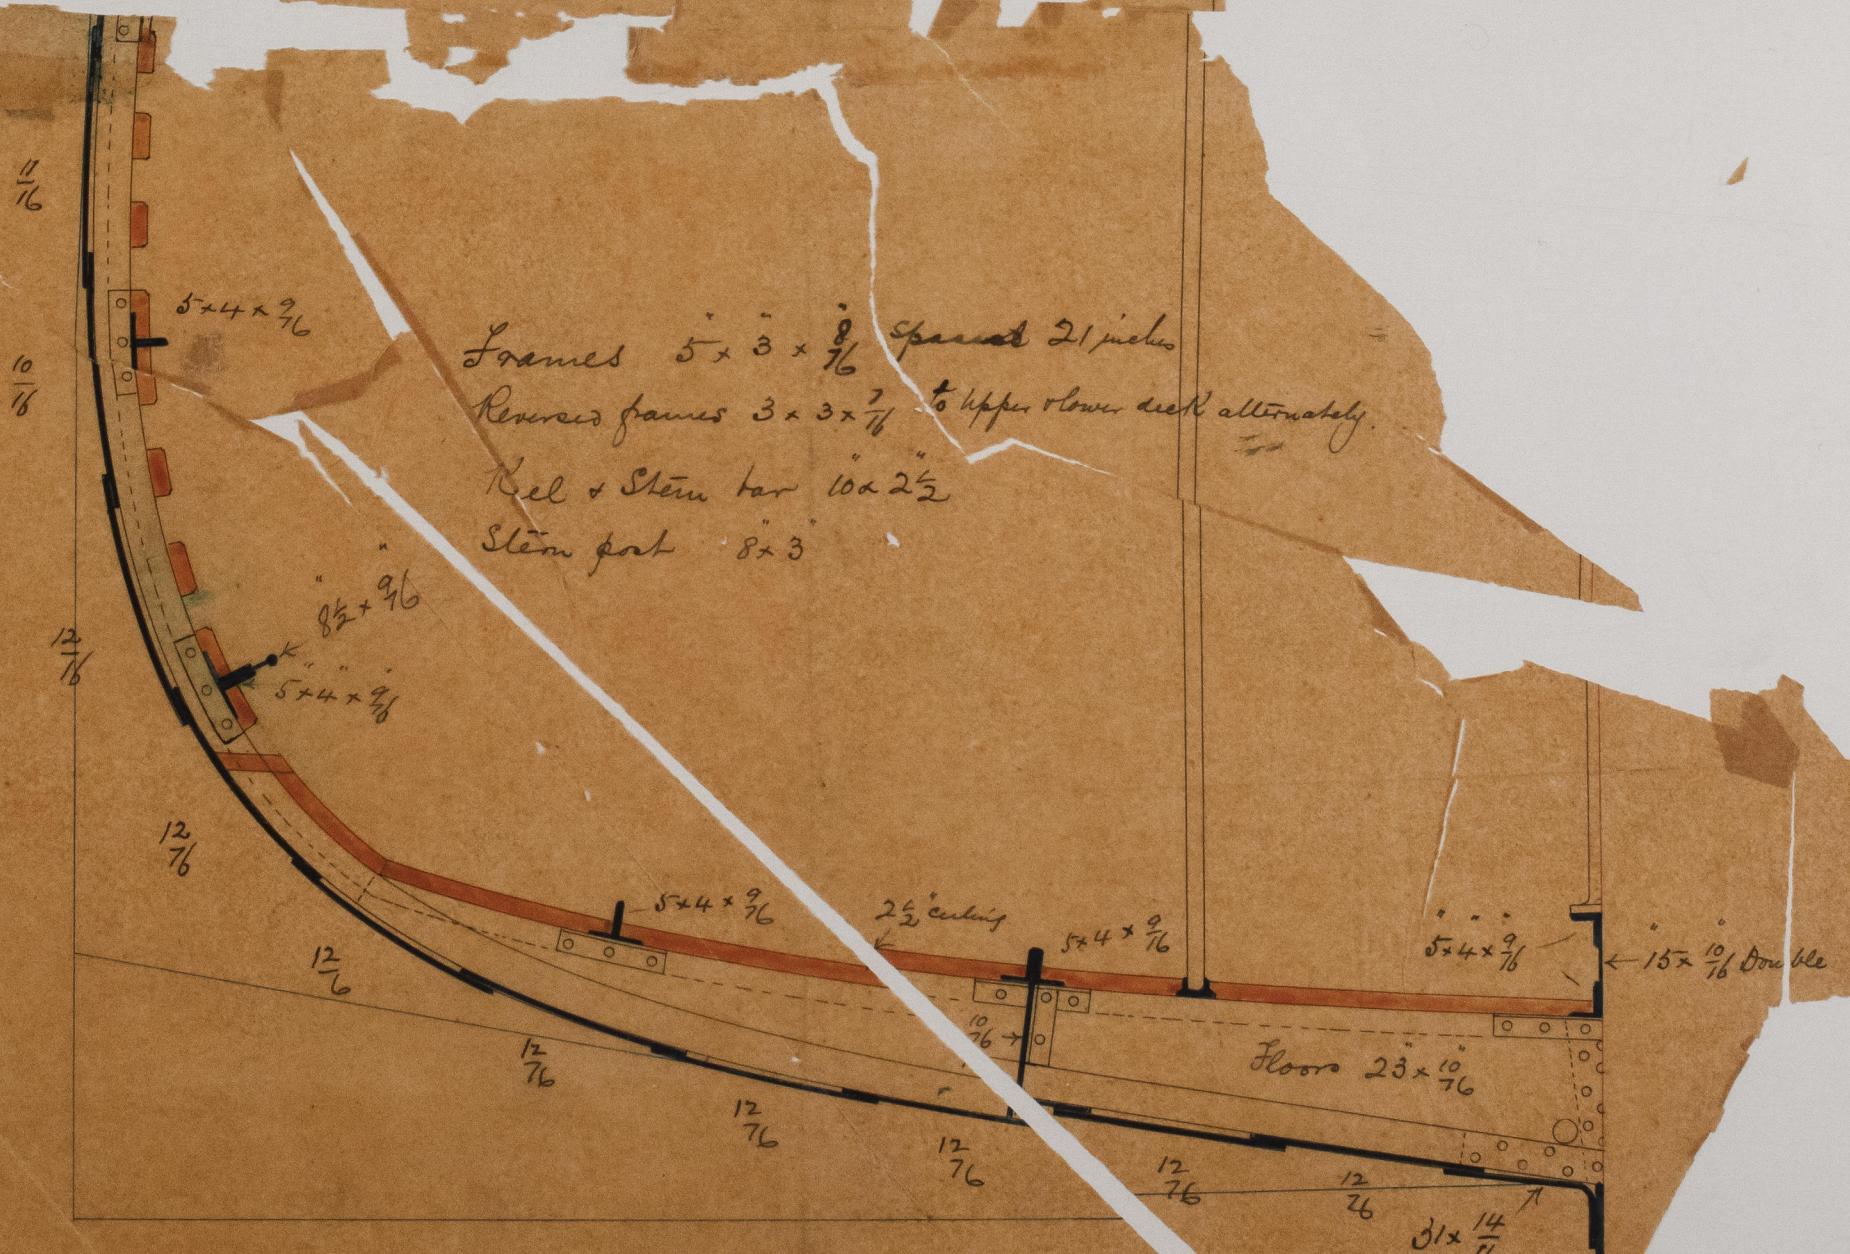

© 2021

Lloyd's Register  
Foundation

IRON 499-0127