
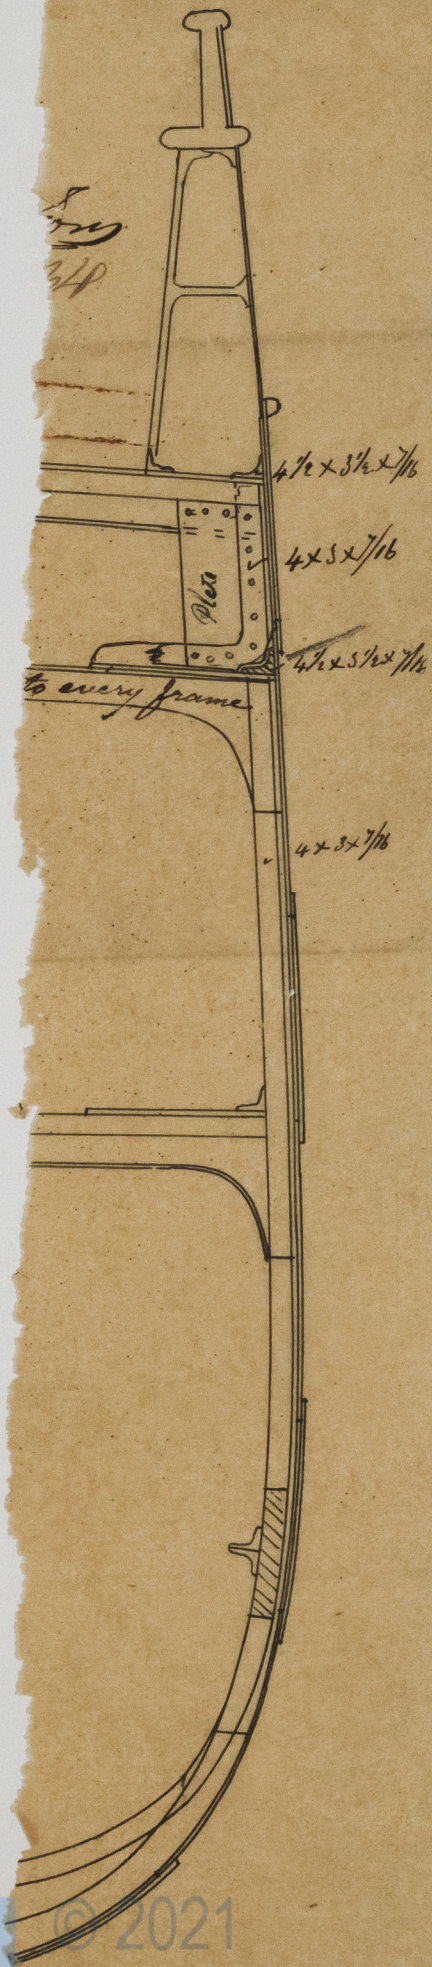


Section in way of Water Tank
 to be built under S.P. and Clared A.
 Room & space 20 Ins. Estimated Sormage
 Request for Special Survey No. 119. - 28th 8

Rev 23/6/64

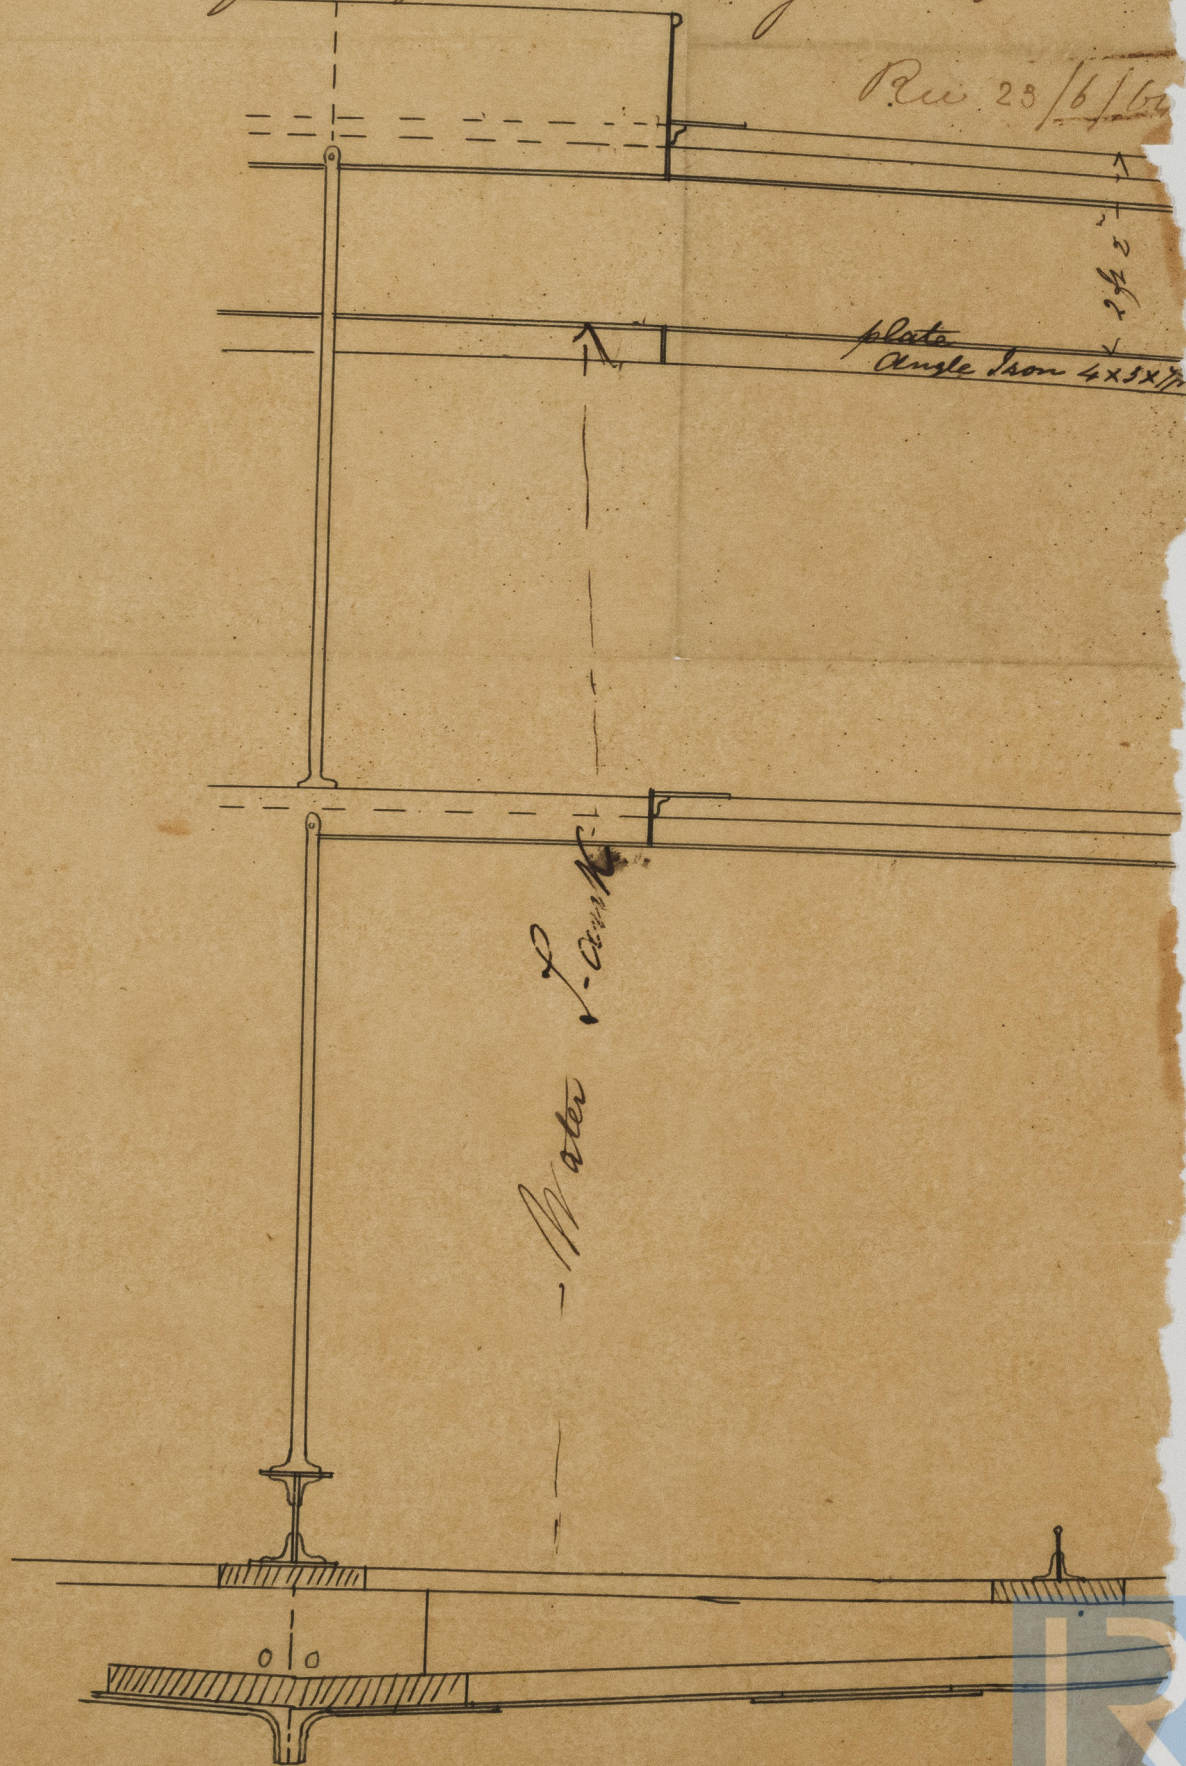

IRON 499. 0160 1/2