


Length 129 ft
 Breadth 17.3
 Depth 9.4
 Under 200 tons
 B class

Scale $\frac{1}{2}$ inch = 1 foot
 Rec. from M. J. G. Lawrie
 31/5/65

4222 Dr

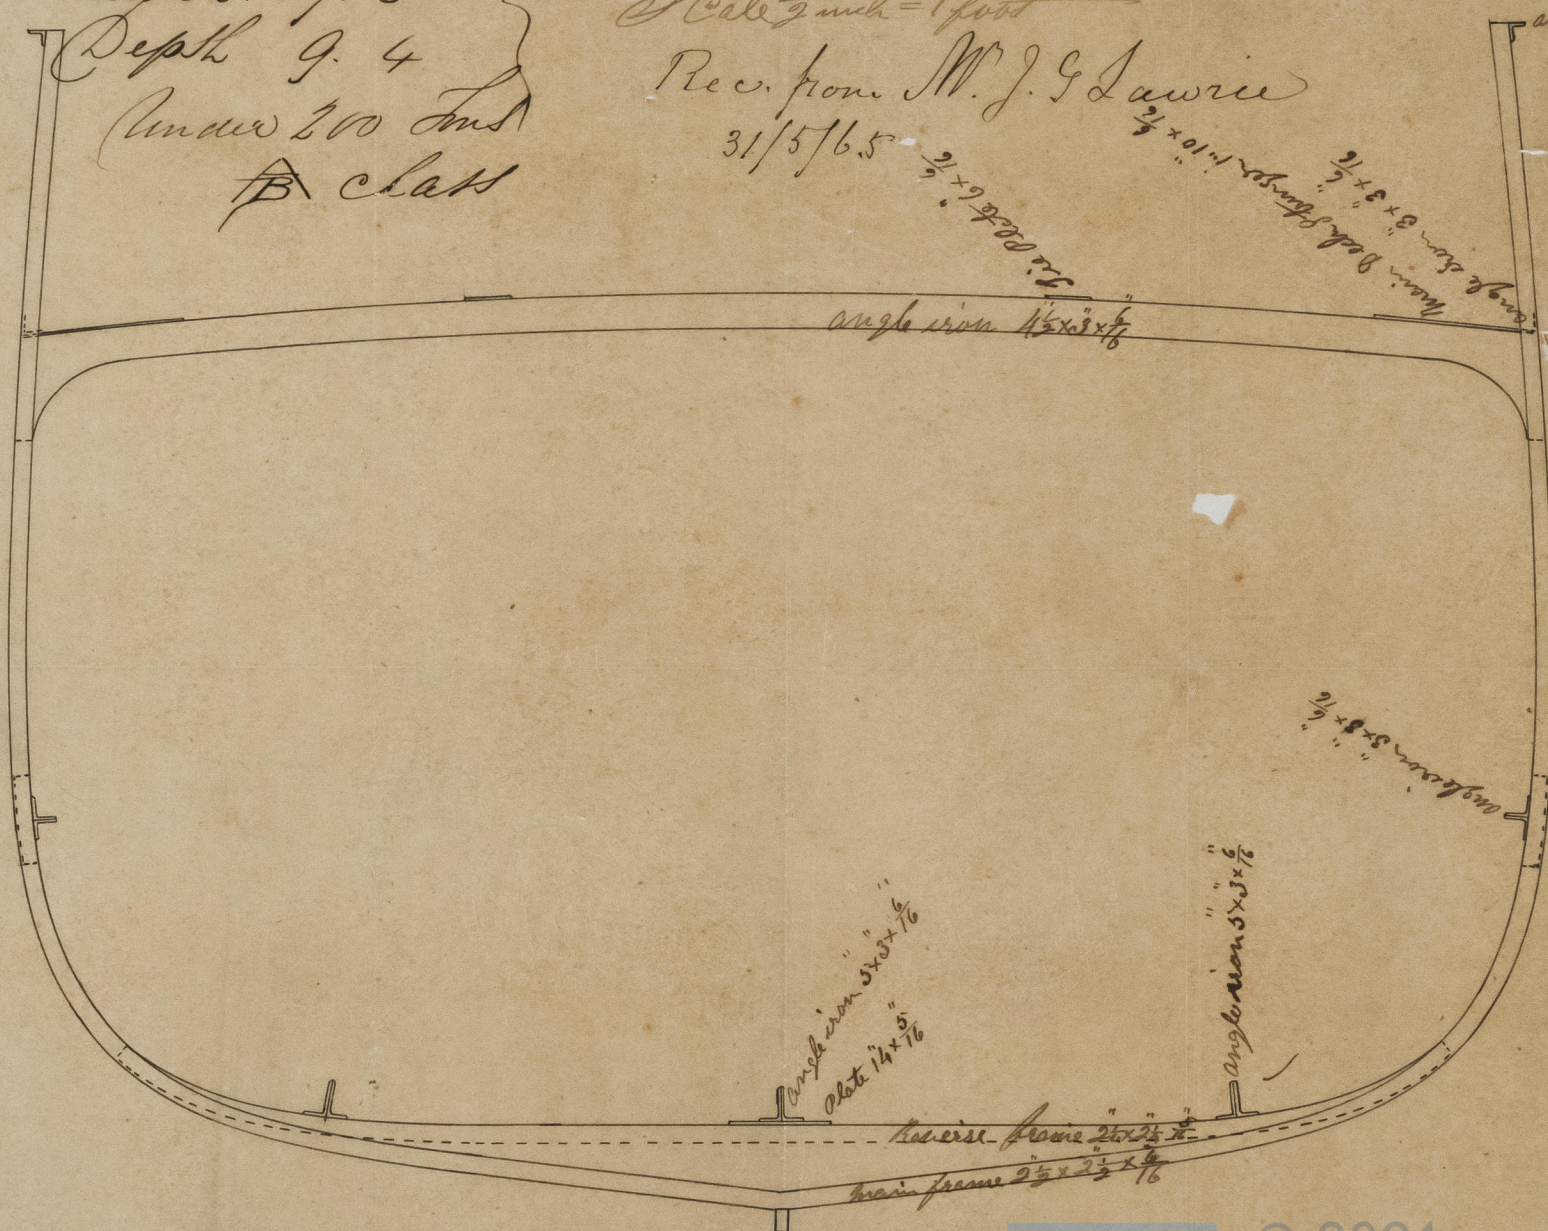

© 2021

Lloyd's Register
 Foundation

IRON 499-0187

NOTE
 26 65