


(No 2)

Old Man Shipbuilding Co Limited
1 Ramsey 12th April 1855

Section through Engine Room
of No 11

See Mr Light's L^o 17th April 1855 (L^o M^o M^o)
Rev 17/4/65
HA

Scale 1/2 inch = 1 foot

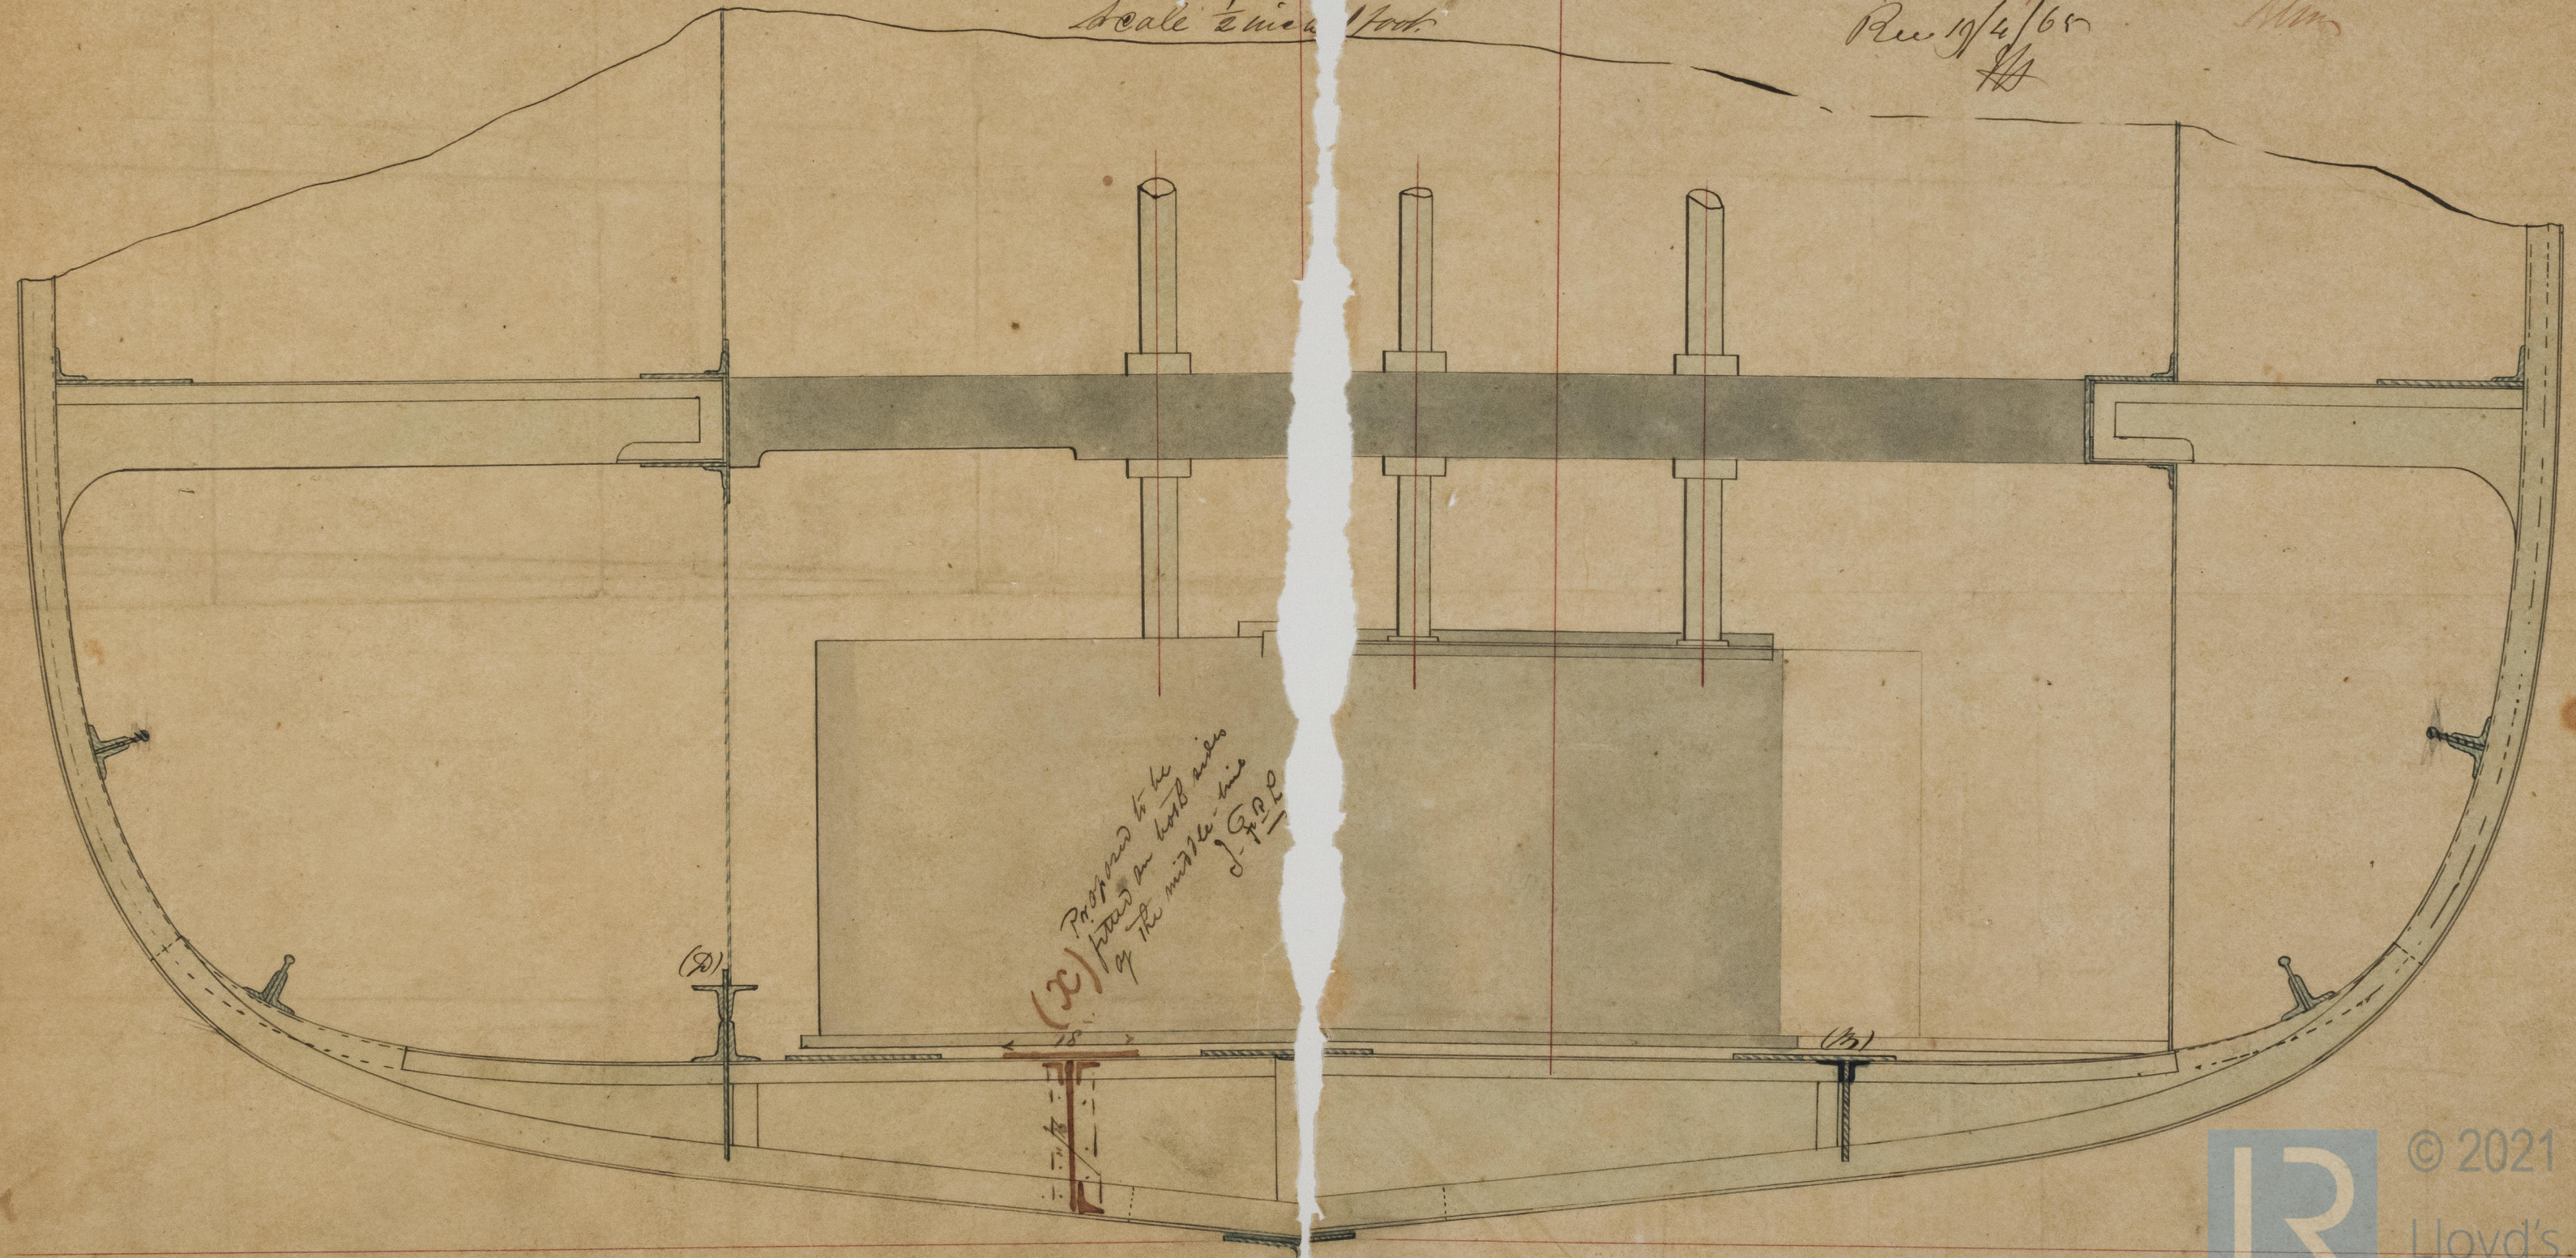

Proposed to be
fitted on both sides
of the middle line
J. G. P.
(x)

IRON 499-0218 1/2