Midships Section of No. 4 S.S. (A.A. order No. 460)

Scale ½ inch = 1 foot.

March 9th 1865

for A & B. class.

double gutter plate 14 × 7/16
Stringer plate — 28½ × 10/16
reduced at ends to — 21¼ × 8/16
Angle iron — 4½ × 3½ × 7/16

Tie plate 12" × 7/16

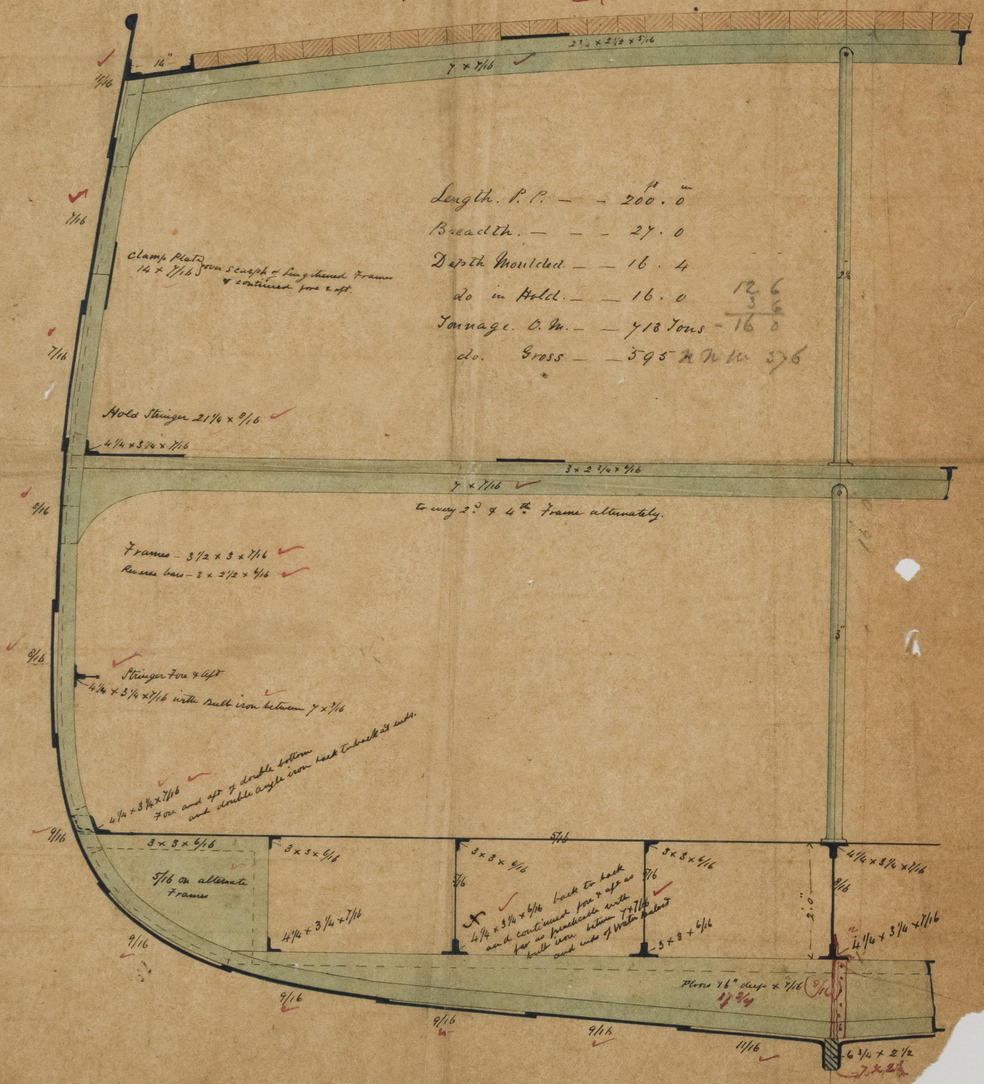

Length. P. P. — — 200. 0 ft in
Breadth. — — — 27. 0
Depth Moulded. — — 16. 4
do in Hold. — — 16. 0
Tonnage. O. M. — — 718 Tons

12.6
3.6
16.0

IRON499-0240½

2.

Arrangement & Scarph of Frames.

Scale ½ inch = 1 foot.

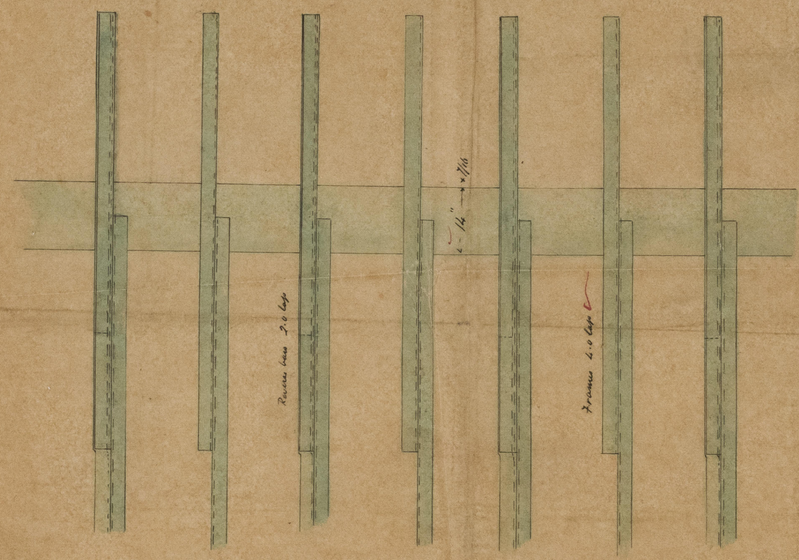

Section at top of all Frames

Scale 3 inch = 1 foot.

Rec 13/8/65

Bain bridge Davy & Hopper
Millington Quay.
near Newcastle on Tyne.

© 2021
Lloyd's Register Foundation

IRON499-0240 2/2