

Iron Ship Yard  
DIBLESBRO'

Rec 7/9/65

Order No 284

Mr. Cudlish to Ray

S.S. 'DAVID' with Report No. 2490

August 25<sup>th</sup> 1865

Letter to the Surveyors Messrs Hartlepool

# SECTION OF BALLAST BOTTOM N<sup>o</sup> 11

for 600 Tons grade

we. 11 depths the sheers takes to  
be increased  $2/16$  for three months  
the length of ship — 1.5.

Scale  $1/2$  Inch = 1 Foot

Principal Dimensions

Length between Pts

Breadth of Beam

Depth from top of floors to top of main deck beams

ft in

193 ft 9 in


28 6

16 8 1/2

Double Bottom 63 feet long aft of Engine Room 3/4 1.5.

frames 21 in apart.

Engine Room 3/4 1.5.

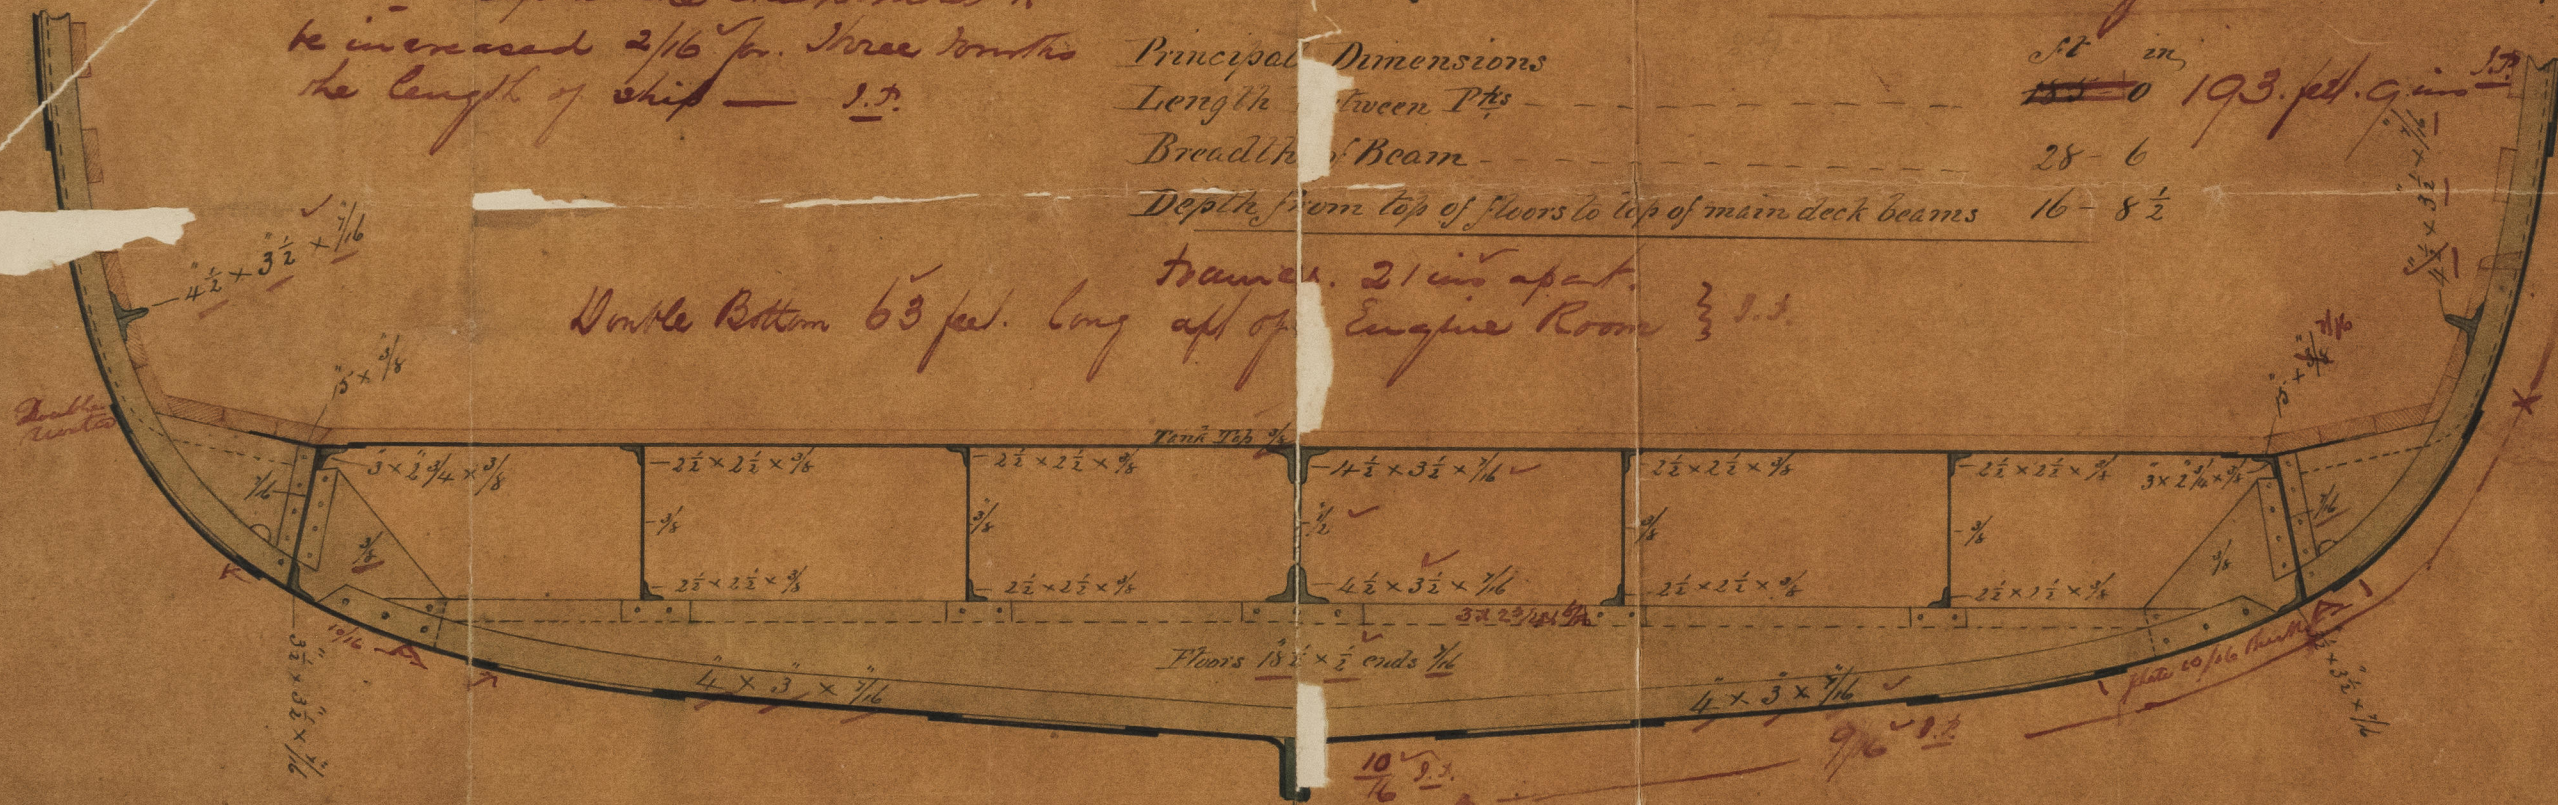

Middle Line Keelson. Same as Section in space for Double Bottom  
forward of this. 10 per rule 12 x 10 1/4 3/4 1.5.



© 2021

Lloyd's Register  
Foundation



4554 Iron.



© 2021

Lloyd's Register

Foundation

IRON 499-0273