



SCALE OF 1 INCH TO FOOT

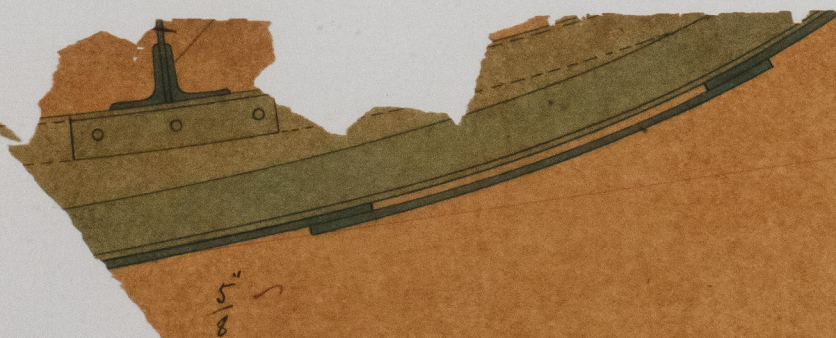

Rev 16/11/60  
C MITCHELL & CO  
Iron Ship Builders  
LOW WALKER  
Newcastle on Tyne

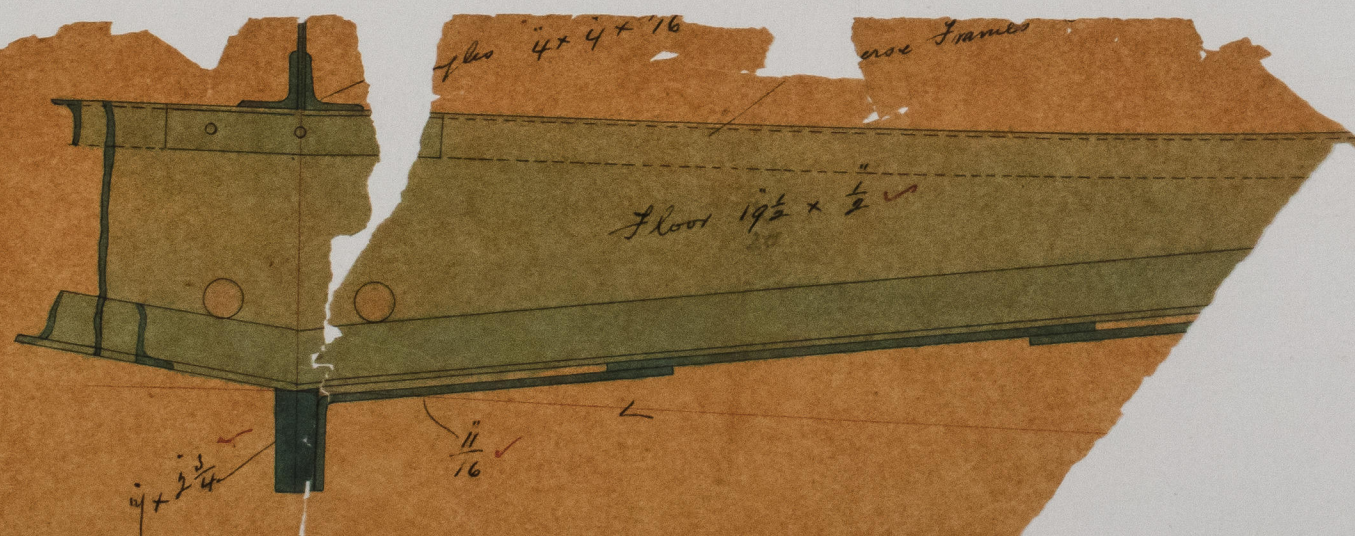

© 2021

Lloyd's Register  
Foundation