


4751 Iron

12/65 { Copies from request for
revision { Survey No 376
under 200 Tons 129 x 21.6 x 10.11 "

LAURENCE HILL & CO
Engineers & Ship Builders
PORT GLASGOW

Recd 9/12/65
HA

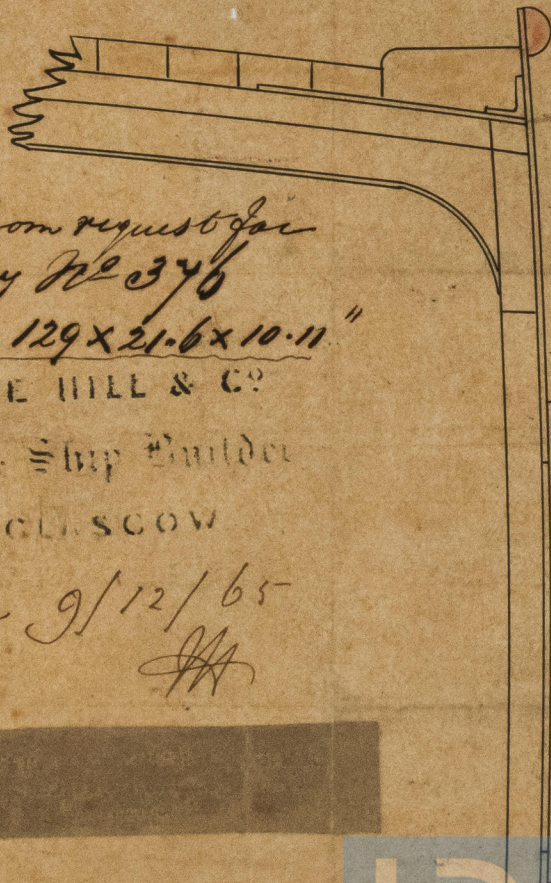

Spaced the paper
2 ft. 9

4 1/8 - then the S.

Then the 7/16
3/4 the length

4 ft. 9 -
7/16
3/4 the length
4 1/8 - then the S.
2 ft. 9

© 2021

Lloyd's Register
Foundation

IRON 500-0001

124




WOOD LITHO

Dec 21/67

It is recommended that in future all drawings submitted for approval to Lloyd's Committee be made on tracing Cloth, to secure their preservation.

© 2021